


30.11.81

S.S. Aberdeen. Aberdeen report N° 3452

S. S. N° 229

SCALE $\frac{1}{4}$ INCH TO ONE FOOT

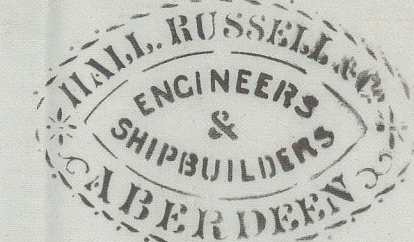

ALTERATIONS IN RED

WHEEL HOUSE

CREW

OFFICERS

CABIN

Shed beam
on this beam
plated over

HAND PUMP

HAND PUMP

HAND PUMP

HAND PUMP

SLUIVE

SLUIVE ON EACH SIDE

SLUIVE ON EACH SIDE

SLUIVE ON EACH SIDE

SLUIVE COCK

SLUIVE COCK

SLUIVE COCK

7/1/82