

MIDSHIP SECTION


S S N^o 238

S.S. Glencairn
No. of Report
3570

LENGTH TWIXT PERPENDICULARS 130.0 LENGTH PER RULE 128.5
BREADTH MOULDED 23.0 BREADTH 00 00 23.0
DEPTH IN HOLD 11.0 DEPTH 00 00 12.25
BREADTHS IN LENGTH 5.5 DEPTHS IN LENGTH 10.5
NUMBERS FOR SCANTLING & EQUIPMENT 11.5+12.25+19.5-43.25x128.5=5557.625

100 A. GRADE

Lt. to Mrn
1/7/84

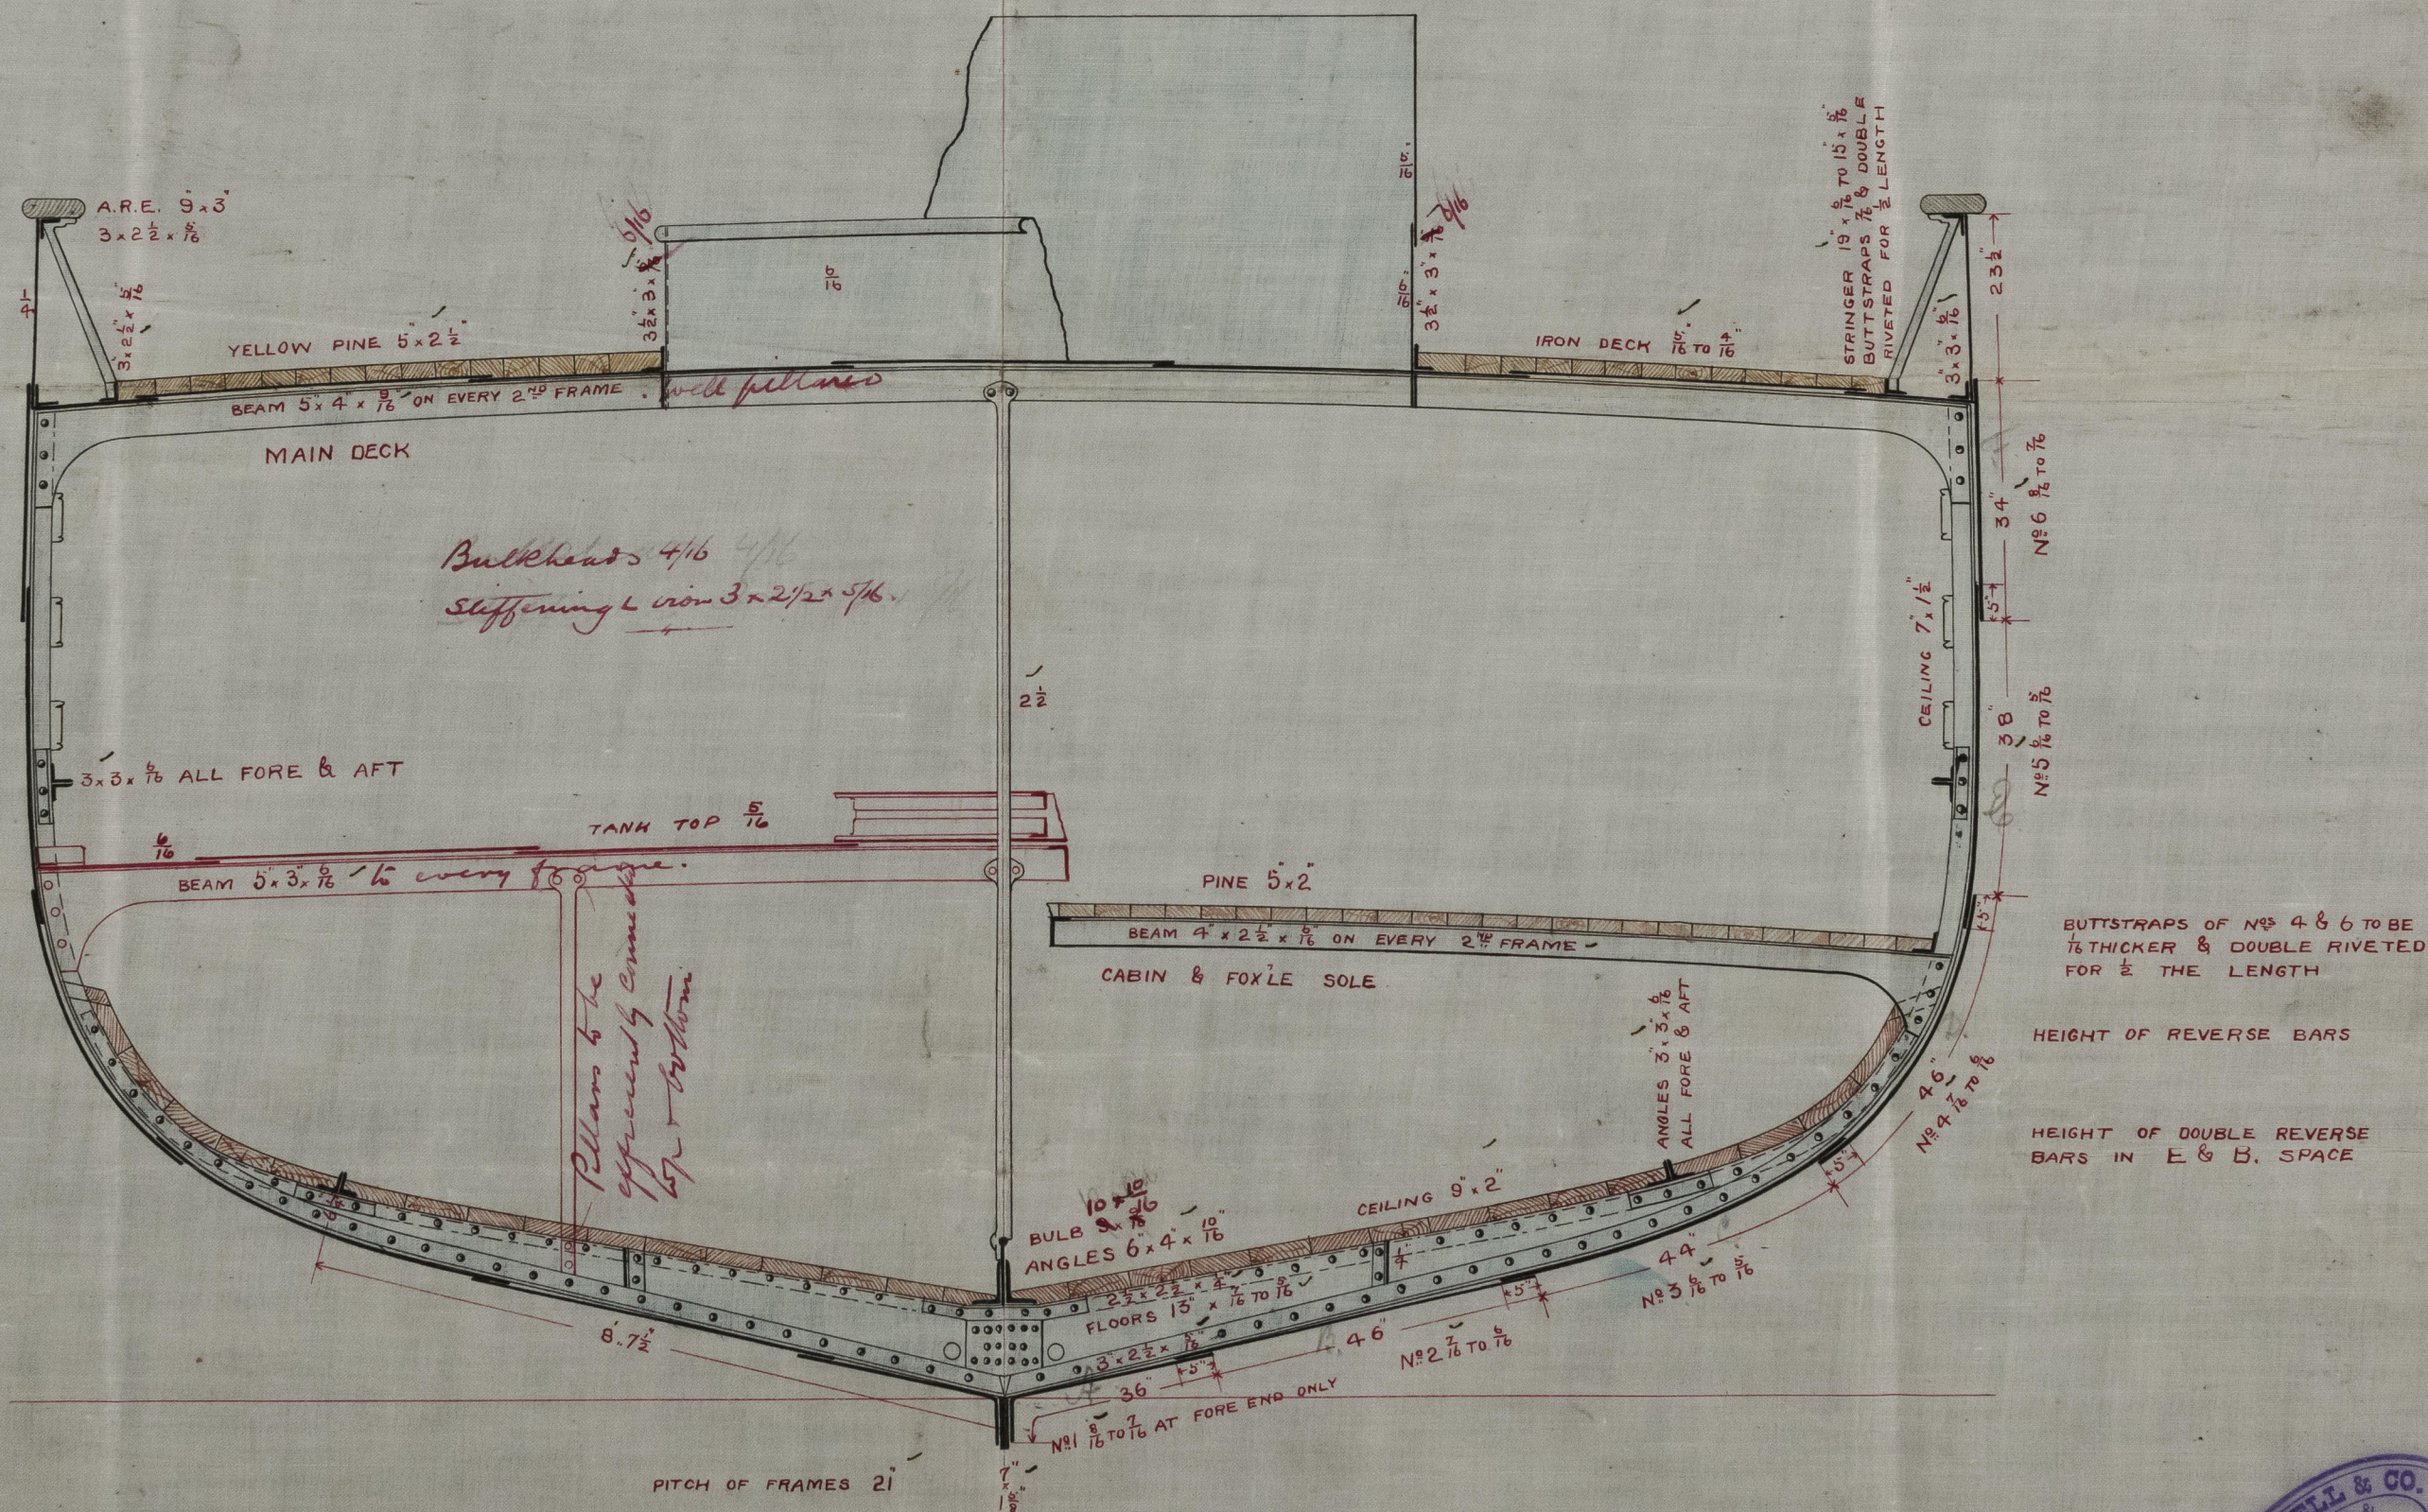

SCALE 1/2 INCH TO ONE FOOT



1/7/84
1/11/84
29/9/84



Lloyd's Register Foundation