



er. b. abn
11/11/84

S S N^o 238

SCALE $\frac{1}{4}$ INCH TO ONE FOOT

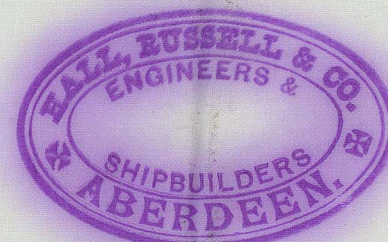


M
8-11-84

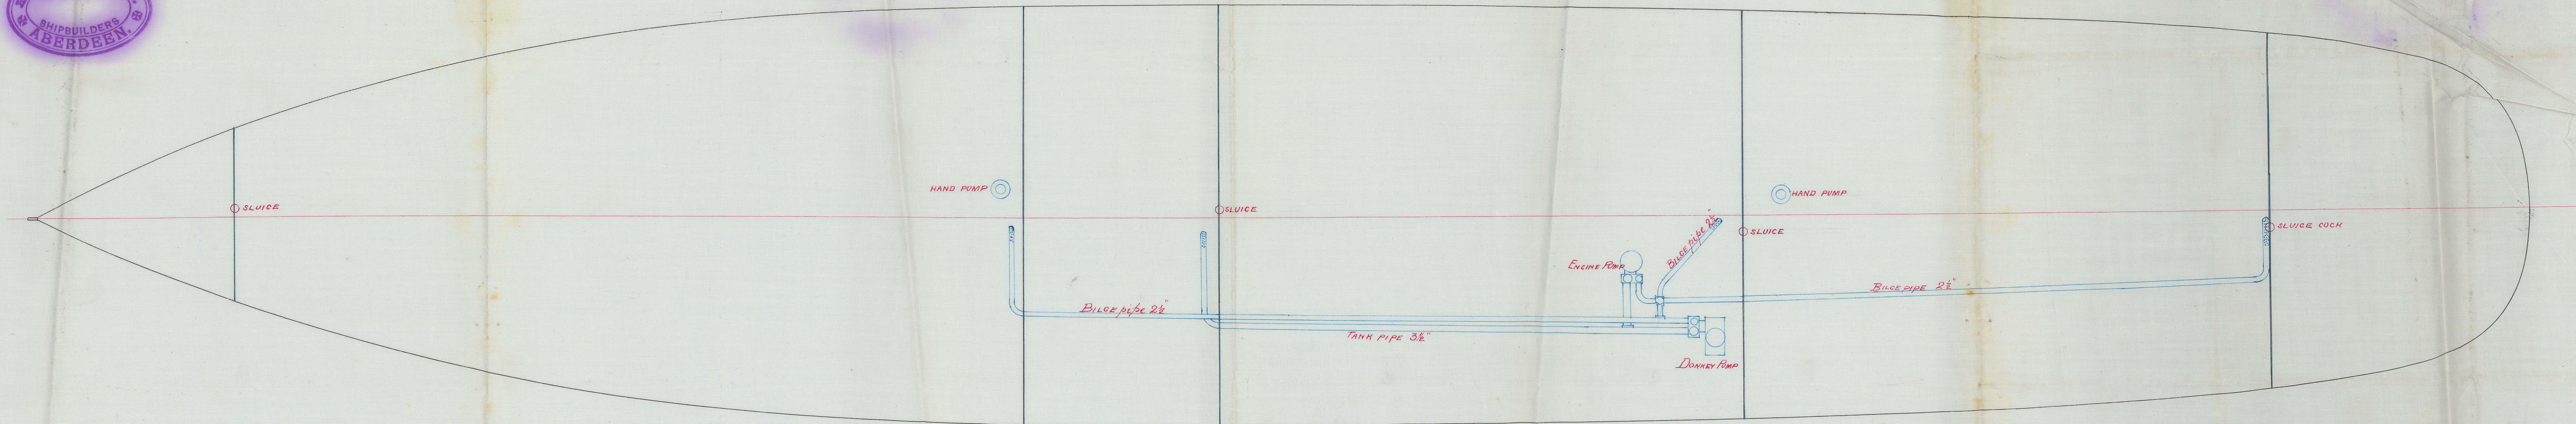

S.S. Glencagles
No of Report
3570

J.N.A.
31 Oct 1884

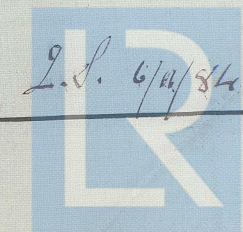

© 2021

Lloyd's Register
Foundation

88219-0008