

Alon 2570

S. S. Glenaeles
Dundes report No 365

N^o 238

SCALE $\frac{3}{4}$ IN. = 1 FOOT


DIA. OF BOILER 12'-0"

LENGTH D° 9' 0"

WORKING PRESSURE 100 $\frac{\text{lbs}}{\text{per sq. in.}}$

Steel to be manufactured by.

The Steel Co^o of Scotland.

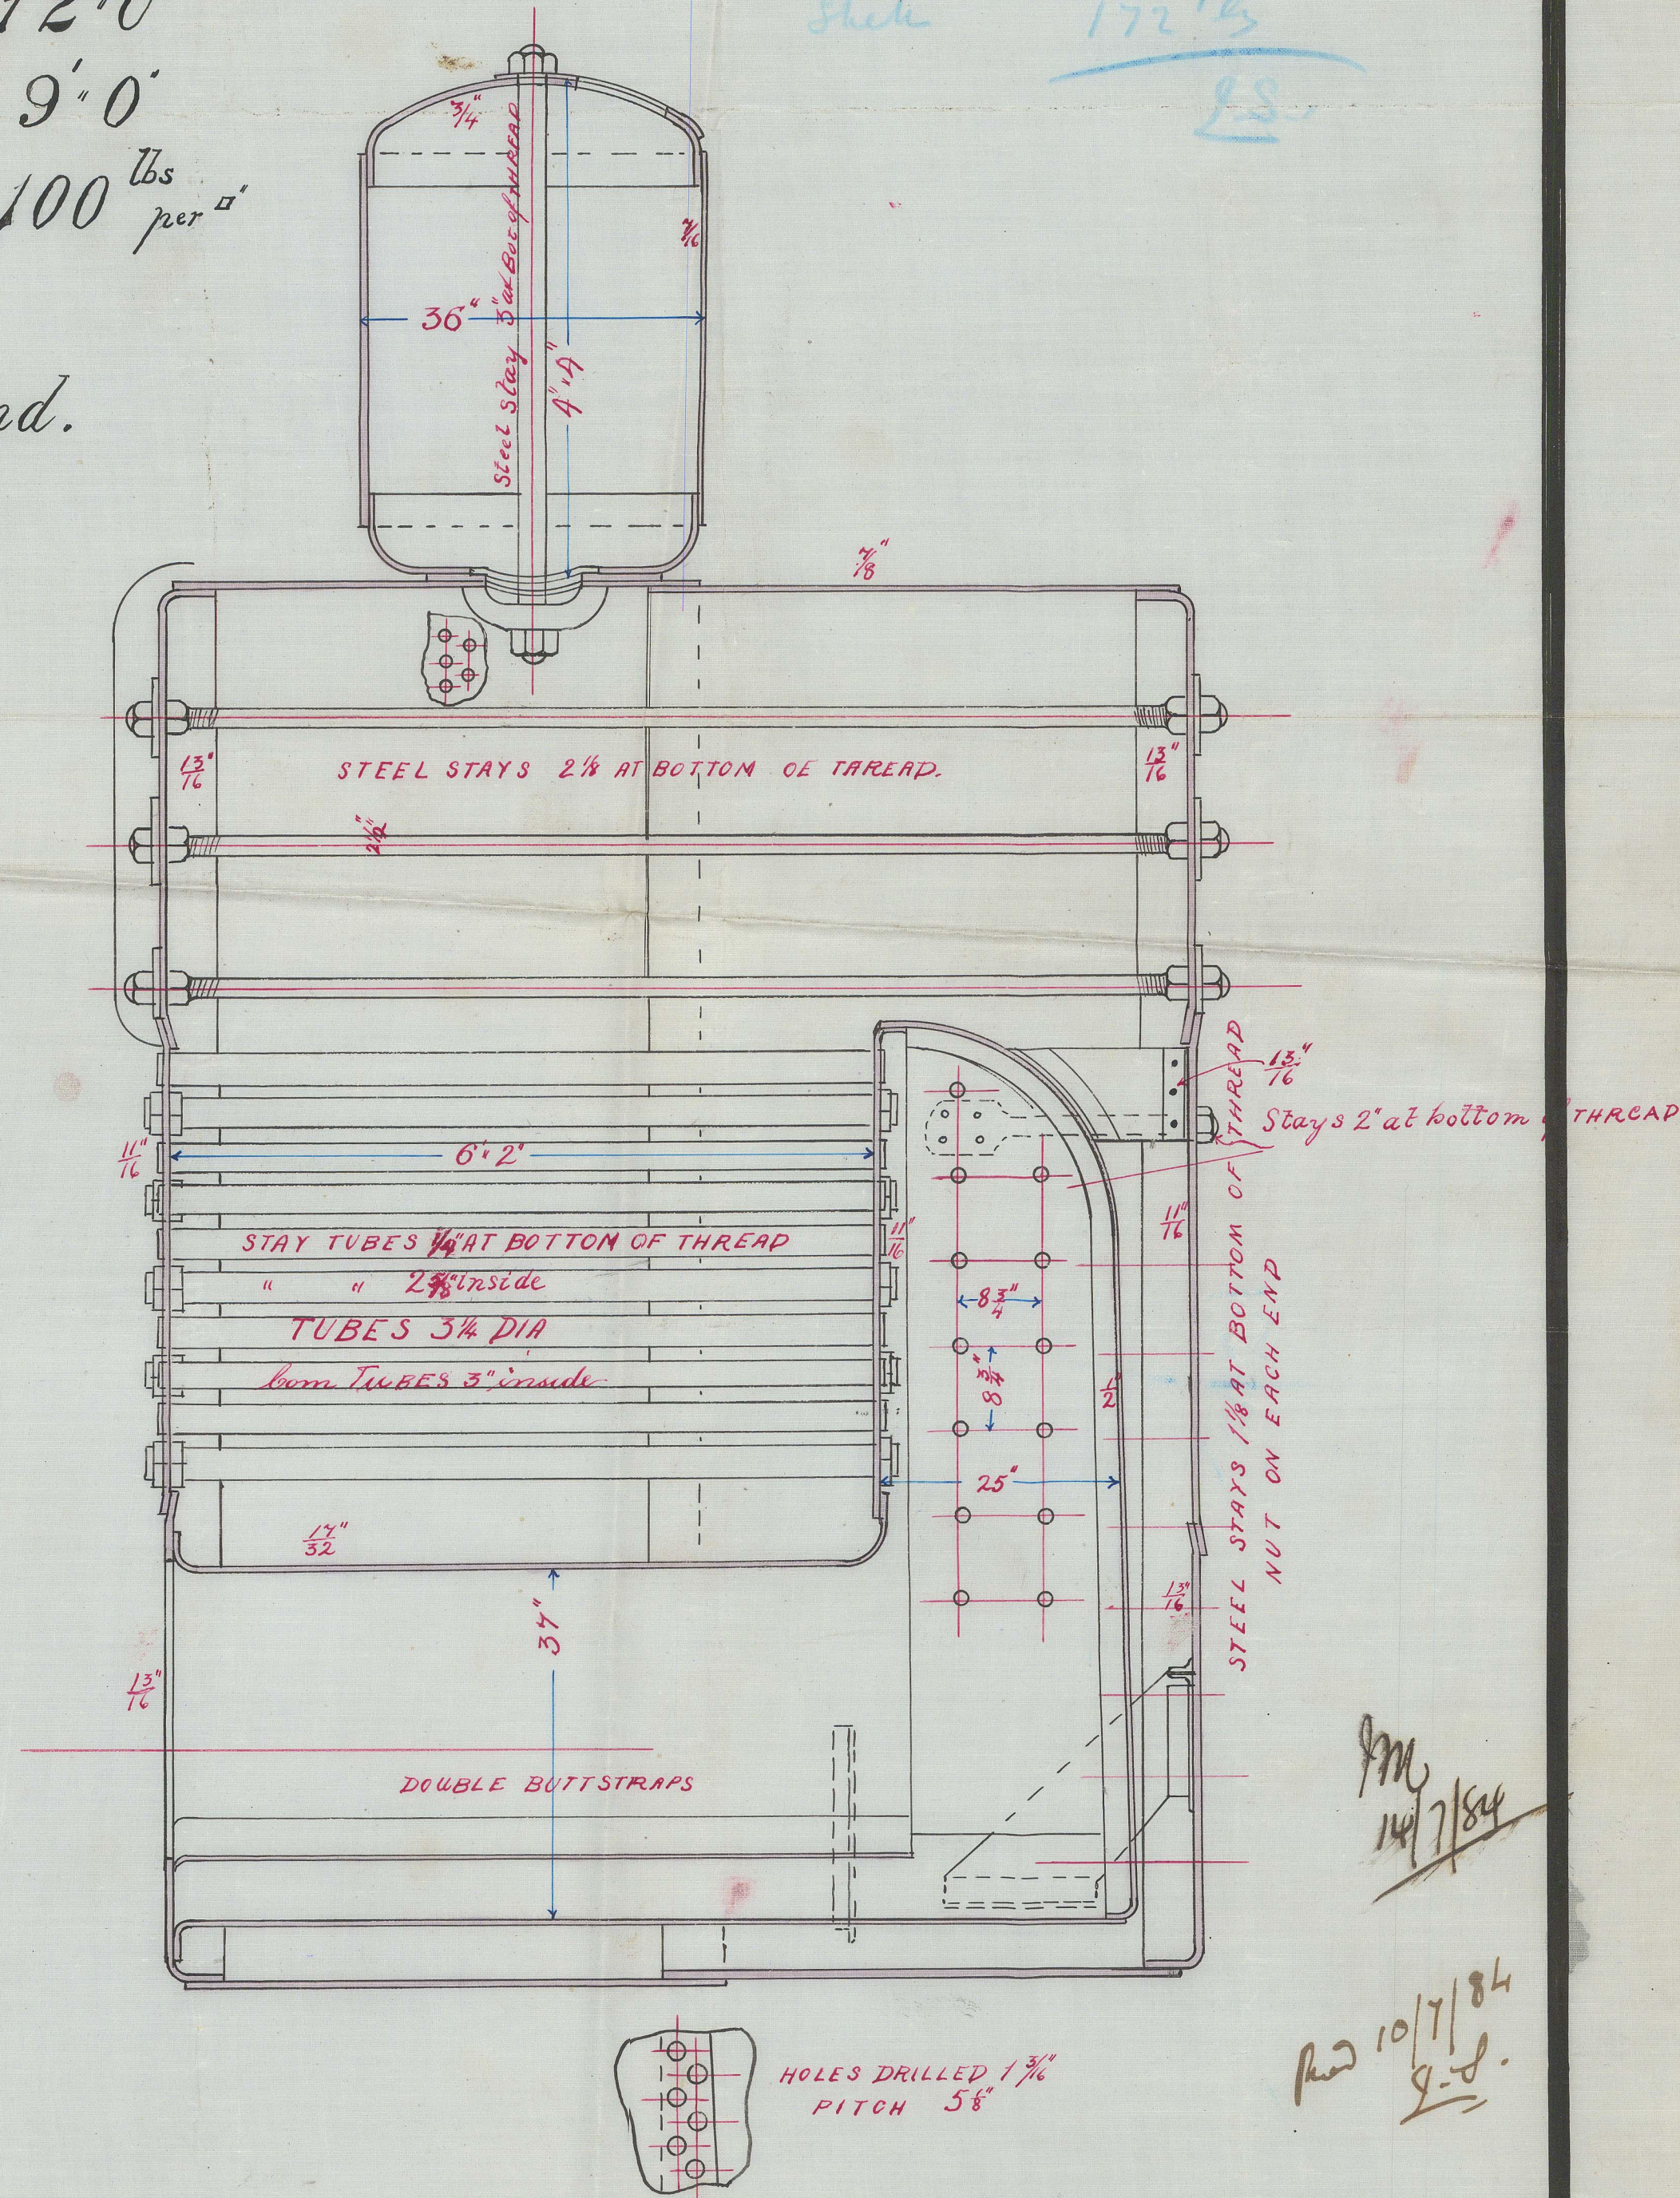

147/84

Recd 10/7/84
9-8