

LLOYD'S REGISTER OF SHIPPING
RECEIVED
20 JUN. 84
LONDON


— S S N^o 238 —

SCALE $\frac{1}{4}$ INCH TO ONE FOOT

HALL, RUSSELL & CO.
ENGINEERS &
SHIPBUILDERS
28 JUN. 84
ABERDEEN.

S.S. Glenagles
No of report 3540

Lt. T. Allen
17/84

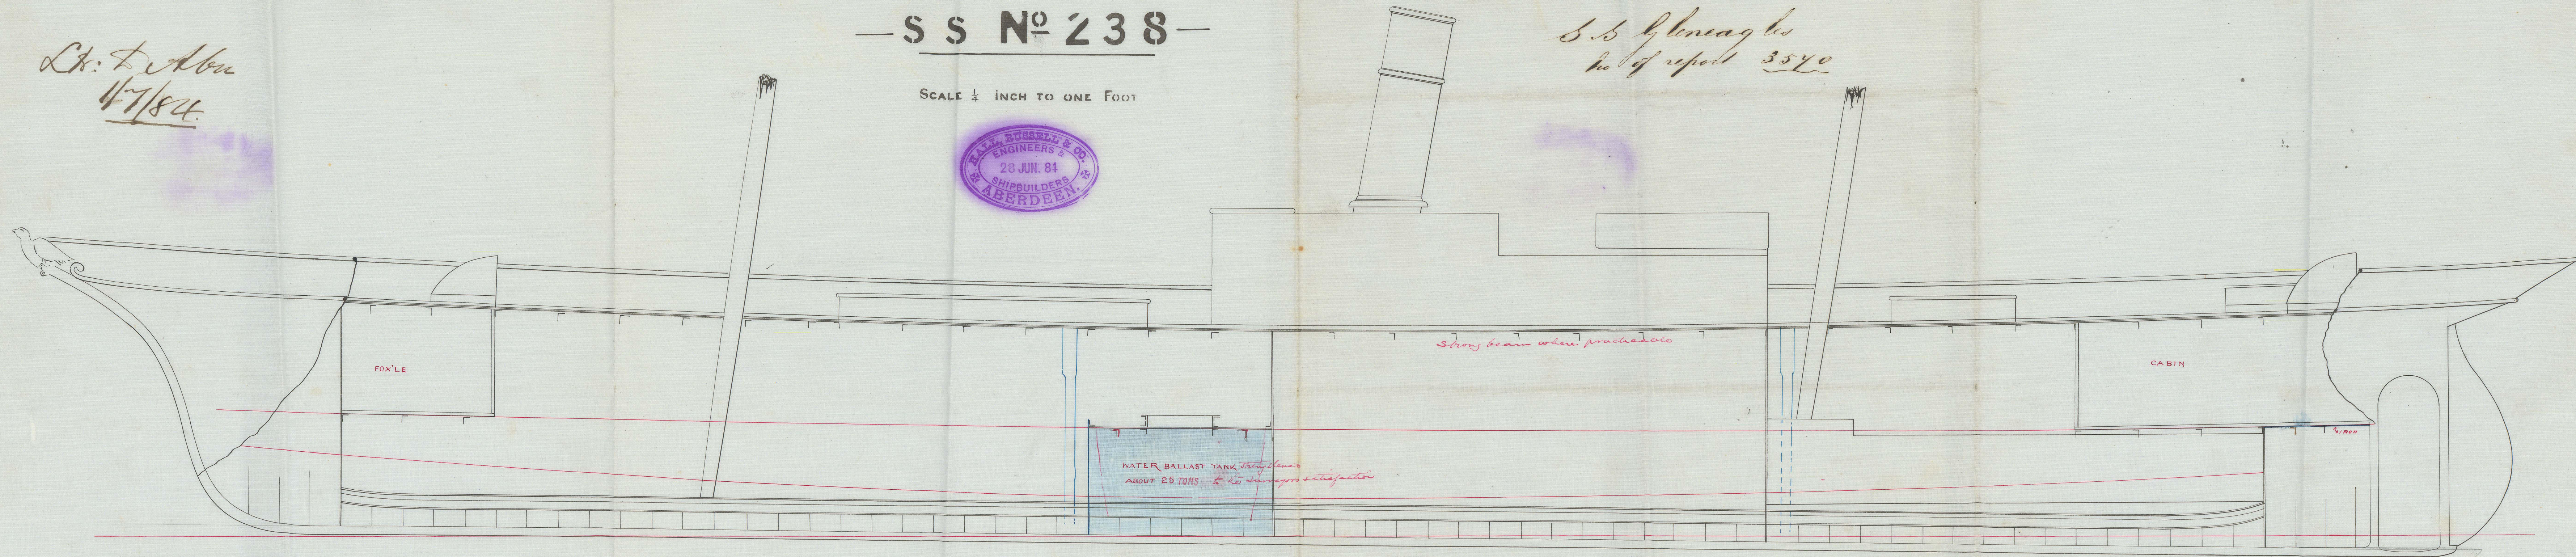

Strong beam where purchased

WATER BALLAST TANK *strong beam*
ABOUT 25 TONS *to the shipbuilders satisfaction*