

OF

Nº 324


DIMENSIONS.

LENGTH BETWEEN PERPENDICULARS 140
BREADTH EXTREME 27'-6"
DEPTH IN HOLD 13
TONNAGE Gross 380 TONS

- Numerals for Scantlings

Half Moulded Breadth	13.66
Depth from Lip of Keel to Lip of Upper Deck Beams	14.45
Girth of half midship Section	24.33
	<u>52.44</u> × 134 = 7026.96

4.9 — Breadths to the length
9.27 — Depths to " "

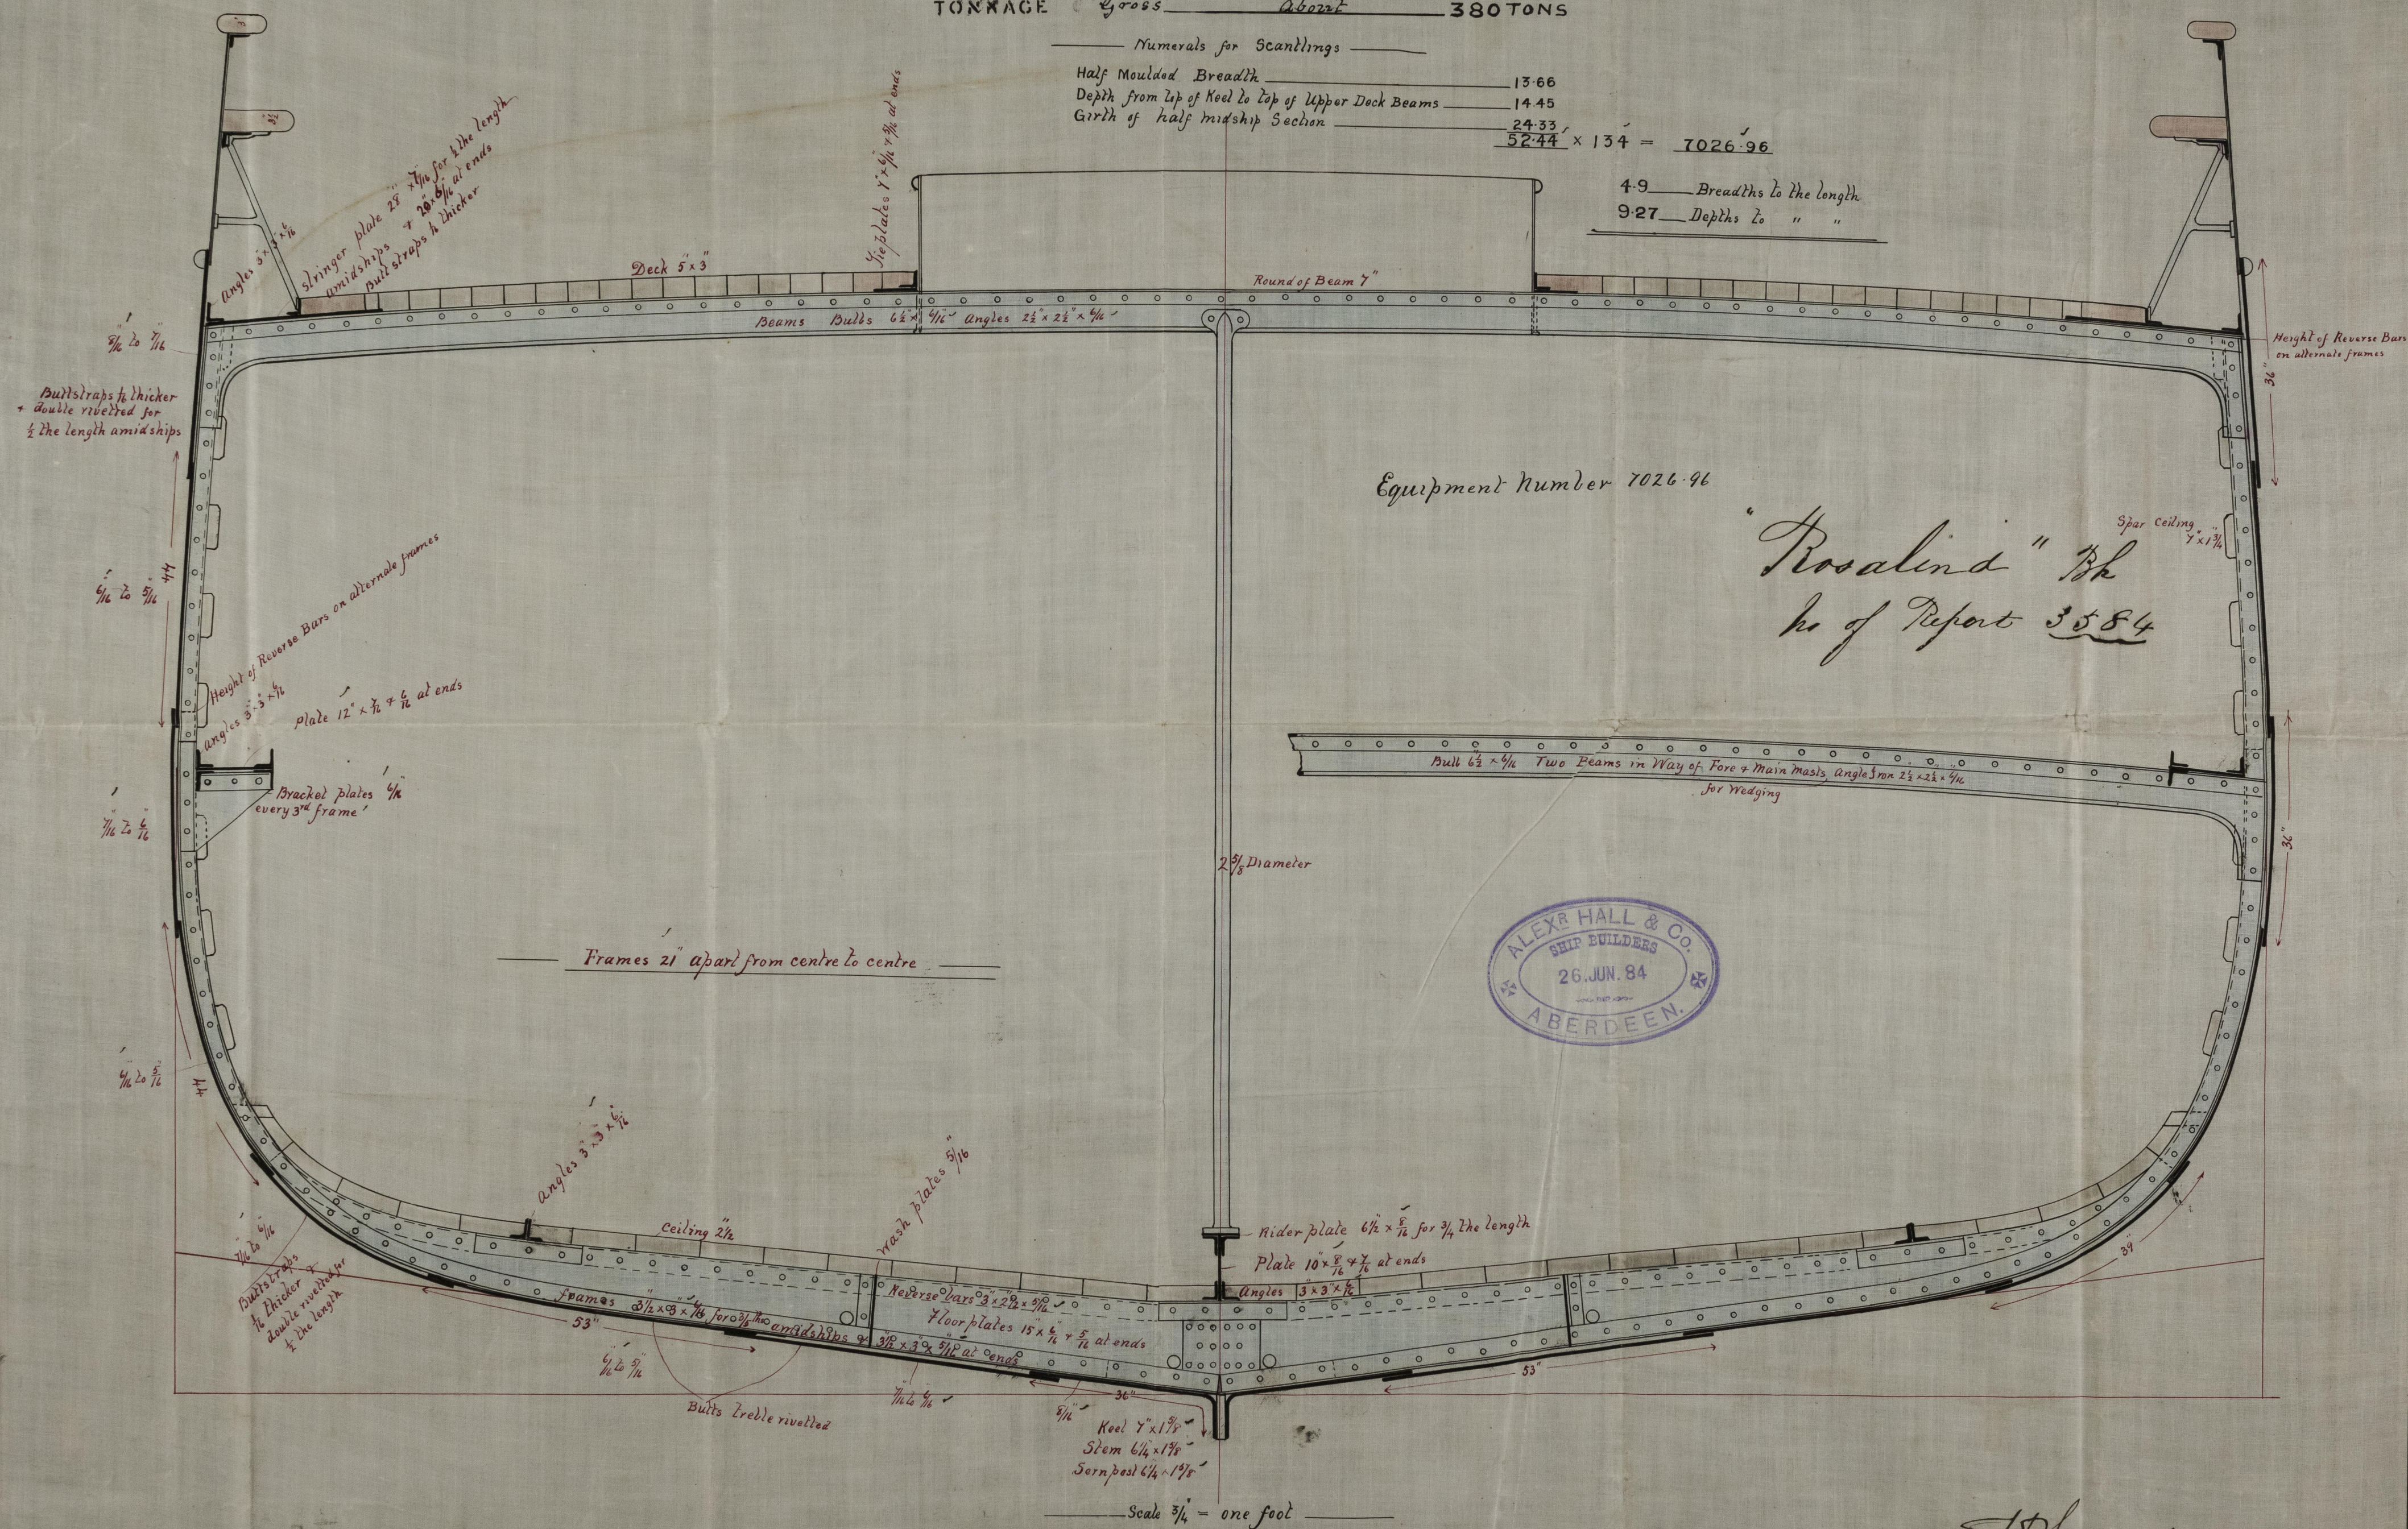

Equipment Number 7026-96

"Rosaling" Bk
ks of Report 3584



SVL
30/6/84

J.N.K. 20/6/81