





17.11.87.

MIDSHIP TANK  
OF  
S.S. N° 247

SCALE  $\frac{1}{4}$  IN = 1 FOOT

S.S. 'INANDA'

ABDN. REPT 3870.

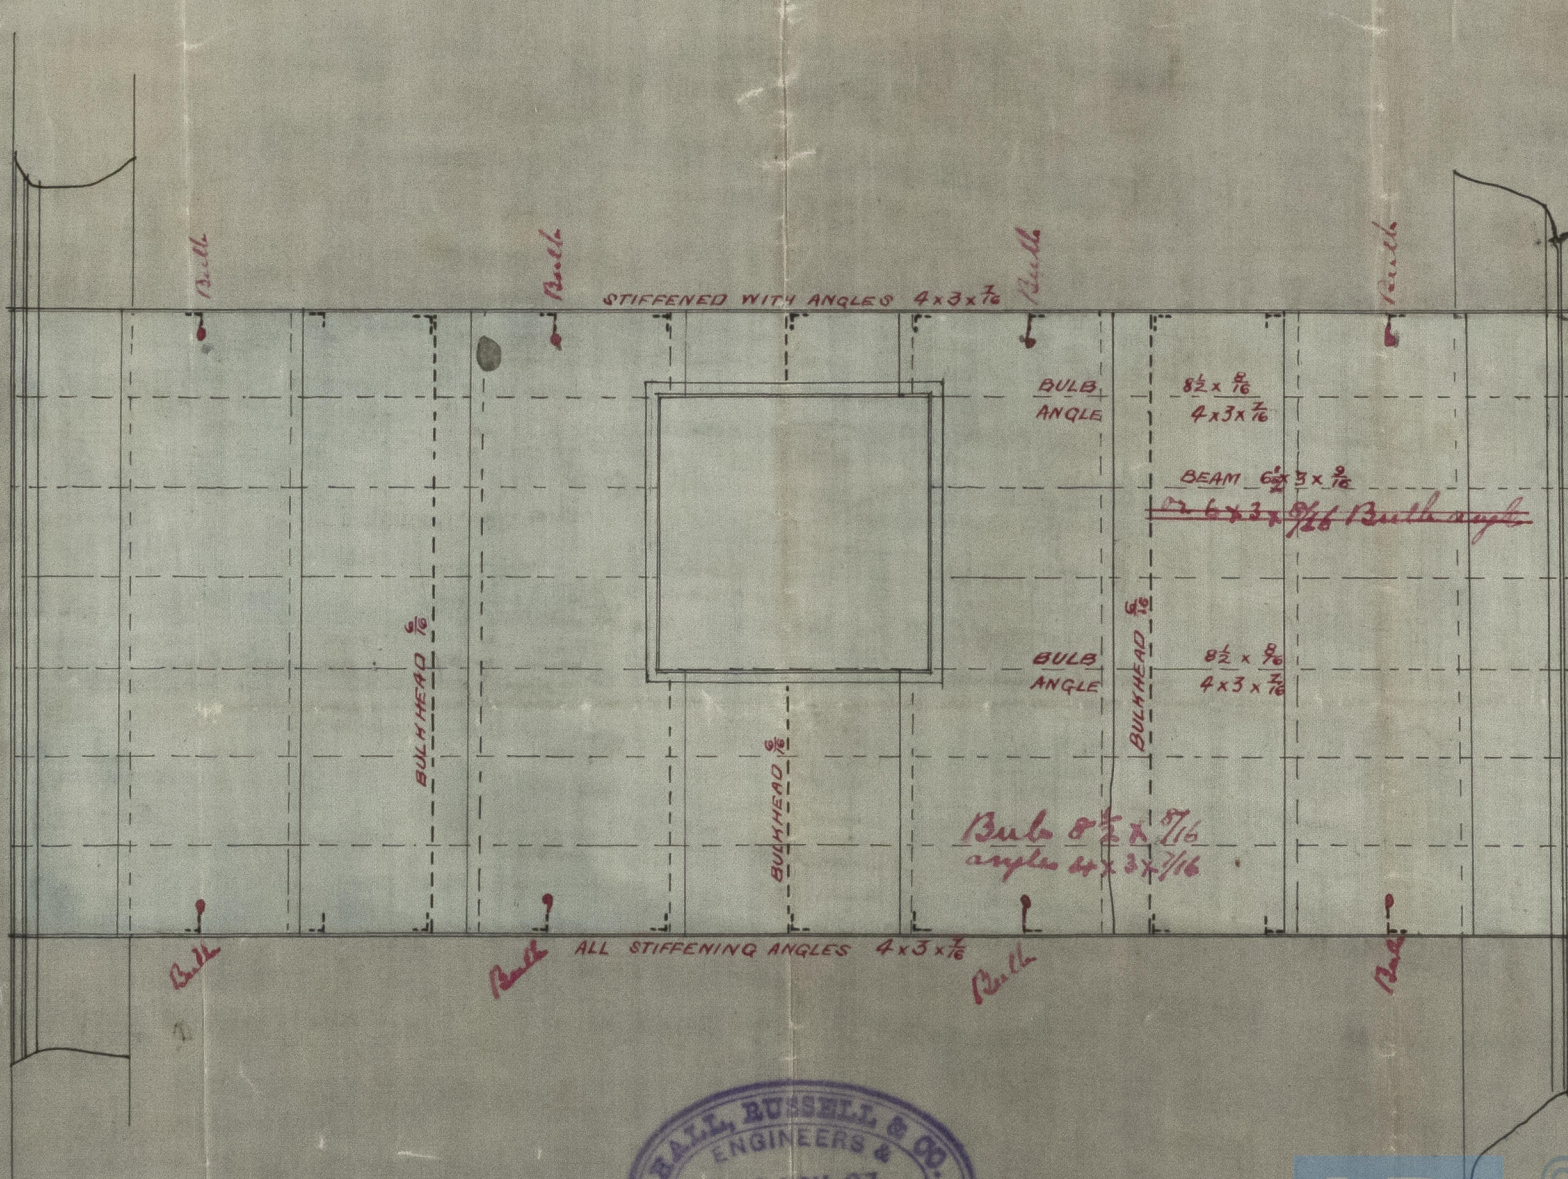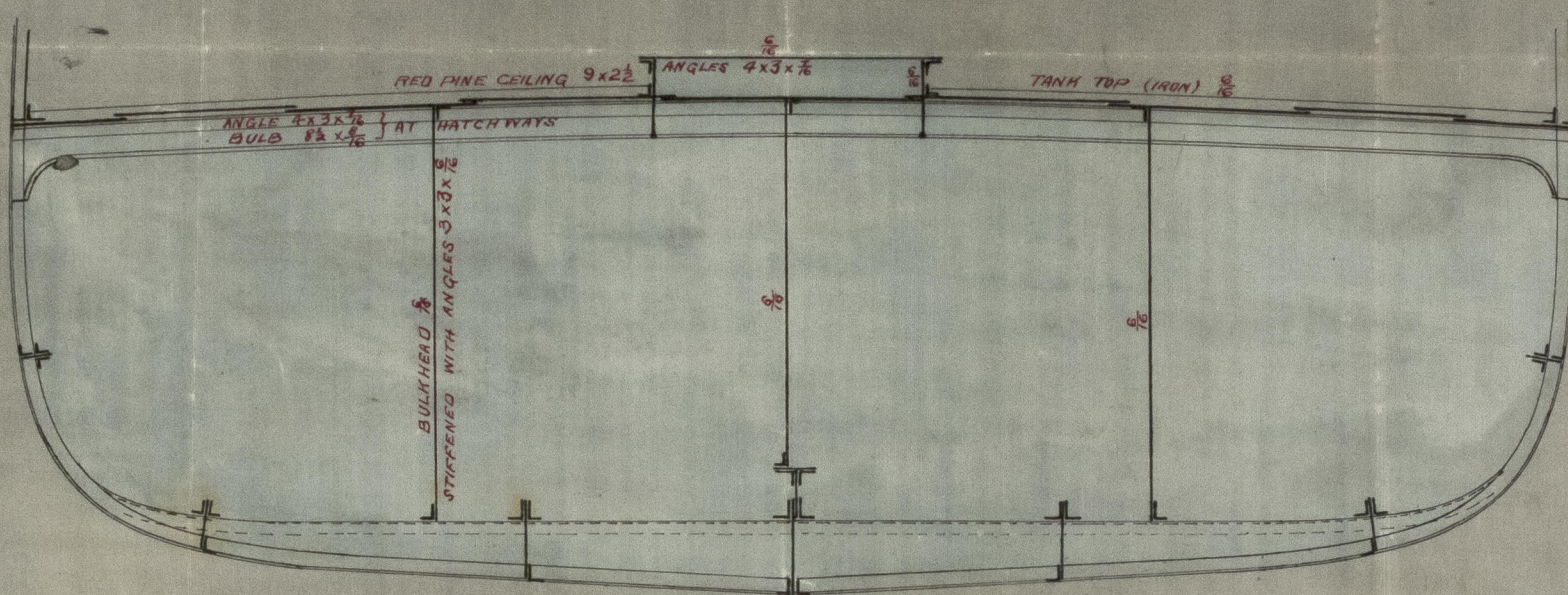

J.H.L.  
17/11/87



© 2011  
15 Nov 1887  
Lloyd's Register  
Foundation  
AEN19-0225