



PROPOSED ARRANGEMENT OF AFTERMOST BULKHEAD

S. S. N^o 247

SCALE $\frac{1}{4}$ " = ONE FOOT

S S "Inauda"
Abn Report 3870

See br
to Abn
2/3/88.

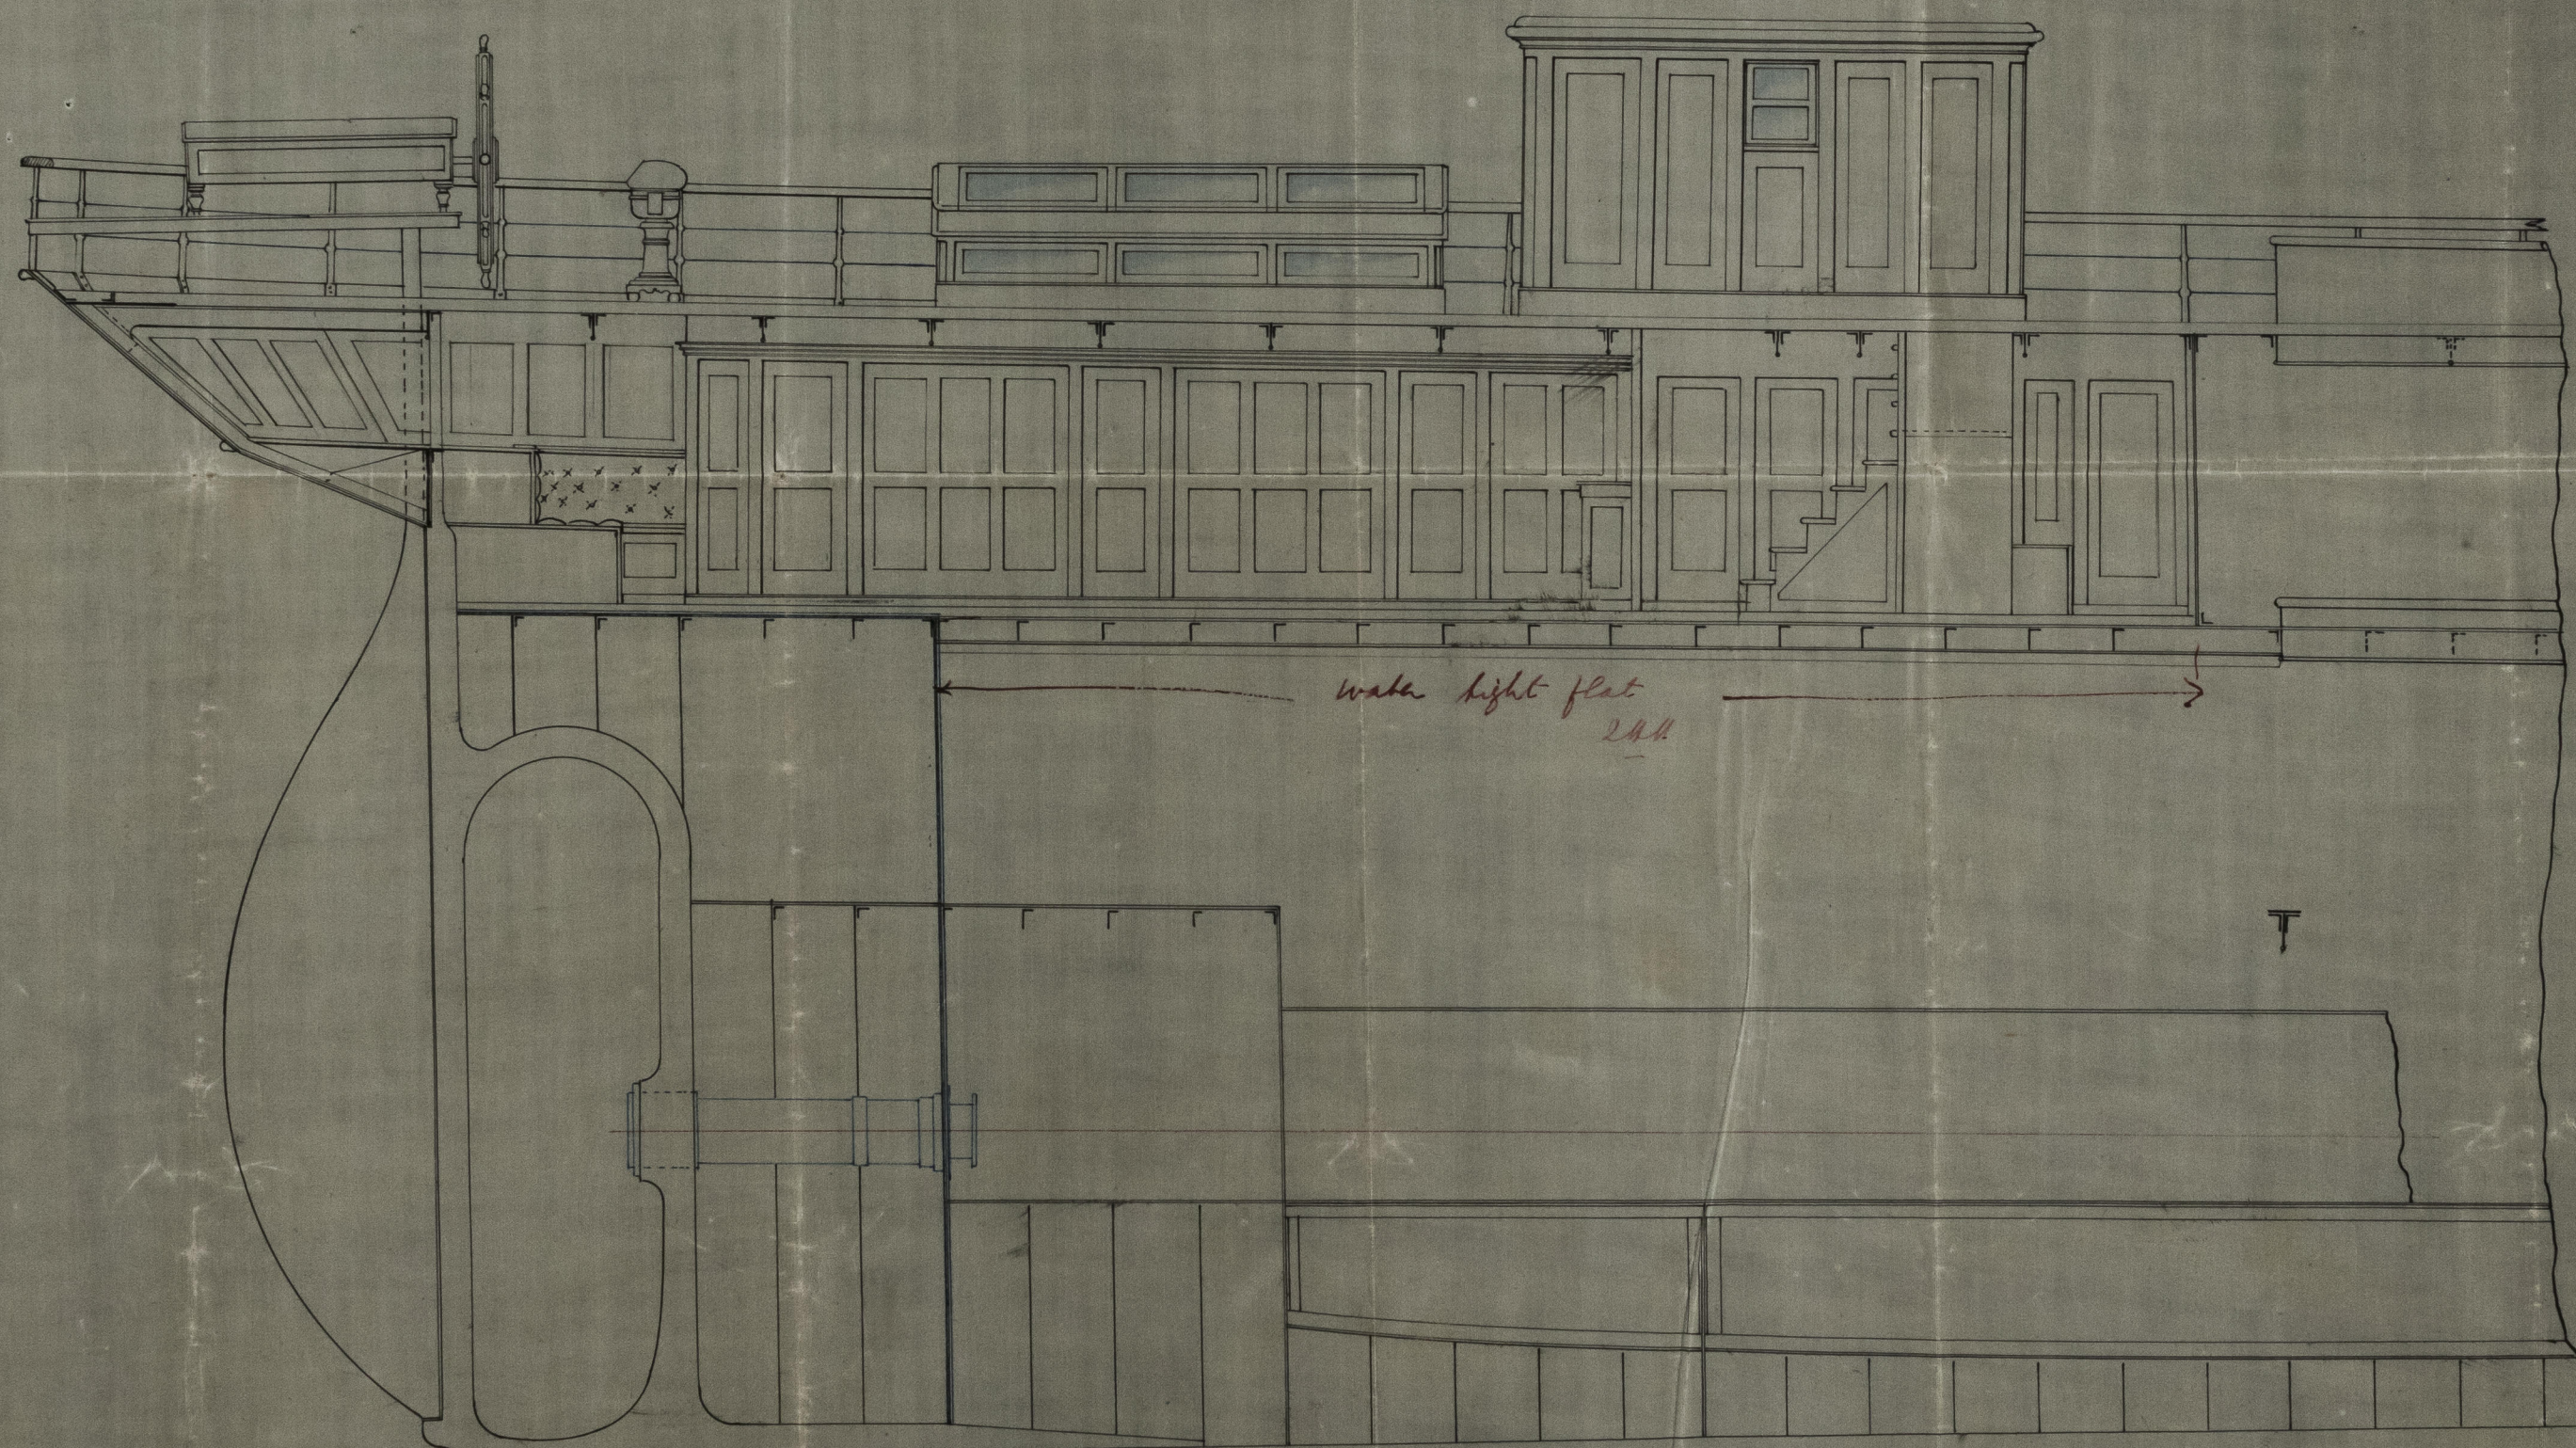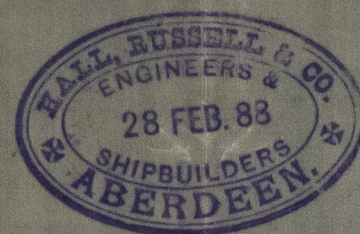

See letter
1/3/88

Abn
28/2/88



Lloyd's Register
Foundation

ABN 19-0243