

The words FORGINGS or CASTINGS, IRON or STEEL, should be struck out as may be required.

Aberdeen

S. S. "Luanda"
Abn Rep 3870-

Lloyd's Register of British and Foreign Shipping.

Received at

Office,

18

(Report on Vessel No. *3 247* Port *Aberdeen*)

No. *718a*

SHIP FORGINGS OR CASTINGS.

I have to report that the undermentioned Iron or Steel Forgings or Castings, manufactured by

The Jarrow Forge Co.

of

Jarrow

for the Vessel No. *247*, being built by *Imper Ball Russell Co.*

of

Aberdeen

have been inspected by me as set forth below, and found

to be, so far as can be seen, *sound.*

Mark on Forgings.

Lloyd's

No. *718a*

Abn. Co.


Wm Cameron

Sunduland

18/4/88

	STERN FRAME.	RUDDER FRAME.	STEM.
Material* - - - -	<i>Scrap iron</i>	<i>Scrap iron</i>	<i>Scrap iron</i>
How made - - - -	<i>Forged</i>	<i>Forged</i>	<i>Forged</i>
Dimensions - - - -	<i>8 1/2 x 5</i>	<i>6 1/4 - 3 1/2</i>	<i>8 1/2 x 2 1/2</i>
Progress on Inspection -	<i>Forged Limited</i>	<i>Forged Limited</i>	<i>Forged Limited</i>
Dates when Inspected	<i>Dec 5-8-15-20-27-30/87</i> <i>Jan 5-13-18/88</i>	<i>Jan 5-13-18-27-31 Feb 3-7-8/88</i>	<i>Dec 5-20/87 Jan 18/88</i>

SKETCHES OF FRAMES SHEWING POSITION AND DESCRIPTION OF WELDS OF FORGINGS, OR PARTICULARS OF TESTS APPLIED TO CASTINGS.

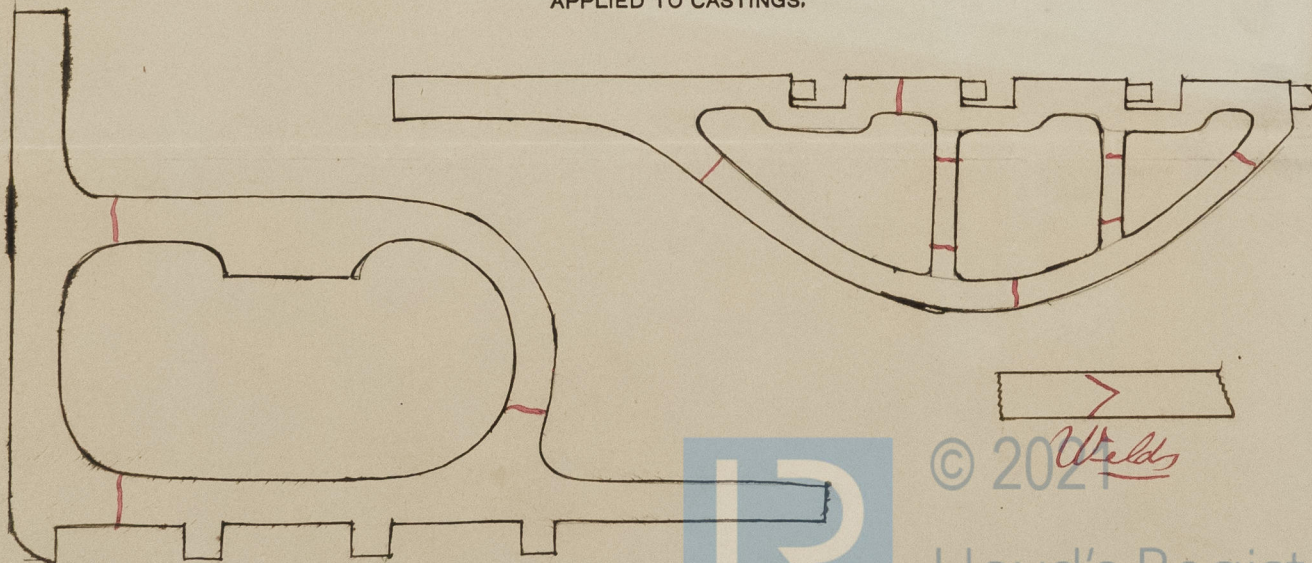

Forging Reports
H R & Co No 247

SHIP FORGINGS OR CASTINGS:



© 2021

Lloyd's Register
Foundation