

3870

DE

17.11.89.


ABON REPT 3870.

SPAR DECKED RULE

| | | | |
|---|-----------------|---------------------------|--------|
| LENGTH TWIXT PERPENDICULARS | 270.0 | LENGTH PER RULE | 268.25 |
| BREADTH MOULDED | 35.0 | BREADTH D ² DE | 35.00 |
| DEPTH D ² | 35.0 | DEPTH D ² DE | 17.87 |
| BREADTHS IN LENGTH | 7.66 | DEPTHS IN LENGTH | 15.00 |
| NUMBERS FOR SCANTLING 17.5 + 17.87 + 31.25 = 66.62 x 268.25 = 17870.815 | | | |
| NUMBERS FOR EQUIPMENT 17.5 + 24.87 + 31.25 = 80.62 x 268.25 = 21626.315 | | | |

| | |
|--|----------------|
| 1 RODERS SMALL PALMED ANCHOR | 3 1/2 EX STOCK |
| 1 " " " " " | 28 1/2 " 00 |
| 1 " " " " " | 26 1/2 " 20 |
| 1 STREAM ANCHOR | 9 1/2 " 0 |
| 1 KEDGE " | 4 3/4 " " |
| 1 " " " | 2 1/2 " " |
| 270 FATHOMS OF 1 1/8" STUD CHAIN CABLE, | |
| 75 " 1 1/4" STREAM CHAIN, | |
| TO BE TESTED ACCORDING TO LLOYD'S REQUIREMENTS | |

100. A. GRADE.

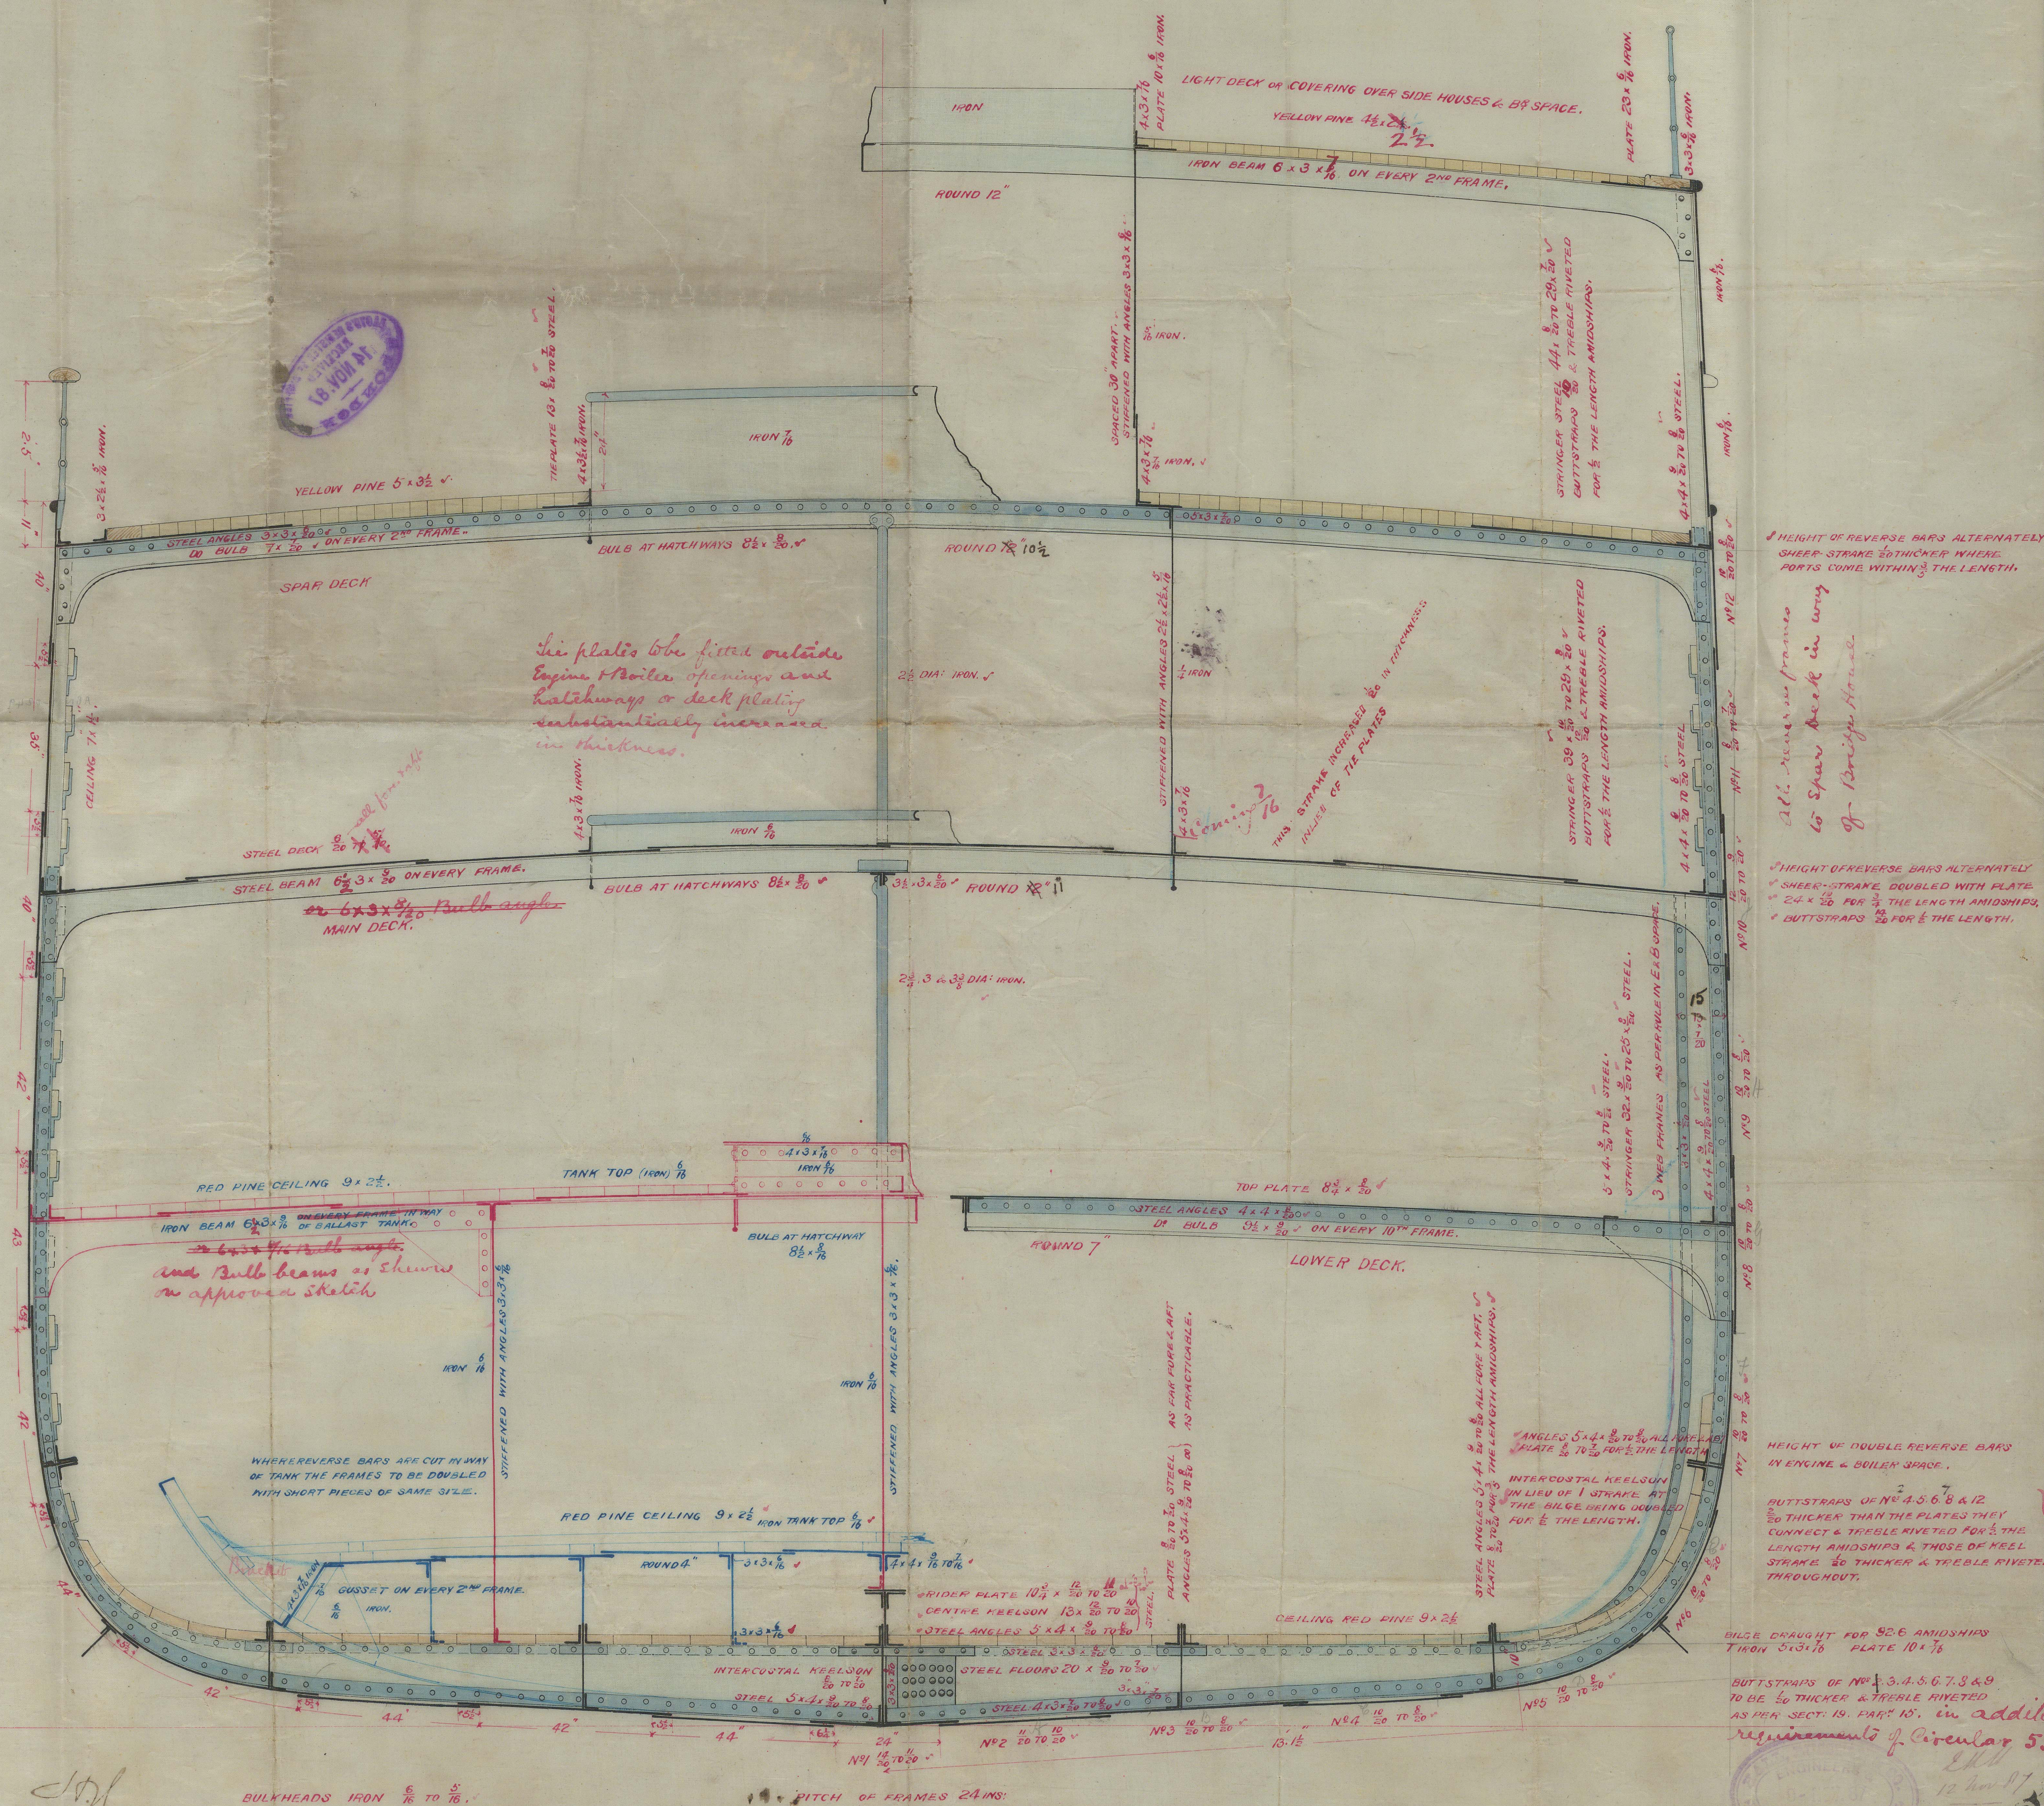

Scale $\frac{1}{2}$ Inch to one Foot

BUZZ CRACKS FOR S.E. AMIDSHIPS
TIRON 513.10 PLATE 10 7/8

BUTTSTAINS OF NOS 1, 3, 4, 5, 6, 7, 8 & 9
TO BE 1/2" THICKER & TAPERLE RIVETED
AS PER SECT. 15. PART 15. in addition to the
requirements of Circular 582

ENGINEERS
12, Ave. 17

RECEIVED
7-DEC-87
LLOYD'S REGISTER

Mission

22 N

SPAR DECK

LENGTH TWIST PERPENDICULARS 270.0
BREADTH MOULDED 35.0
DEPTH 7.00
BREADTHS IN LENGTH
NUMBERS FOR SCANTLING 17.5 + 17.87 + 31.5
NUMBERS FOR EQUIPMENT 17.5 + 24.87 + 38.5

100.A.C

22 INANDA
from 1891 3870.

17.11.87

RECEIVED
14 NOV 87
LLOYD'S REGISTER

YELLOW PINE 8 x 35

WOM 8 x 35 x 3

5.2 5.0 + 11.7

BUILT AT HATCHWAY 35.5

SPAR DECK



© 2021
Lloyd's Register
Foundation

ABN 19-0249