

W.L. Sum  
24/5/84


Ab  
3919

# Boiler for 4-84"


for 2 buttie & tons  
SS no 167

Extreme Diam. 13'6"  
Length 10'0"  
Working Pressure 100 lbs pr " "  
Scale  $\frac{3}{4}$  = 1 ft

Scam	75-0/0
Thick	73
Shell	101 lb
Furnace	109"
Cor. Iron plate	101"
Steel stays	7727 - 242
End plates	105"
Buttie stays	7314 - 242
Buttie stays	8020 - 242
Scam	69-0/0
Thick	67
Shell	206 lb
	25

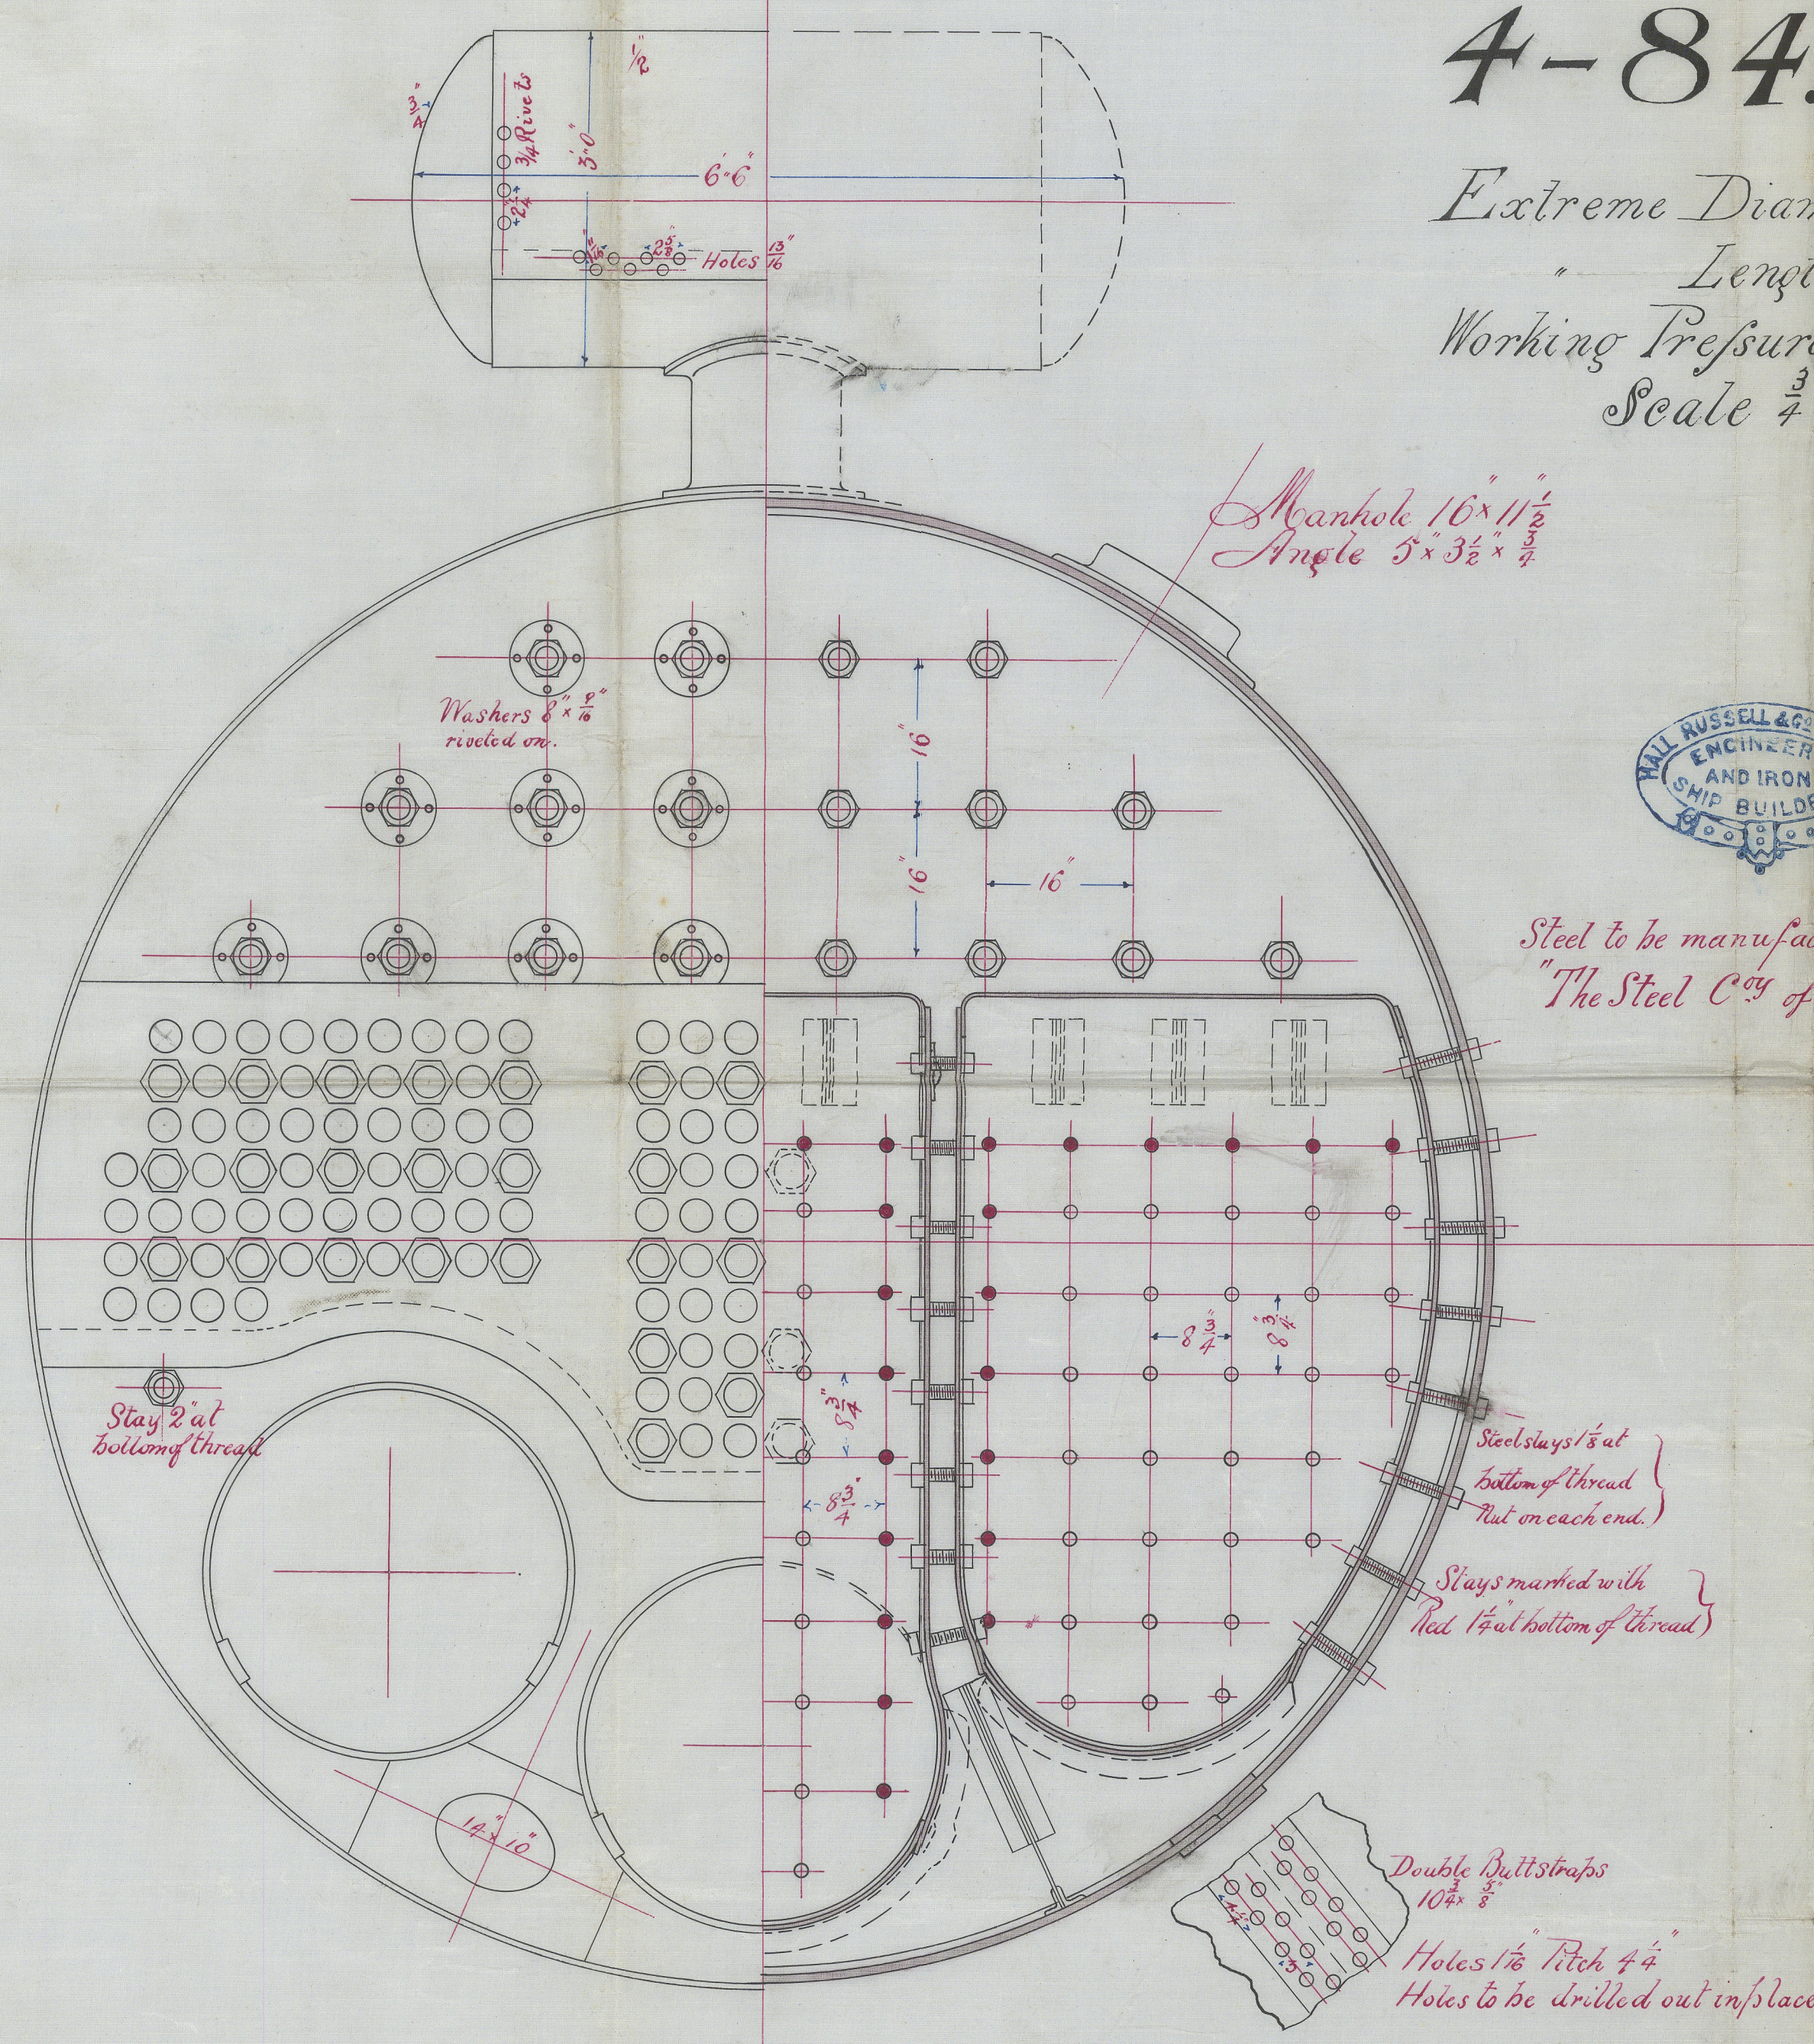

Steel to be manufactured by  
"The Steel Coy of Scotland"

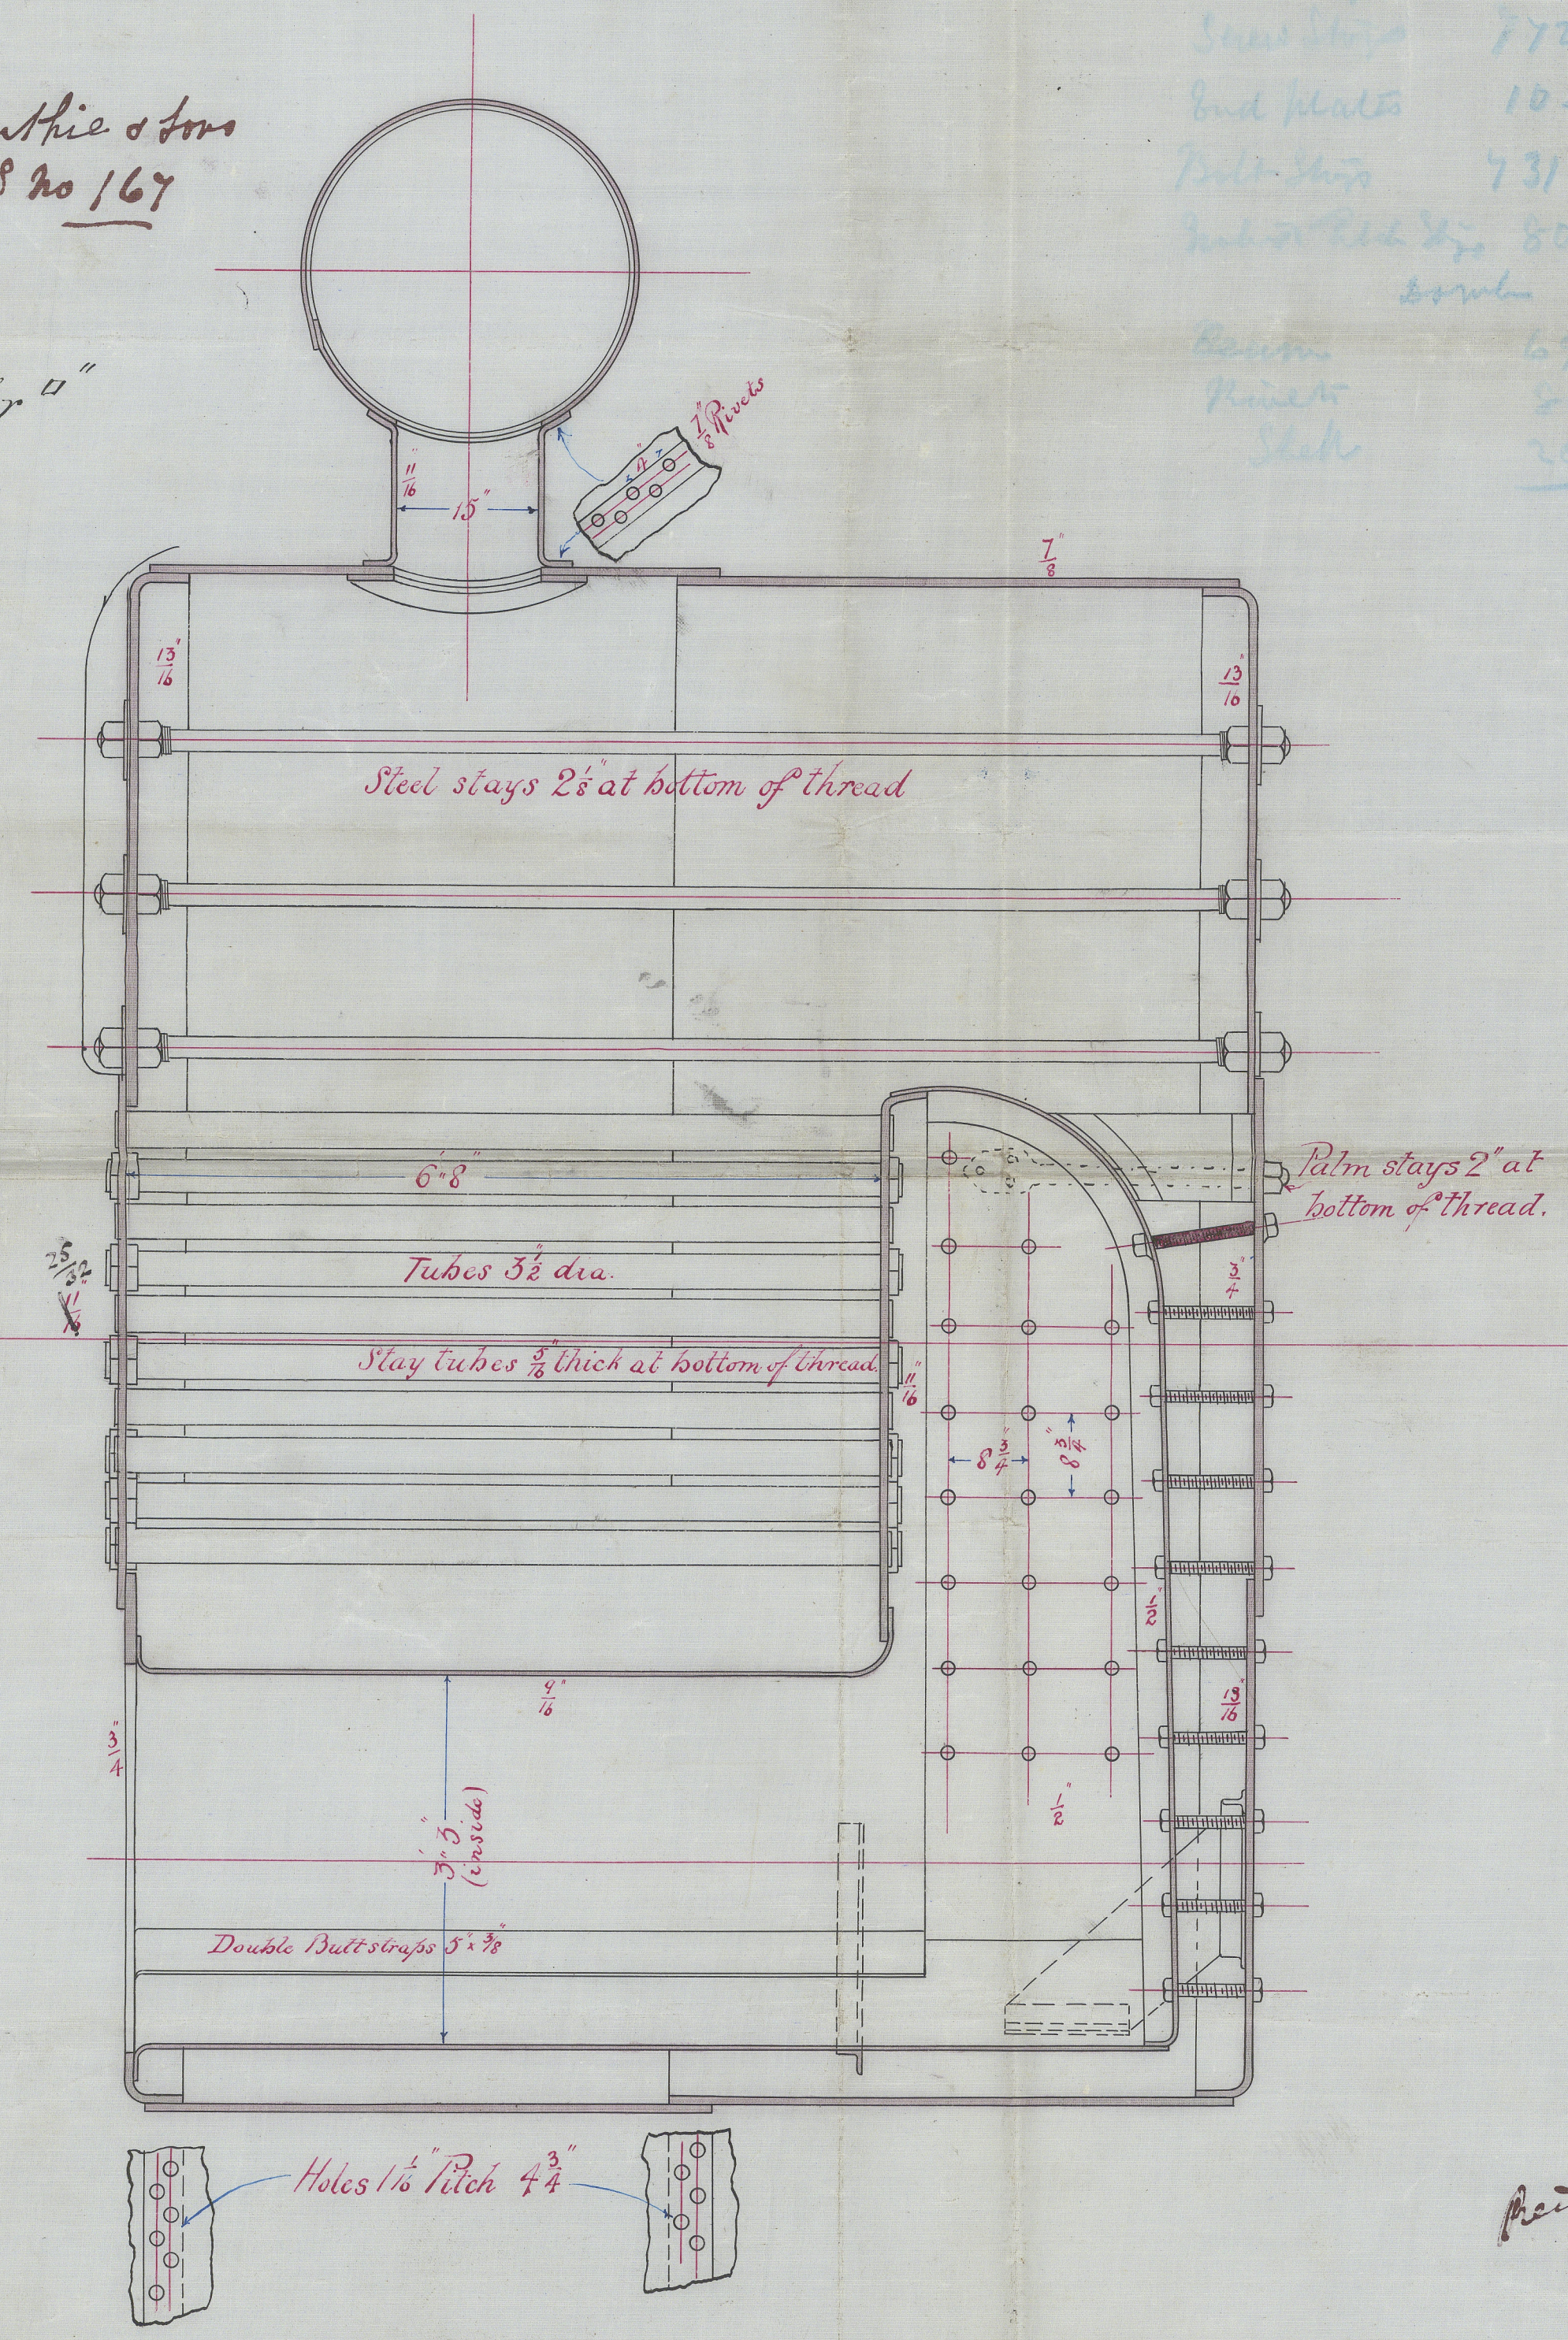

Red 21/5/84  
L.S.

D.S.  
24/5/84