



Yarrow Shipbuilding Co 3994



SAT 13 DEC 1888

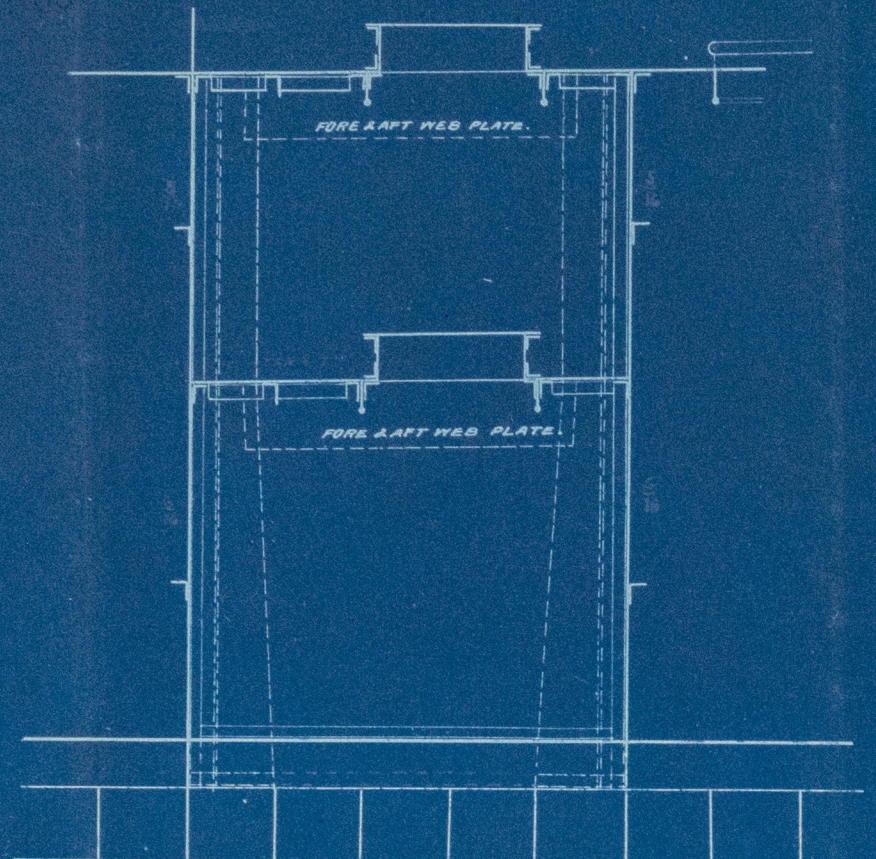


Longitudinal Section.

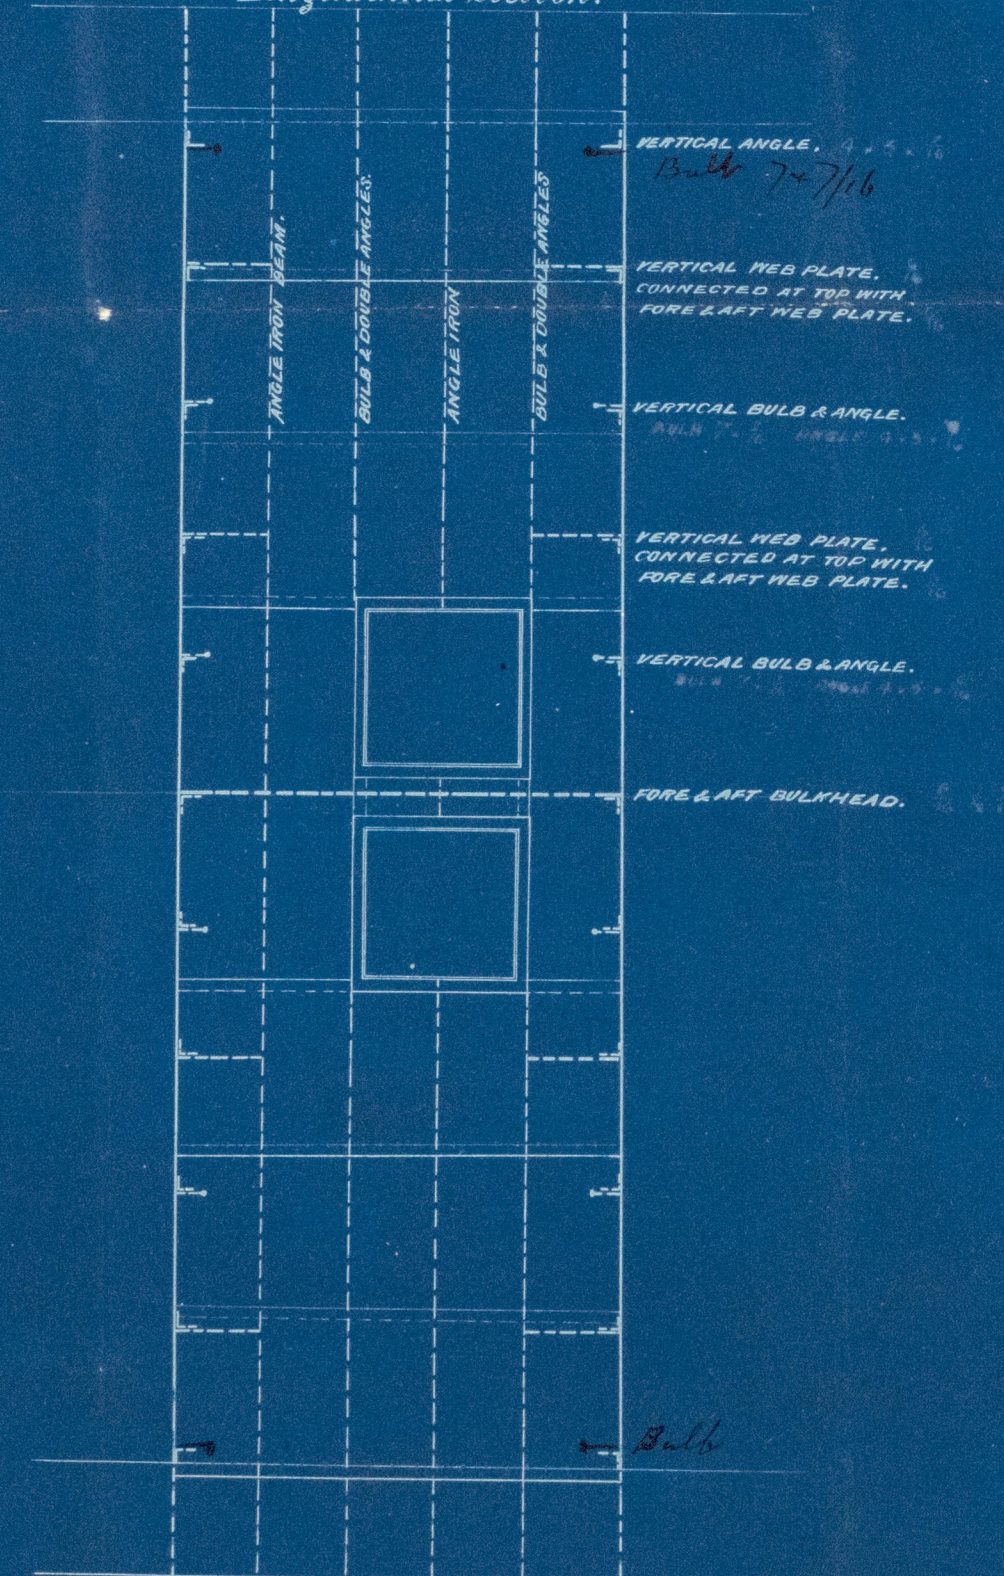

Plan.

MIDSHIP TANK
OF
S.S. N° 251.

SCALE $\frac{1}{4}$ IN = 1 FOOT.

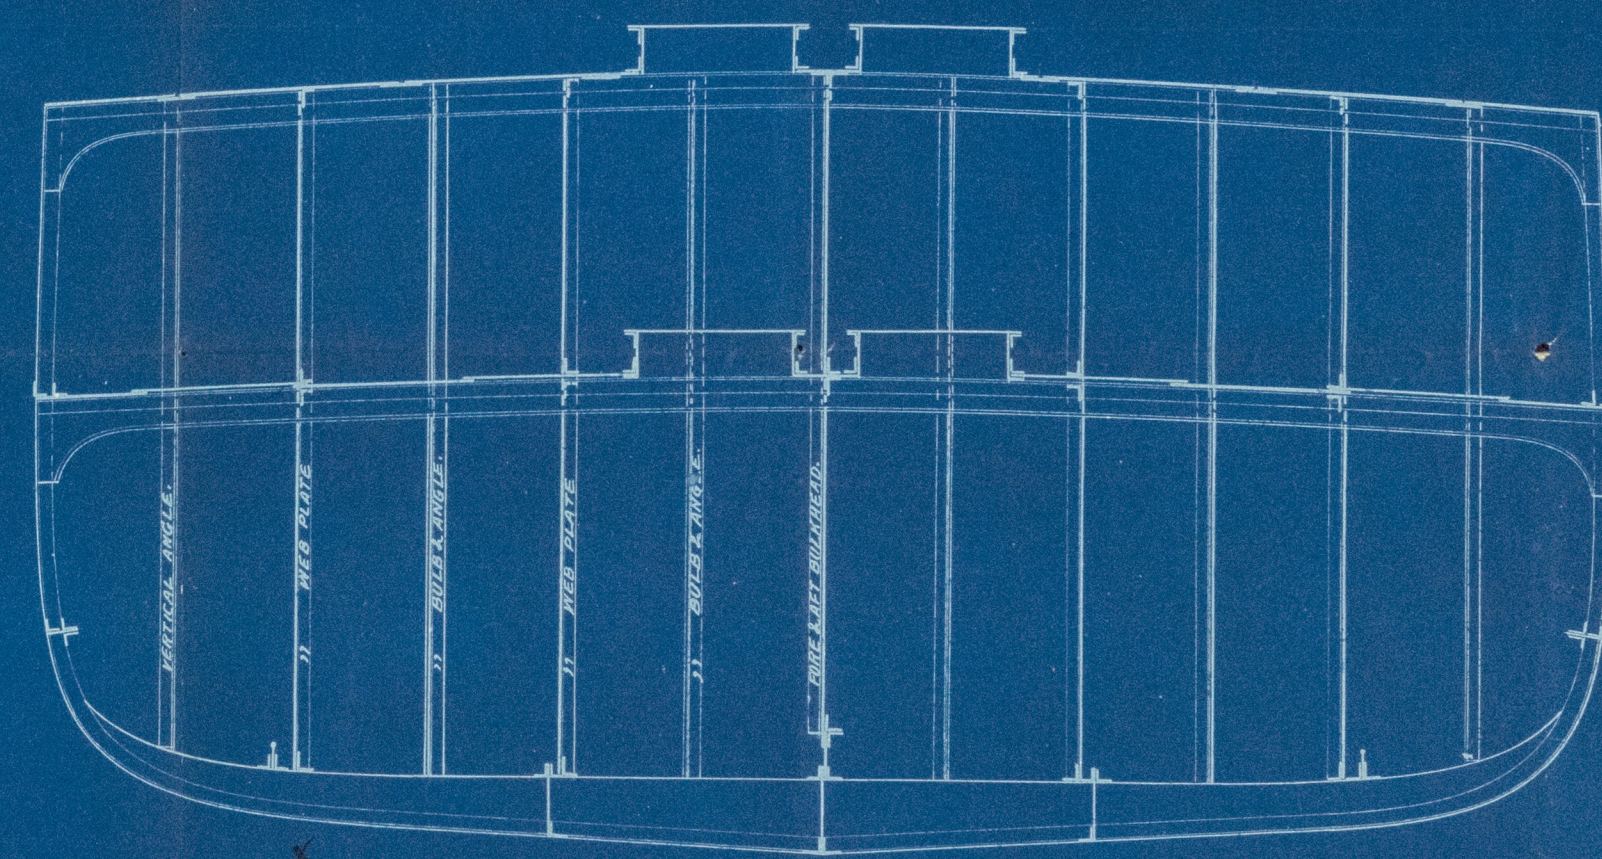

Section.

HALL, RUSSELL & CO.
ENGINEERS & SHIPBUILDERS,
ABERDEEN.



Hall Russell & Co.
L. S. 251
Midship Tank.



© 2021

Lloyd's Register
Foundation

ABN20-0087