
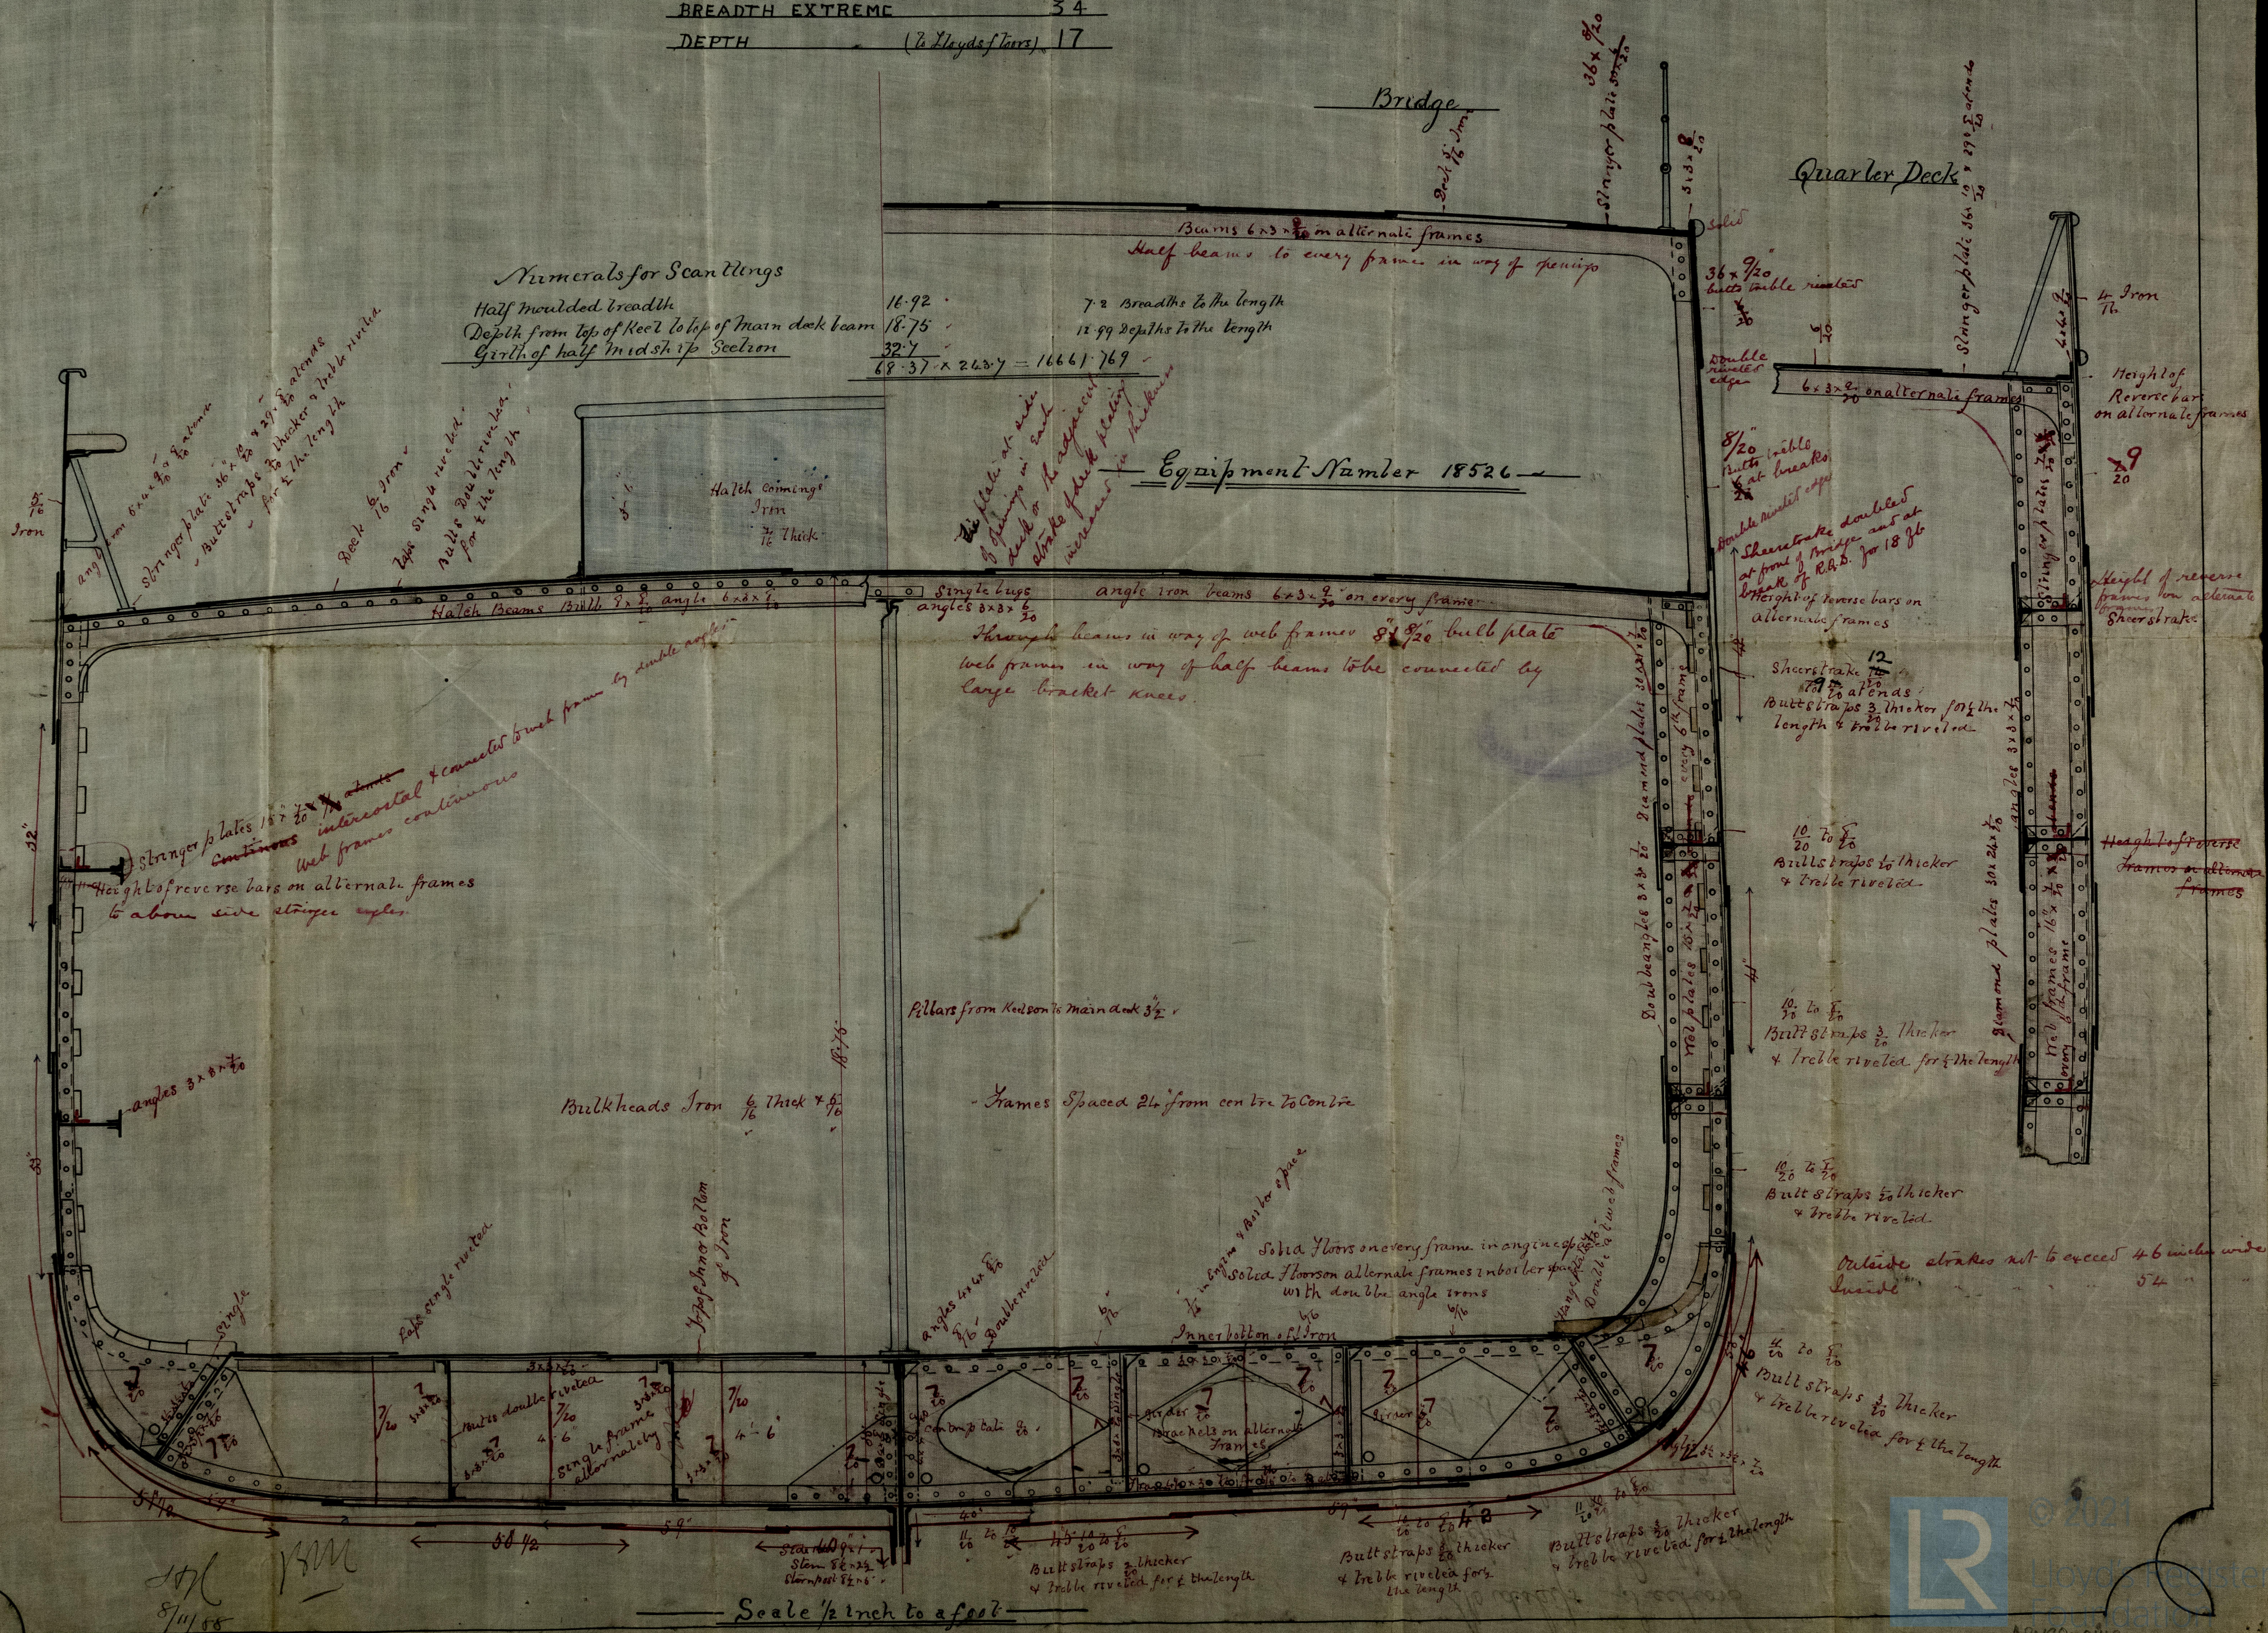


LENGTH BETWEEN PERPEN^{DS} --- 245
BREADTH EXTREME 34
DEPTH (2 Lloyd's fms) 17

THU 8 NOV 83

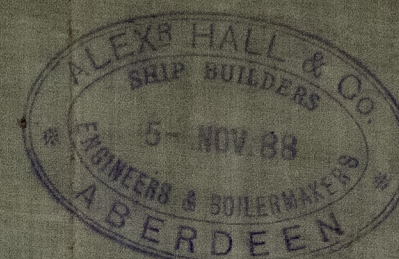

Midship Section
Messrs. A. Hall & Co's
S. S. No 333

"S. S. Bonaccord"



LLOYD'S REGISTER OF SHIPS
RECEIVED
11 DEC 99
LONDON

ABN20-0149



© 2021

Lloyd's Register
Foundation