

Lloyd's Register of British and Foreign Shipping.

(Report on Vessel No. _____ Port _____)

No. 23

SHIP FORGINGS OR CASTINGS.

I have to report that the undermentioned Iron or ~~Steel~~ Forgings or Castings, manufactured by Messrs James Carnichael & Co of Dundee for the Vessel No. 333, being built by Messrs A. Hall & Co of Aberdeen have been inspected by me as set forth below, and found to be, so far as can be seen, in sound and efficient condition.


Mark on Forgings.

Lloyd's
No. 108

R Keydell
Dundee

	STERN FRAME.	RUDDER FRAME.	STEM.
Material* - - -	<i>Scrap iron</i>	/	<i>Scrap iron</i>
How made - - -	<i>Forged</i>		<i>Forged</i>
Dimensions - - -	<i>8 1/2 x 5 "</i>		<i>9 x 2 1/2 " flat, head 8 x 2 "</i>
Progress on Inspection -	<i>25 January 1889</i>		
Dates when Inspected {	<i>4 March, 23 March 3 April</i>		<i>15 February 1889</i>

SKETCHES OF FRAMES SHEWING POSITION AND DESCRIPTION OF WELDS OF FORGINGS, OR PARTICULARS OF TESTS APPLIED TO CASTINGS.

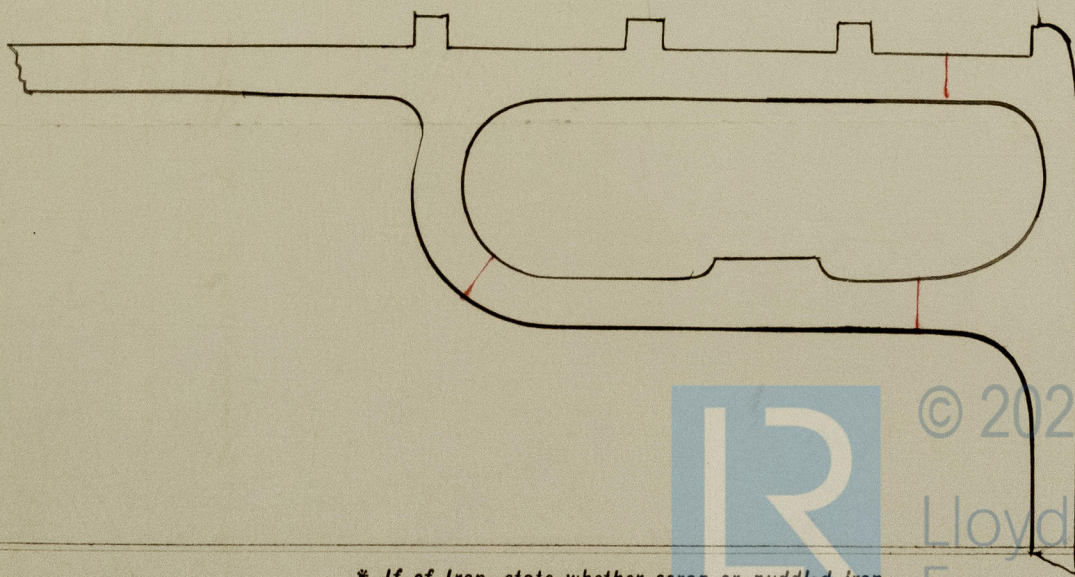

Ship Forging
Messrs. A. Hall & Co
S.S. No. 333
S.S. Bonaccord

SHIP FORGINGS OR CYCLINGS.

(Signed on behalf of)

For

General Manager of British and Foreign Shipping.



© 2021

Lloyd's Register
Foundation