

# Lloyd's Register of British and Foreign Shipping.

(Report on Vessel No. \_\_\_\_\_ Port \_\_\_\_\_)

No. 37

## SHIP FORGINGS OR ~~CASTINGS~~

I have to report that the undermentioned Iron or ~~Steel~~ Forgings or ~~Castings~~, manufactured by James Carmichael & Co. of Dundee for the Vessel No. 333, being built by Alexander Hall & Co. of Aberdeen have been inspected by me as set forth below, and found to be, so far as can be seen, in sound and efficient condition.

Mark on Forgings.

Lloyd's


No. 121

9/89. A.E.K.

R. Heydell  
Dundee

	STERN FRAME.	RUDDER FRAME.	STEM.
Material* - - -		<u>Scrap iron</u>	
How made - - -		<u>Forged</u>	
Dimensions - - -		<u>6 1/4" x 3 1/4"</u>	
Progress on Inspection -		<u>6 Sept. 11 Sept.</u>	
Dates when Inspected		<u>30 Sept. 1889</u>	

SKETCHES OF FRAMES SHEWING POSITION AND DESCRIPTION OF WELDS OF FORGINGS, OR PARTICULARS OF TESTS APPLIED TO CASTINGS.

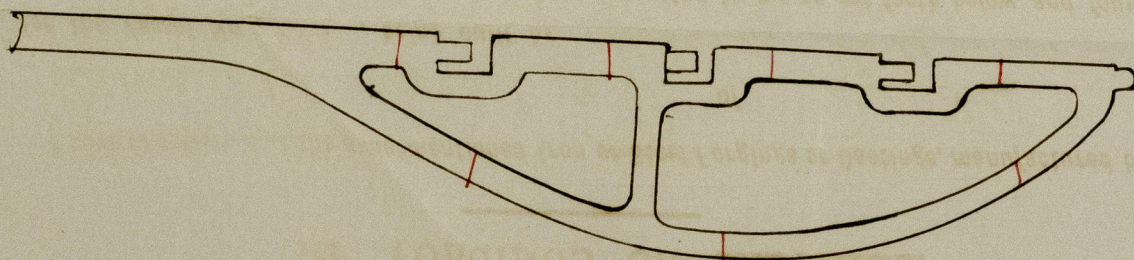



Ship Forging  
Messrs A. Hall & Co  
S. S. No 333  
S. S. Bonaccord.



© 2021

Lloyd's Register  
Foundation