


SPAR & MAIN DECK BEAM PLANS  
 OF  
 S. S. N° 264.  
 SCALE 1/4" = 1' 0"

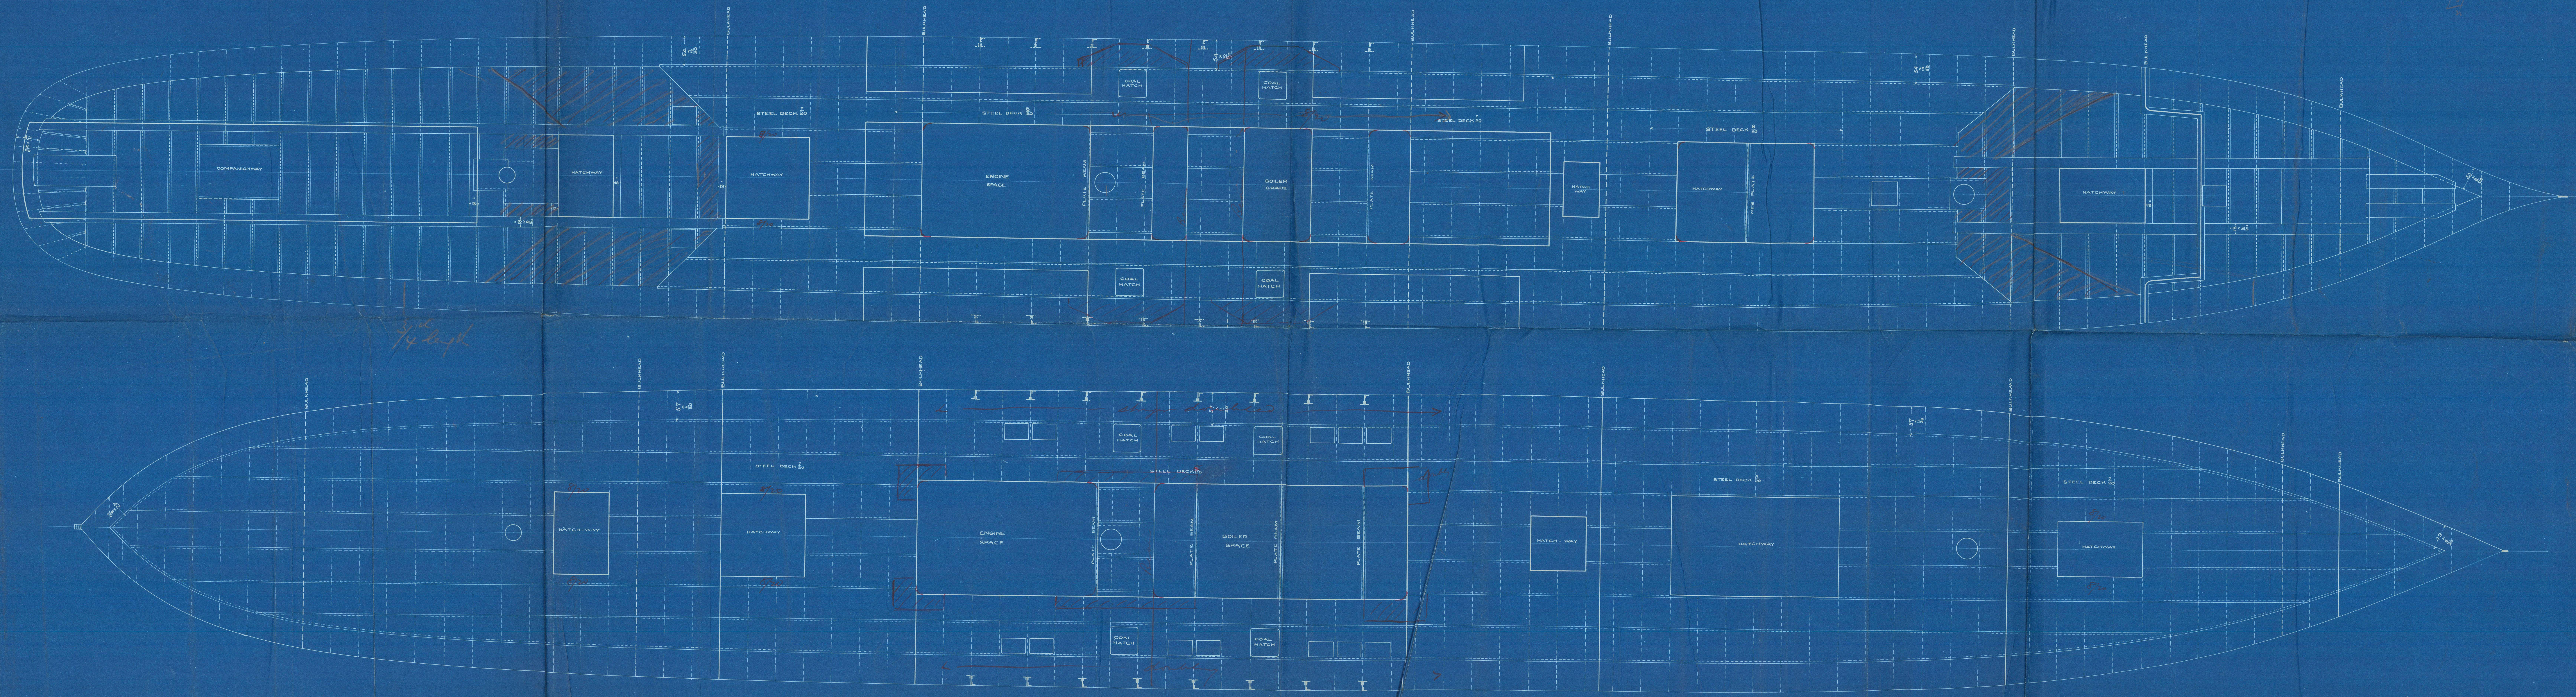



Spar & Main Deck Beam Plans  
Messrs. Hall Russell & Co.

S.S. No 264.  
S.S. "Thermopylae"  
Abn Rep No 4297.



ABN22-0009



© 2021

Lloyd's Register  
Foundation