

Lloyd's Register of British and Foreign Shipping.

(Report on Vessel No. _____ Port _____)

No. 41 SHIP FORGINGS ~~OR CASTINGS~~.

The words FORGINGS or CASTINGS, IRON or STEEL, should be struck out as may be required.

I have to report that the undermentioned Iron ~~or Steel~~ Forgings ~~or Castings~~, manufactured by James Carmichael & Co of Dundee for the Vessel No. 264, being built by Hall, Russell & Co of Aberdeen have been inspected by me as set forth below, and found to be, so far as can be seen, in round and efficient condition


Mark on Forgings.

Lloyd's
No. 152
1, 91. A.E.H.


A. Keydell
Dundee

	STERN FRAME.	RUDDER FRAME.	STEM.
Material*	<u>Scrap</u>		
How made	<u>Forged</u>		
Dimensions	<u>11 1/2" x 7"</u>		
Progress on Inspection	<u>Finished</u>		
Dates when Inspected	<u>{ 27 Sept. 5 Nov. 8 Nov. 22 Dec. 3 Jan. 21 Jan. 26 Jan. 28 Jan.</u>		

SKETCHES OF FRAMES SHEWING POSITION AND DESCRIPTION OF WELDS OF FORGINGS, OR PARTICULARS OF TESTS APPLIED TO CASTINGS.

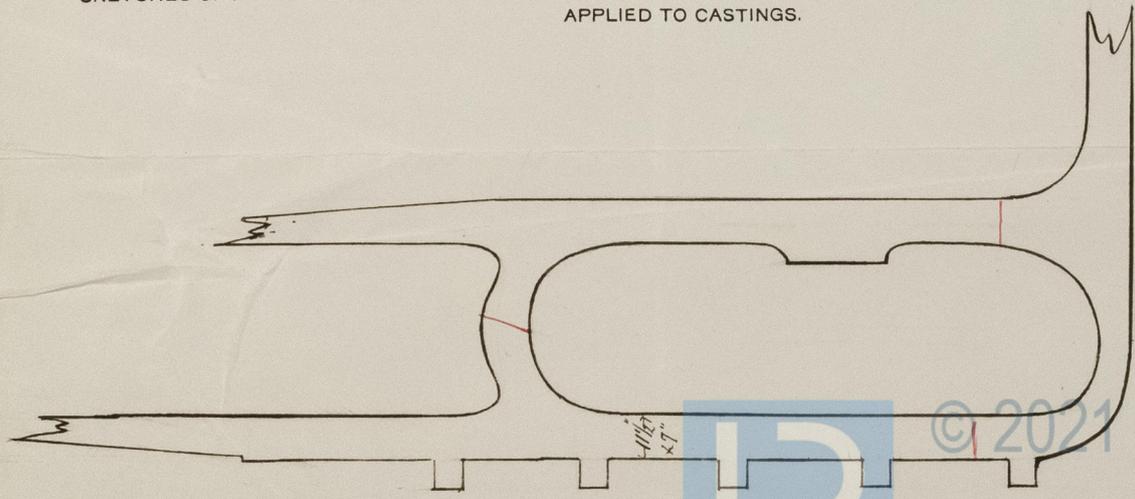

* If of Iron, state whether scrap or puddled Iron

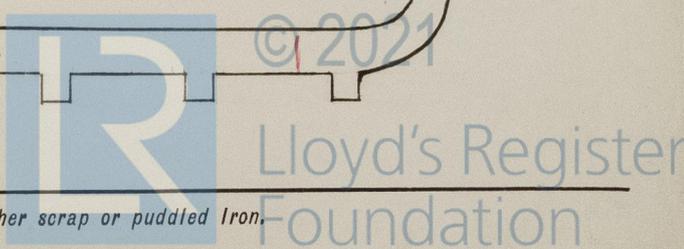

Ship. Yorging
Messrs Hall Russell & Co
S.S. V^o 264

S. S. Thermopylae
Abn No 4297.



© 2021

Lloyd's Register
Foundation