

Lloyd's Register of British and Foreign Shipping.

(Report on Vessel No. _____ Port _____)

No. 98.

SHIP FORGINGS ~~OR CASTINGS~~.

I have to report that the undermentioned Iron or Steel Forgings or Castings, manufactured by

James Carmichael & Co. of Dundee
for the Vessel No. 264, being built by Hall, Russell & Co.of Aberdeen have been inspected by me as set forth below, and found
to be, so far as can be seen, in sound and efficient

condition.


Mark on Forgings.

Lloyd's

No. 174.
5/91. A.E.R.R. Kydell
Dundee

	STERN FRAME.	RUDDER FRAME.	STEM.
Material* - - - -		Scrap	
How made - - - -		Forged	
Dimensions - - - -		9" dia	
Progress on Inspection -		Finished	
Dates when Inspected		22 nd April 8 th 14 th + 29 th May 1891.	

SKETCHES OF FRAMES SHEWING POSITION AND DESCRIPTION OF WELDS OF FORGINGS, OR PARTICULARS OF TESTS APPLIED TO CASTINGS.

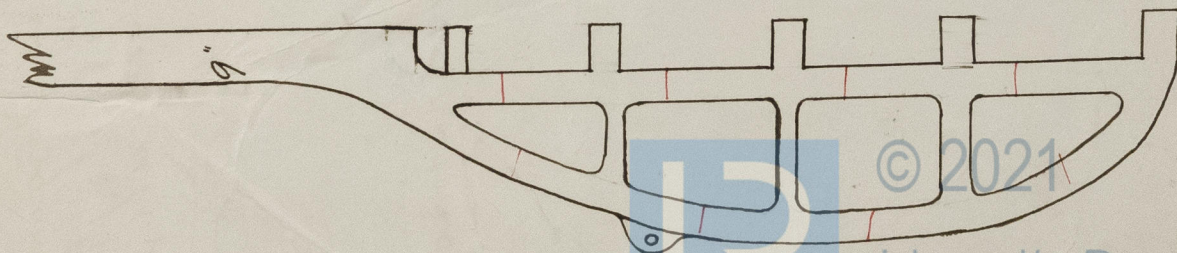

Ship Gorgings.
Messrs Hall Russell & Co
S.S. No 264

S.S. "Thermopylae."
Abn No 4297



© 2021

Lloyd's Register
Foundation