

Lloyd's Register of British and Foreign Shipping.

(Report on Vessel No. _____ Port _____)

The words FORGINGS or CASTINGS, IRON or STEEL, should be struck out as may be required.

No. ~~177~~ SHIP FORGINGS ~~OR CASTINGS.~~

I have to report that the undermentioned Iron ~~or Steel~~ Forgings ~~or Castings~~, manufactuerd by Jas Carmichael & Co of Dundee for the Vessel No. 344, being built by Alex Hall & Co of Aberdeen have been inspected by me as set forth below, and found to be, so far as can be seen, sound


Mark on Forgings.

Lloyd's
No. 251
H.C. 11/92

Harry Clarke
Dundee

	STERN FRAME.	RUDDER FRAME.	STEM.
Material*	Scrap Iron	Scrap Iron	No entry
How made	Forged	Forged	
Dimensions	6" x 2 1/2"	6" x 2 1/2"	
Progress on Inspection	Finished	Finished	
Dates when Inspected	Nov 3rd 1892	Nov 3rd 1892	

SKETCHES OF FRAMES SHEWING POSITION AND DESCRIPTION OF WELDS OF FORGINGS, OR PARTICULARS OF TESTS APPLIED TO CASTINGS.

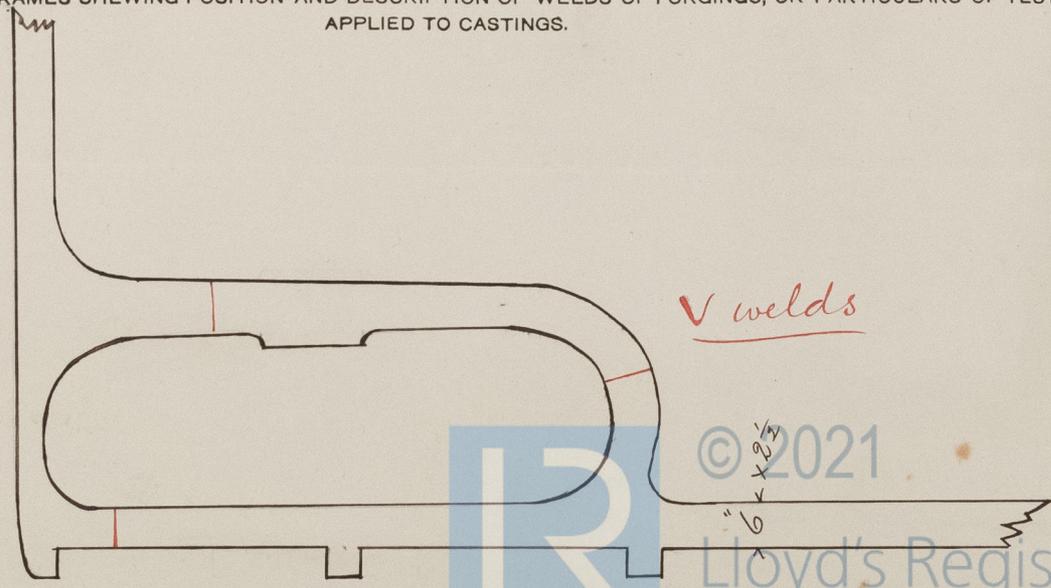

V welds

© 2021

Lloyd's Register Foundation

* If of Iron, state whether scrap or puddled Iron.

Ship Forging ^{Abn}

Messrs A Hall & Co.

S. S. No 344

S. S. Hermes

Lloyd's Register of British and Foreign Shipping

No.

ENGINE FORGINGS OR CASTINGS

For the purpose of

FORGINGS

OF

CASTINGS



© 2021

Lloyd's Register
Foundation