

SHIP & BOAT
BUILDERS,
PETERHEAD





Stem Oak sided $8\frac{1}{2}$ " moulded 12" & Stemson 8" m. $8\frac{1}{2}$ "
Deadwood & Neel Knee Oak 3' 9". S. Post Oak moulded 8" &
sided at tube 19". Deadwood Oak & P. Line sided 9' 4" 20"
Deckbeams Larah 4' 7" to $5\frac{1}{2}$ " at ends, fastened
from forward to foremast with wood Lodging knees, aft
with wood Lodging knees, amidship Galls Binders & hang-
ing knees.

^{Ret}
Midship Section

Messrs. Forbes & Birnie

S. S. No. 82.

S. S. Pioneer

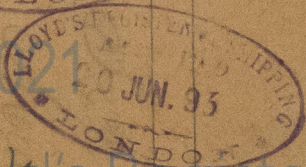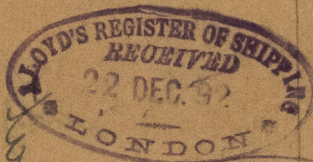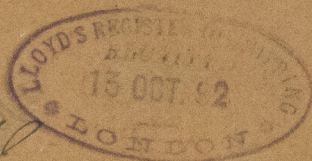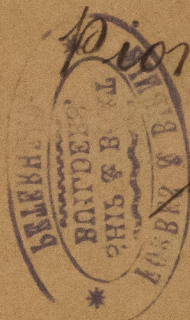


ABU23 - 0052




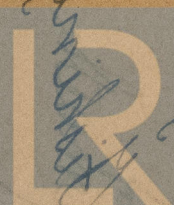

Lloyd's Register
Foundation