

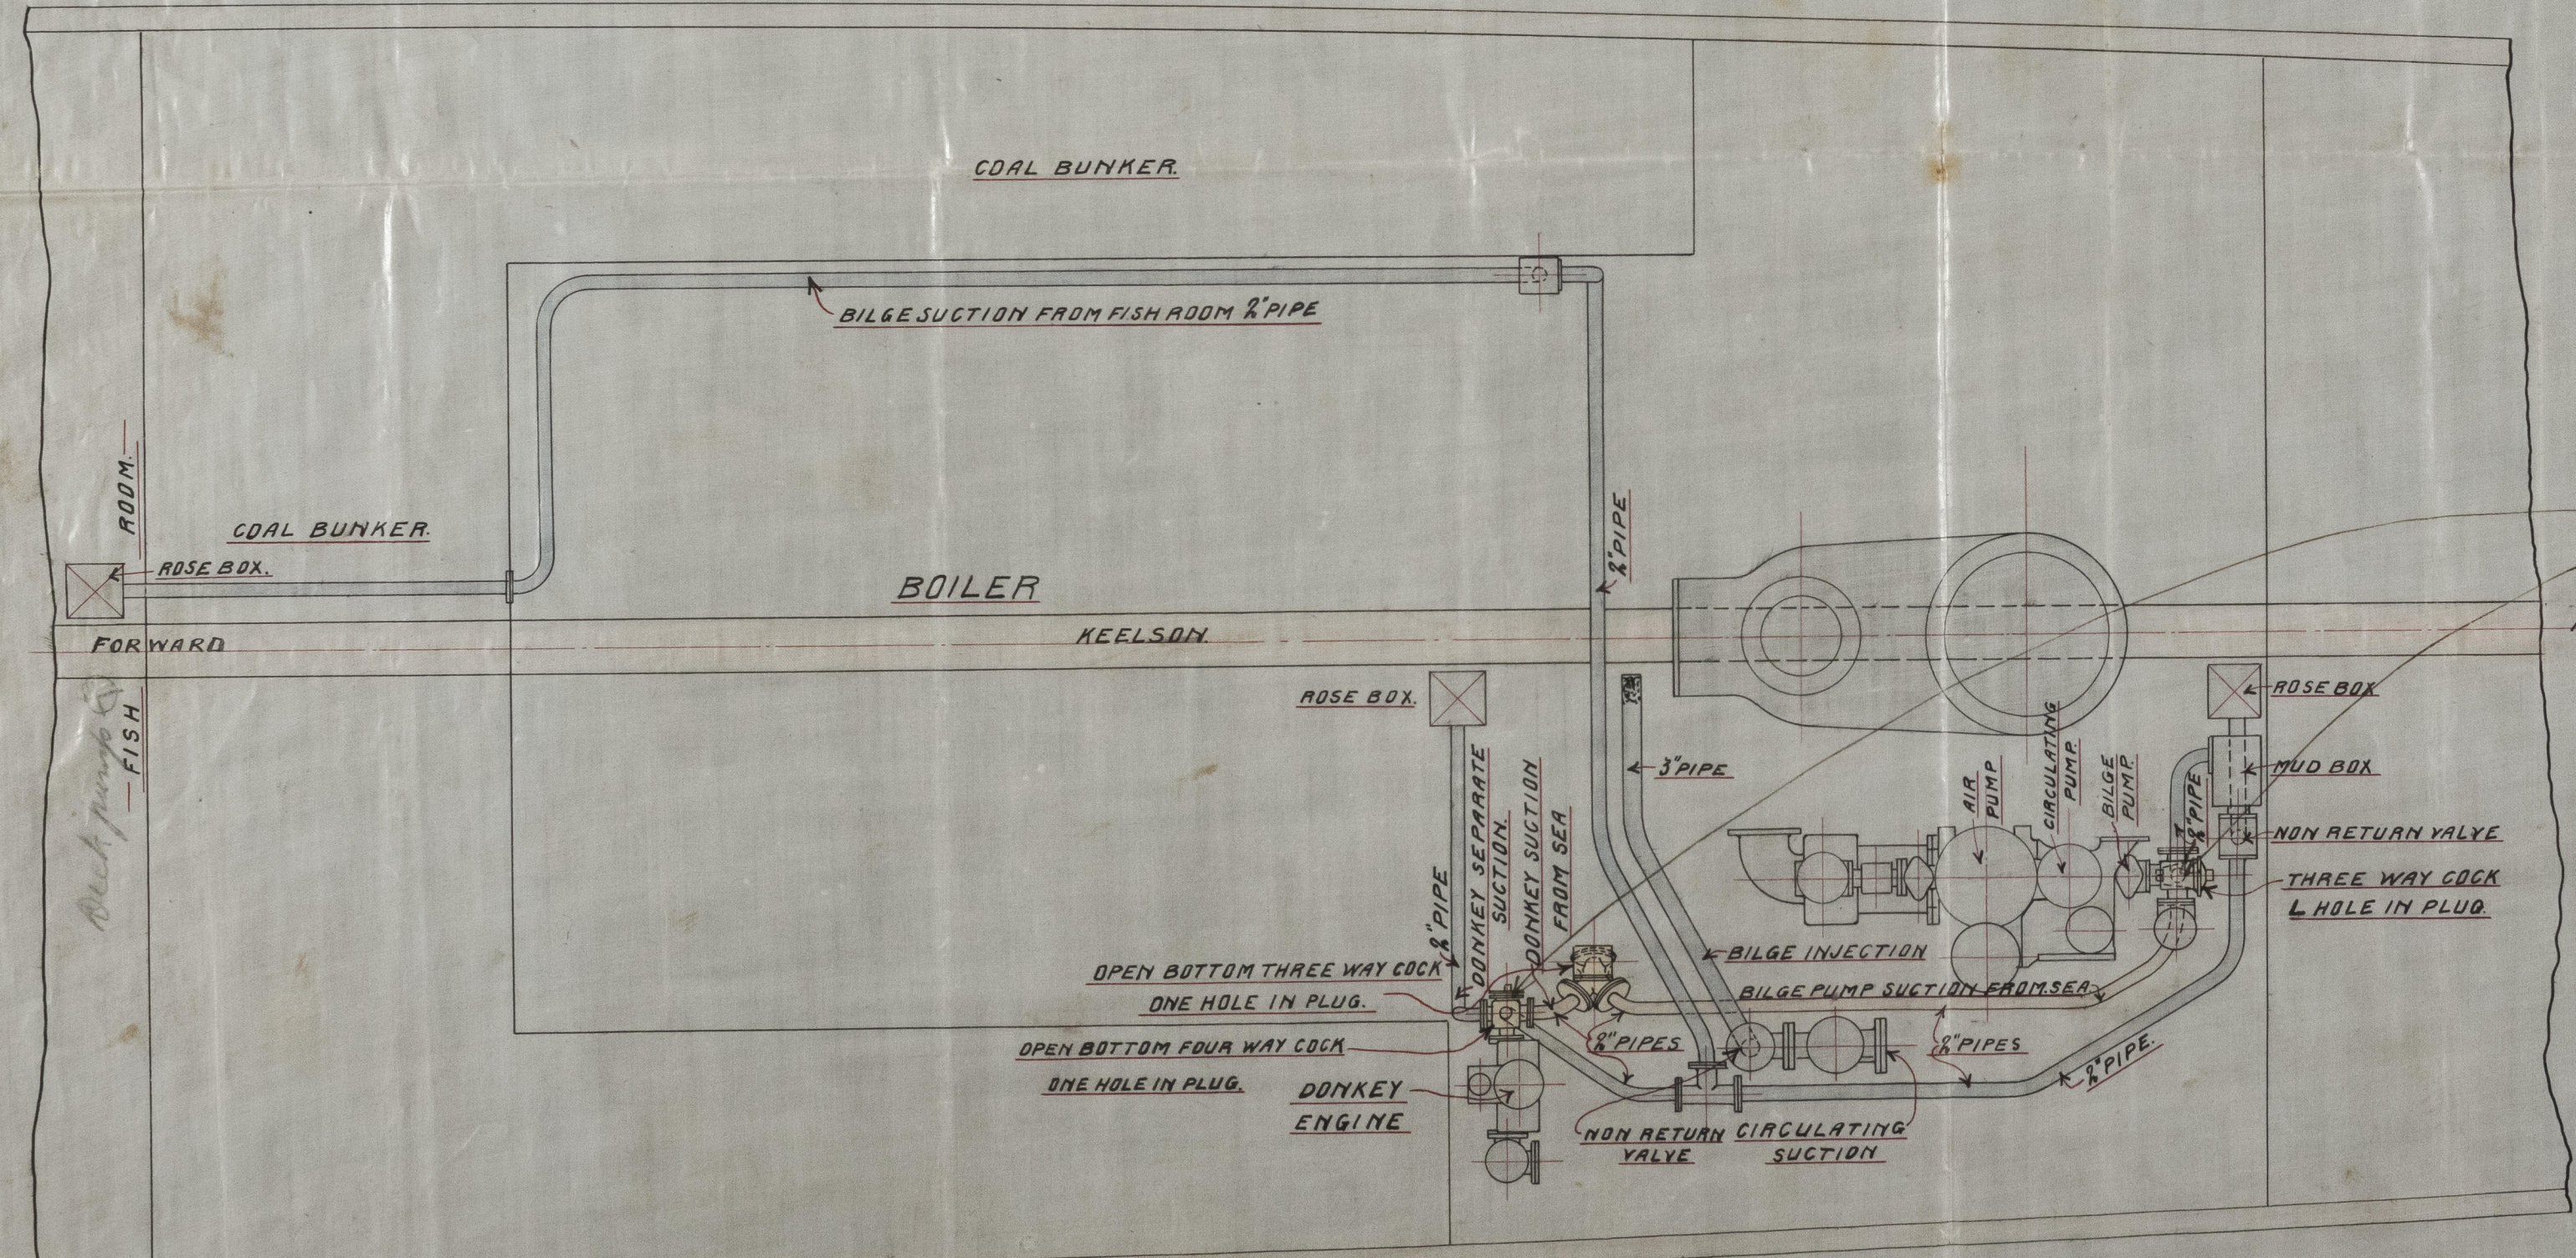


21.6.93
Donkey engine
Donkey engine
Donkey engine

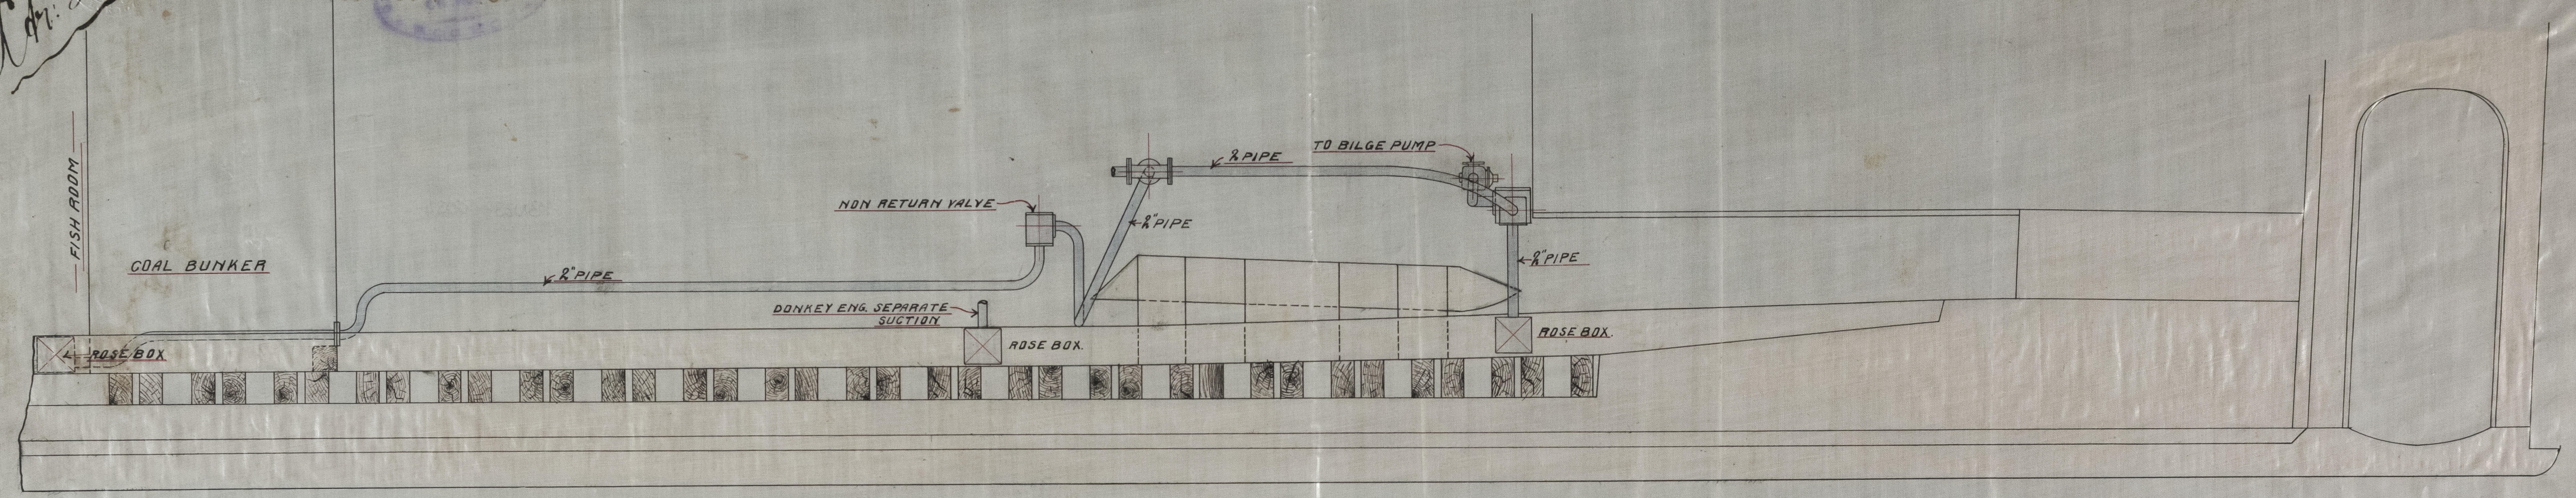

provided the distance between the branches, on the shells of these suction cocks, be greater than the breadth of the Port in the plug. thus

PUMPING ARRANGEMENT
ENGINES. N^o 3-93. SHIP. N^o 82
SCALE - 1/2 INCH TO THE FOOT

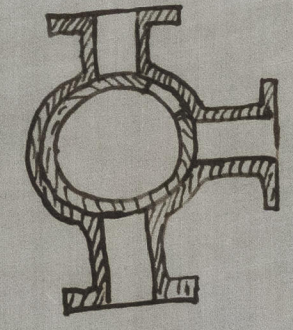


a hand pump to be supplied to the vessel.

N.A.
20.6.93


Pumping Arrangement^{abr}
Messrs Hall Russell & Co.

S. S. No 3/93.

S. "Pioneer"

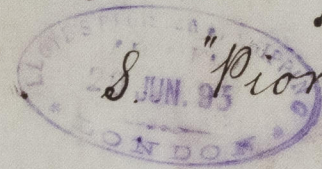

11.12.93

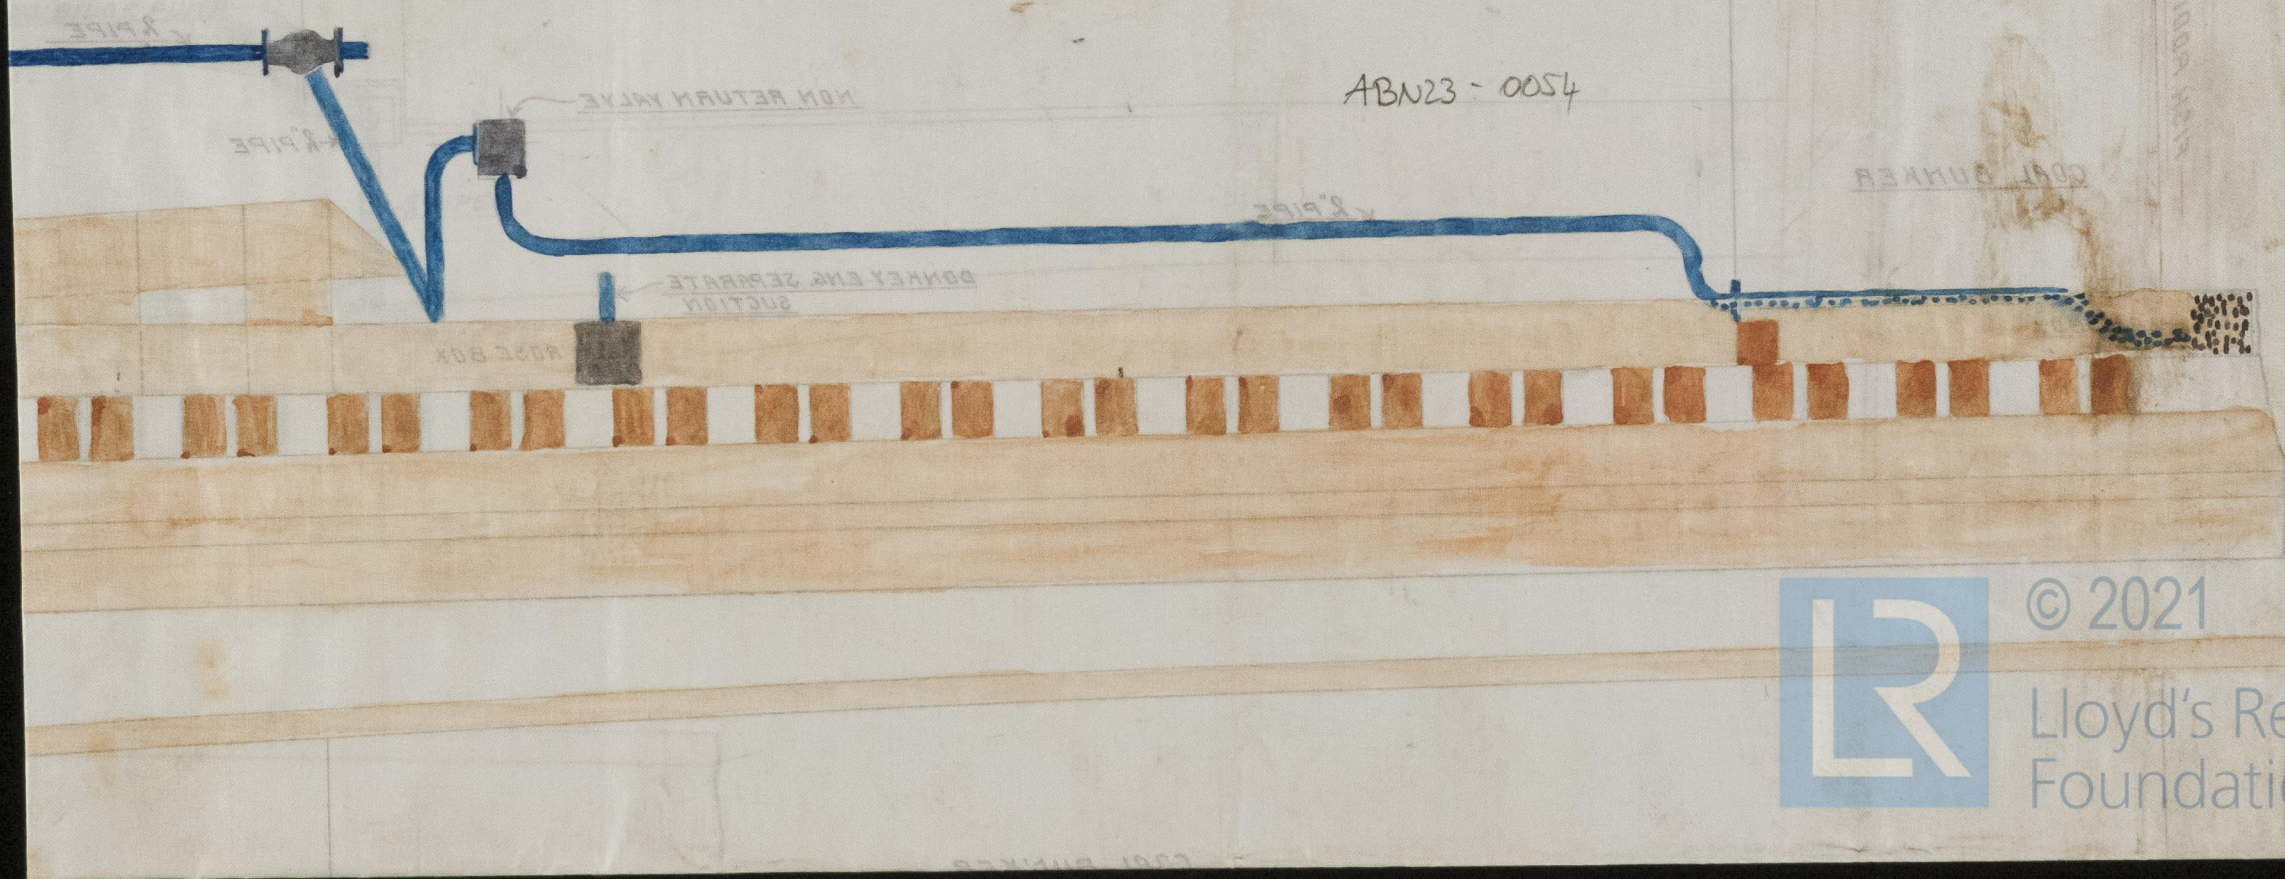

© 2021

Lloyd's Register
Foundation