


sketch showing thickness
of shell plating

S. B. Sanit-Place

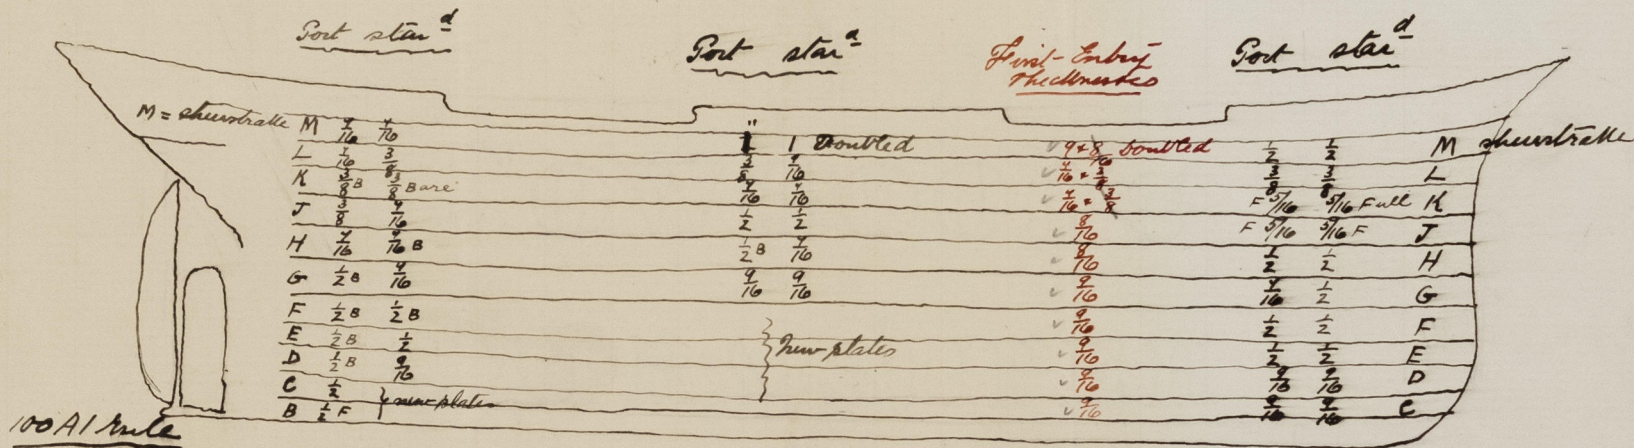

$$A = \frac{968}{16} \text{ Garboard}$$

$$\left. \begin{array}{l} B \\ C \\ D \\ E \\ F \\ G \\ H \\ J \\ K \end{array} \right\} \frac{854}{16}$$

$\frac{L}{M} = \frac{10 \text{ to } 8}{16}$ soulted $\frac{3}{4}$ length annids helps

Compared with 100 AI ships

present-rules-

$$\frac{1}{2} \text{ mid thigh girth} = 25.75$$

$$\frac{1}{2} \text{ break} = 12.25$$

Depth = 15.59

$$\begin{array}{r} 54 \cdot 59 \text{ first number} \\ 199 \\ \hline 10863 \cdot 41 \text{ second number} \end{array}$$

4.5 Breadths

4.01 Septis

© 2021

6/6/95-

ABN 24 - 0098