

Lloyd's Register of British and Foreign Shipping.

(Report on Vessel No. _____ Port _____)

Aberdeen

No. 3035 a. SHIP FORGINGS OR CASTINGS.

I have to report that the undermentioned Iron or Steel Forgings or Castings,
manufactured by *The Darlington Forge Co.*

of *Darlington* for the Vessel No. _____, being built
by *S.S. "Saint Clair"* of *Aberdeen*.

have been inspected by me as set forth below, and found to be, so far as can be seen,
sound.

Mark on Forgings.

Lloyd's

No. 3035 a

No. 6.


*Wm Cameron**Sunderland*

21. 5. 95

	STERN FRAME.	RUDDER FRAME.	STEM.
Material* ...	<i>Scrap iron</i>	<i>Scrap iron</i>	
How made ...	<i>Forged</i>	<i>Forged</i>	
Dimensions ...	<i>7 1/2 x 4 1/2</i>		
Progress on Inspection	<i>Smithed</i>	<i>Forged Smithed</i>	
Date when Inspected	<i>May 8-14/95</i>	<i>May 14.17-20/95</i>	

SKETCHES OF FRAMES SHOWING POSITION AND DESCRIPTION OF WELDS OF FORGINGS, OR PARTICULARS OF
TESTS APPLIED TO CASTINGS.

>
Welds

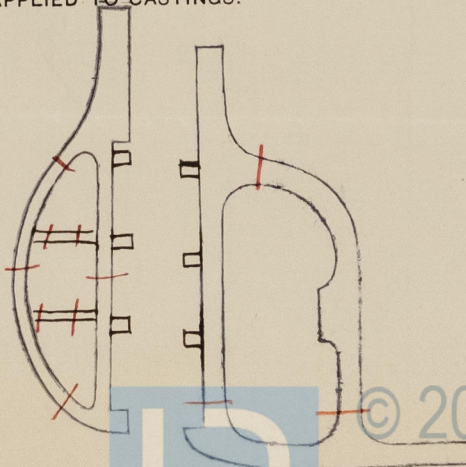

Fee (if any chargeable) £ 2 : 2 : 0

To be paid at

* If of Iron, state whether scrap or puddled Iron.