



"S. S. ST CLAIR"

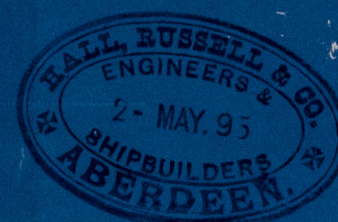


PROPOSED ALTERATION TO POOP

SCALE  $\frac{1}{4}$  IN = 1 FOOT


$25.0 -$   
 $13.25 -$   
 $14.25 -$   
 $53.00 = 124$   
 $200$   
 $106.00 = 274$

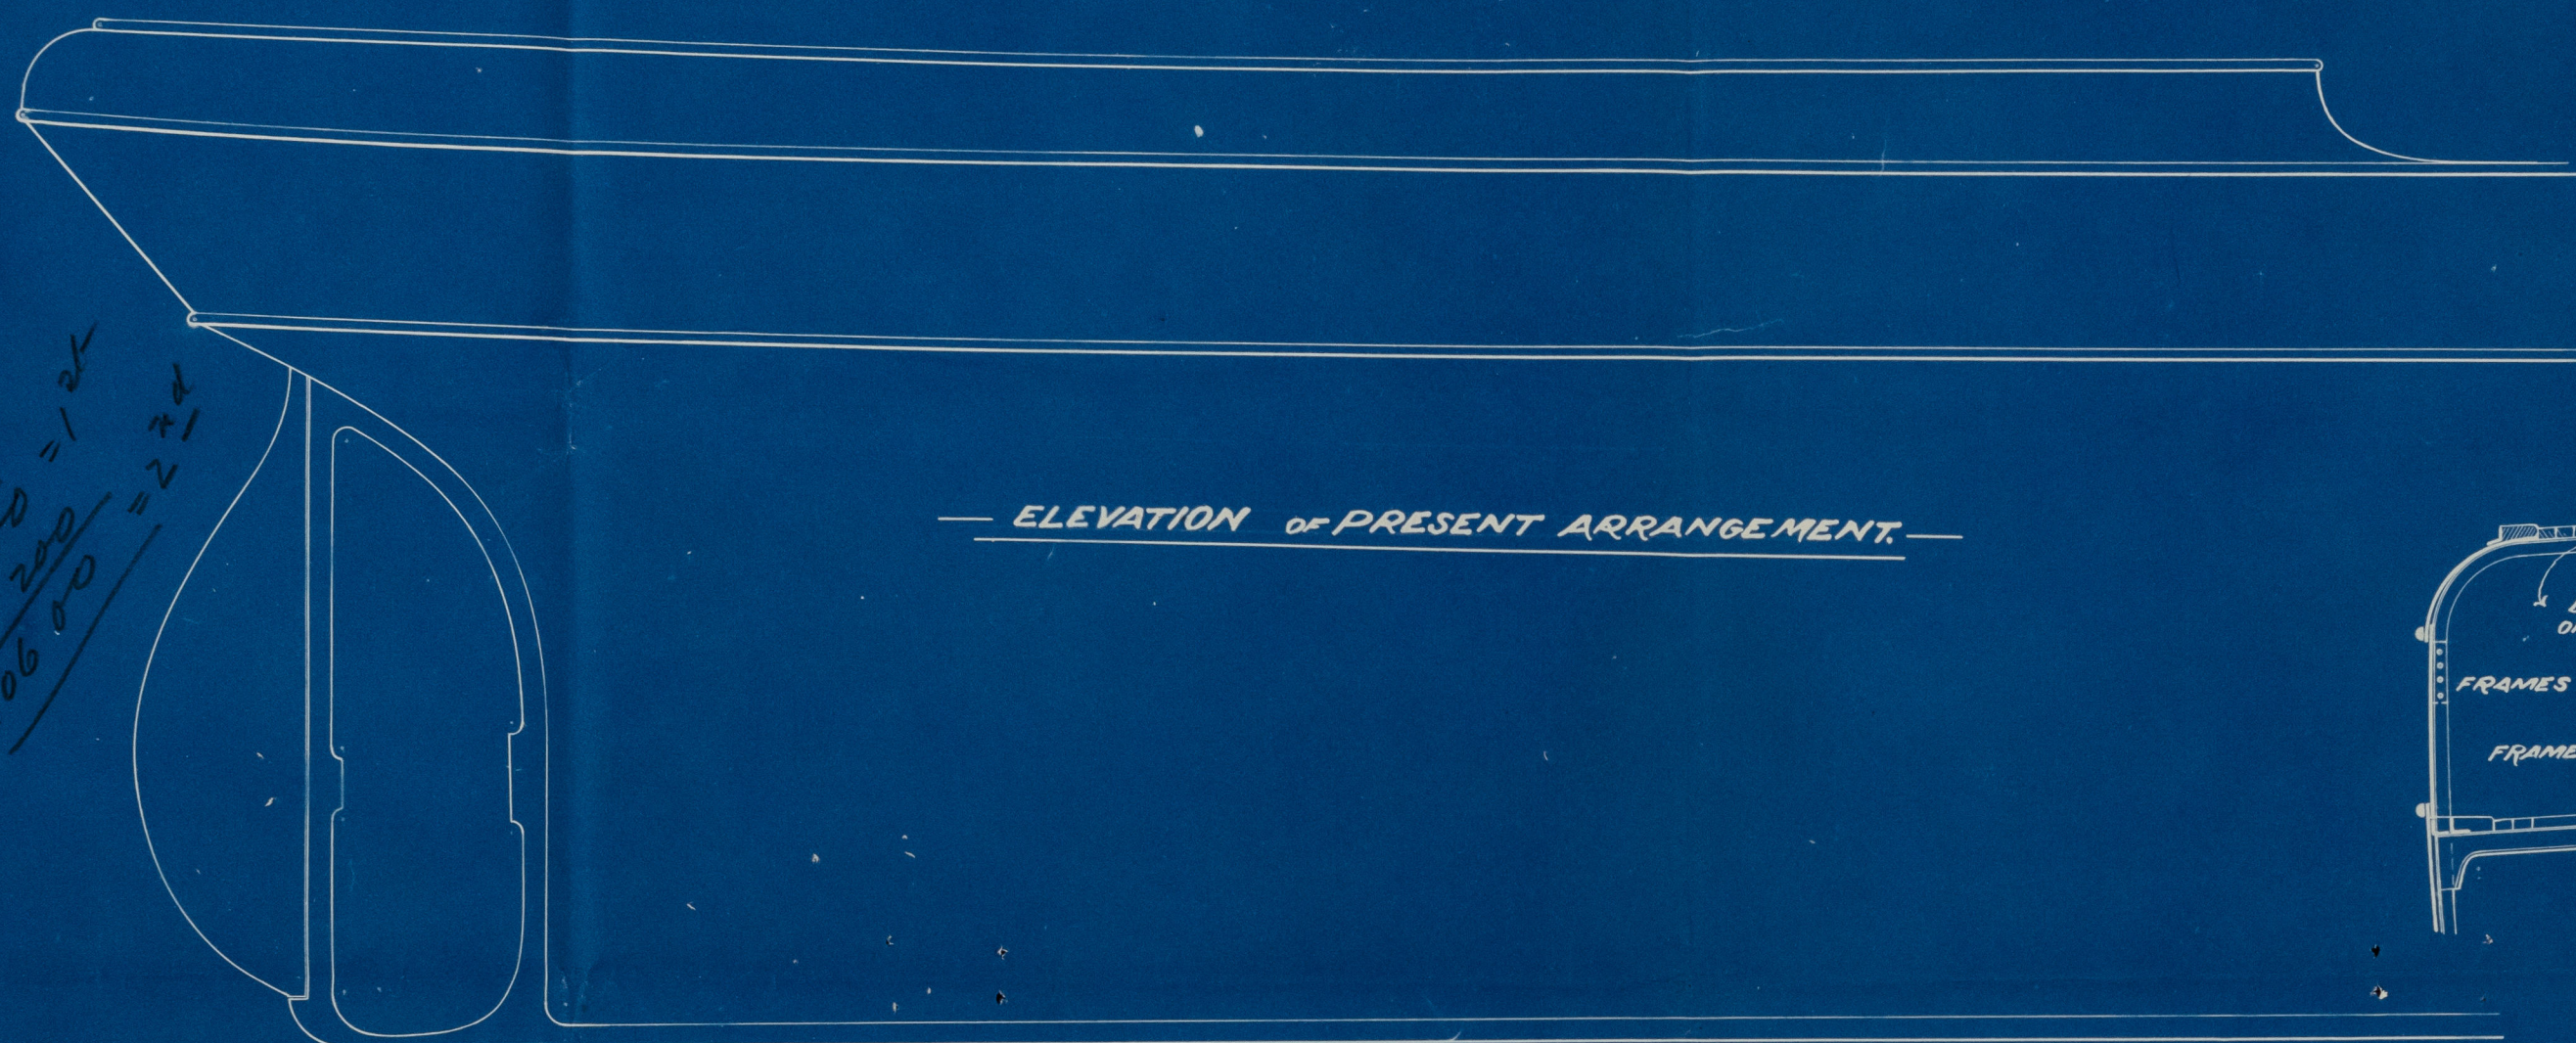


ELEVATION of PRESENT ARRANGEMENT.

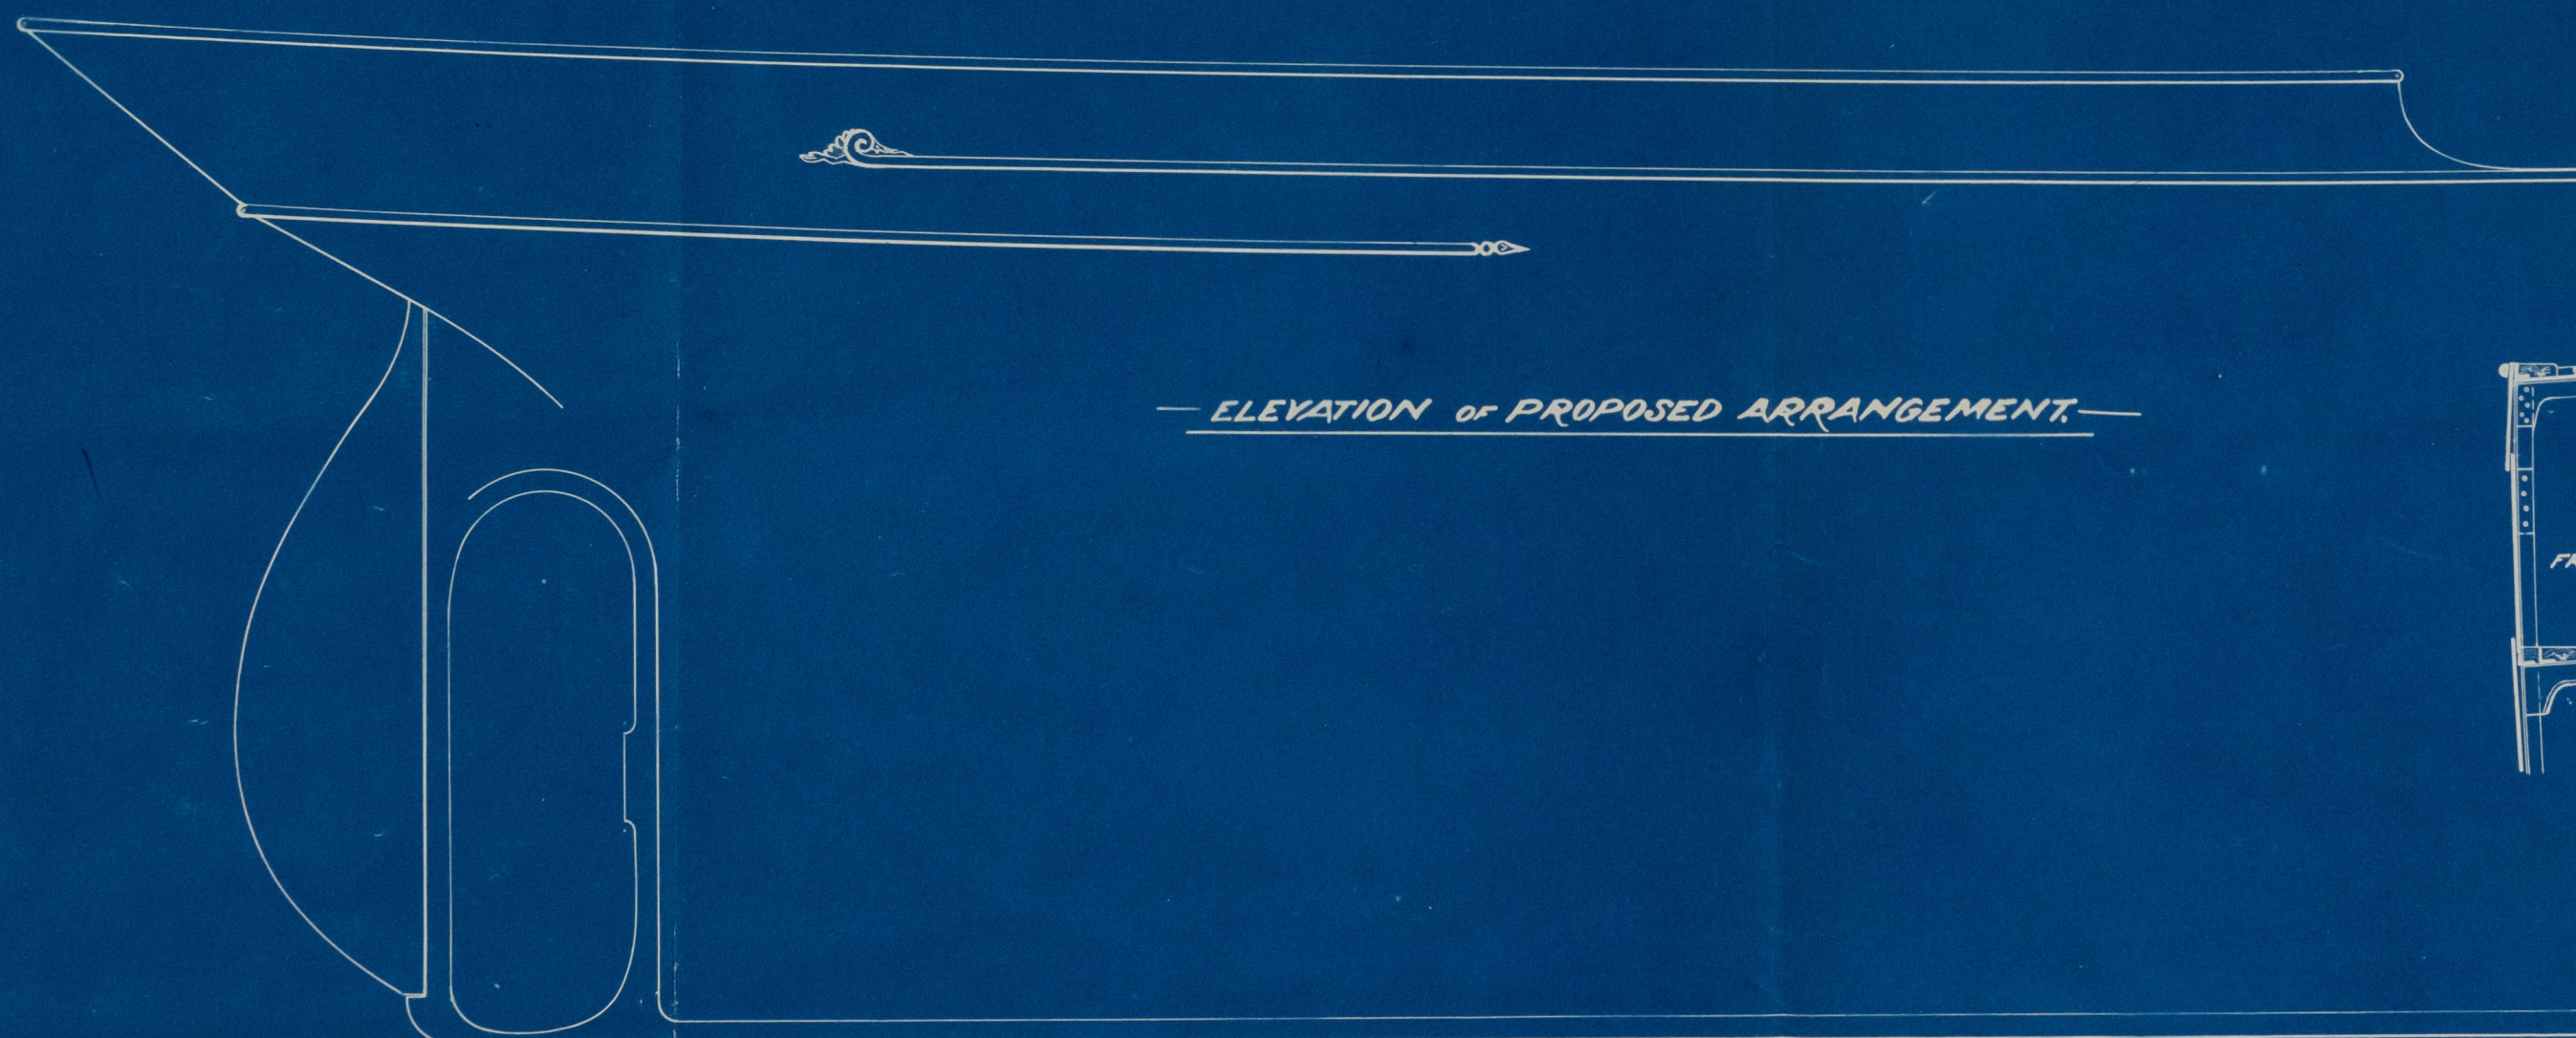

ELEVATION of PROPOSED ARRANGEMENT.

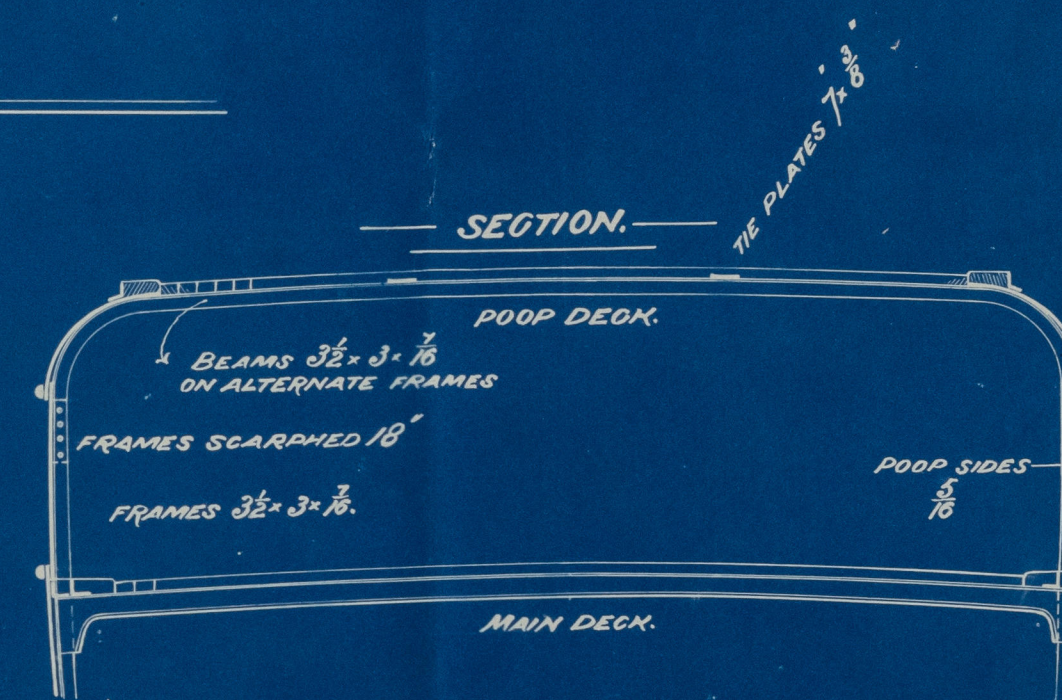


SECTION.

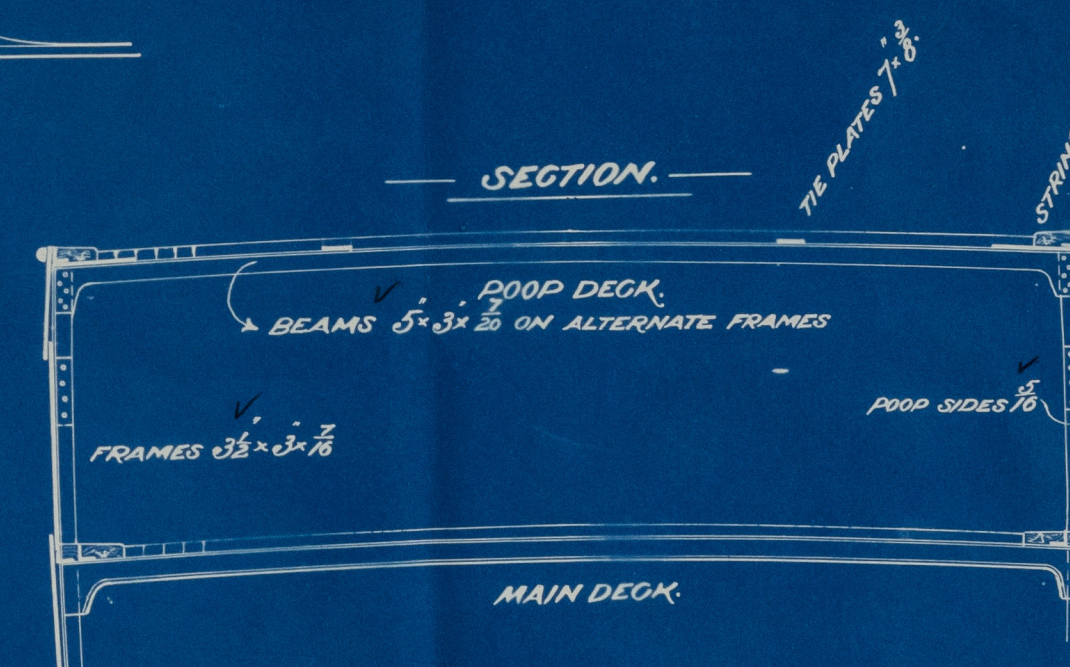

SECTION.

2/5/95

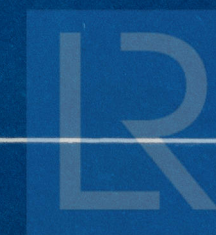

ABN24-0109