

# Lloyd's Register of British and Foreign Shipping.

(Report on Vessel No. \_\_\_\_\_ Port \_\_\_\_\_)

## No. 323 SHIP FORGINGS OR CASTINGS.

I have to report that the undermentioned Iron ~~or Steel~~ Forgings or Castings, manufactured by *James Carmichael & Co. (lim.)* of *Dundee* for the Vessel No. *295*, being built by *Hall, Russell & Co.* of *Aberdeen* ~~has~~ been inspected by me as set forth below, and found to be, so far as can be seen, *sound*

The words FORGINGS or CASTINGS, IRON or STEEL, should be struck out as may be required.


Mark on Forgings.

Lloyd's  
No 424  
11/95 J.S.

*Jo. Thomson*  
*Dundee*

	STERN FRAME.	RUDDER FRAME.	STEM.
Material* ...	/	<i>Scrap Iron</i>	/
How made ...		<i>Forged</i>	
Dimensions ...		<i>Head 3 1/2. Heel 2 1/2 x 2 1/4</i>	
Progress on Inspection ...		<i>Forging &amp; finished.</i>	
Date when Inspected ...		<i>17<sup>th</sup> Oct. &amp; 23<sup>rd</sup> Nov. 1895</i>	

SKETCHES OF FRAMES SHOWING POSITION AND DESCRIPTION OF WELDS OF FORGINGS, OR PARTICULARS OF TESTS APPLIED TO CASTINGS.

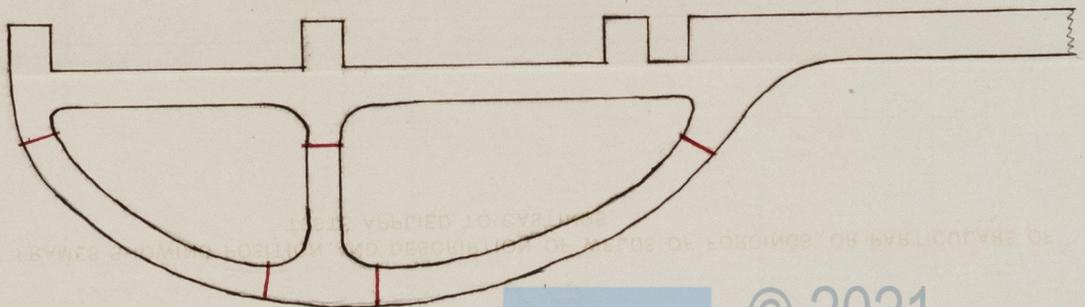

Fee (if any chargeable) £ ✓ : :

To be paid at ✓



© 2021

Lloyd's Register Foundation

\* If of Iron, state whether scrap or puddled Iron.

Rudder Frame

Hall Russell's

Dis. No 295

Dis. Craig Mackie



© 2021

Lloyd's Register  
Foundation