


PUMPING ARRANGEMENT

NOTE:- THE SUCTION COCK FOR EJECTOR TO HAVE THE DISTANCE
BETWEEN THE BRANCHES GREATER THAN THE BREADTH
OF THE PORT IN THE PLUG THUS:-




— OF —
S.S. N° 295-G.

SCALE $\frac{1}{4}$ " = 1 FOOT

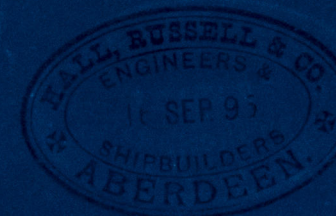

NOTE:- DONKEY ENGINE CAN ALSO
BE USED AS A HAND PUMP.

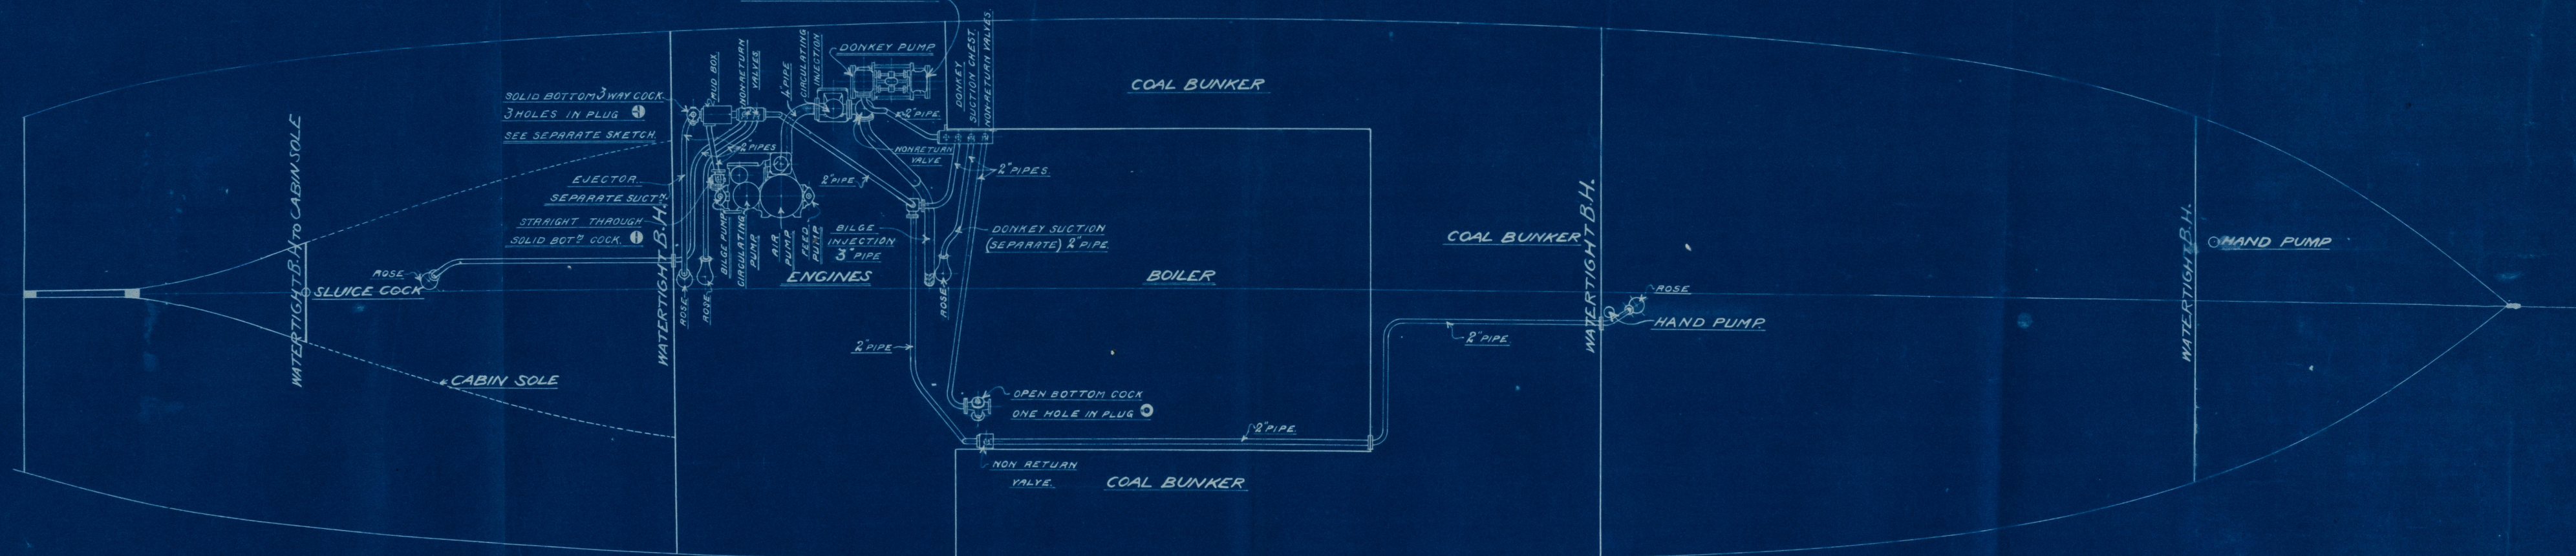

ABN24 - 071


17/9/95

Pumpung' Arrangement
Prof. Hall Russell. Co
D. O. No 29546

D. O. Craigellachie 295
D. O. Craig' Jowen 296

Abn. no. 5120.

ABN24-0171

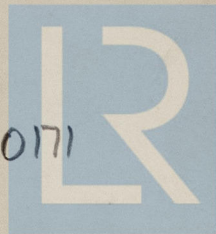

© 2021

Lloyd's Register
Foundation