

COYD'S REGISTER
28.8.95


MIDSHIP SECTION OF STEEL SCREW FISHING VESSEL

N^{OS} 295 AND 6

— DIMENSIONS —


LENGTH TWIXT PERPENDICULARS-----	90.0	LENGTH PER RULE-----	89.08
BREADTH MOULDED-----	19.6	BREADTH " "-----	19.5
DEPTH IN HOLD TO FLOORS-----	10.0	DEPTH " "-----	10.91
BREADTHS IN LENGTH-----	4.5	DEPTH IN LENGTH-----	8.1
NUMBERS FOR SCANTLING $9.75 + 10.91 + 16.29 = 36.95 \times 89.08 = 3291.5$			

— 100 A. GRADE.—

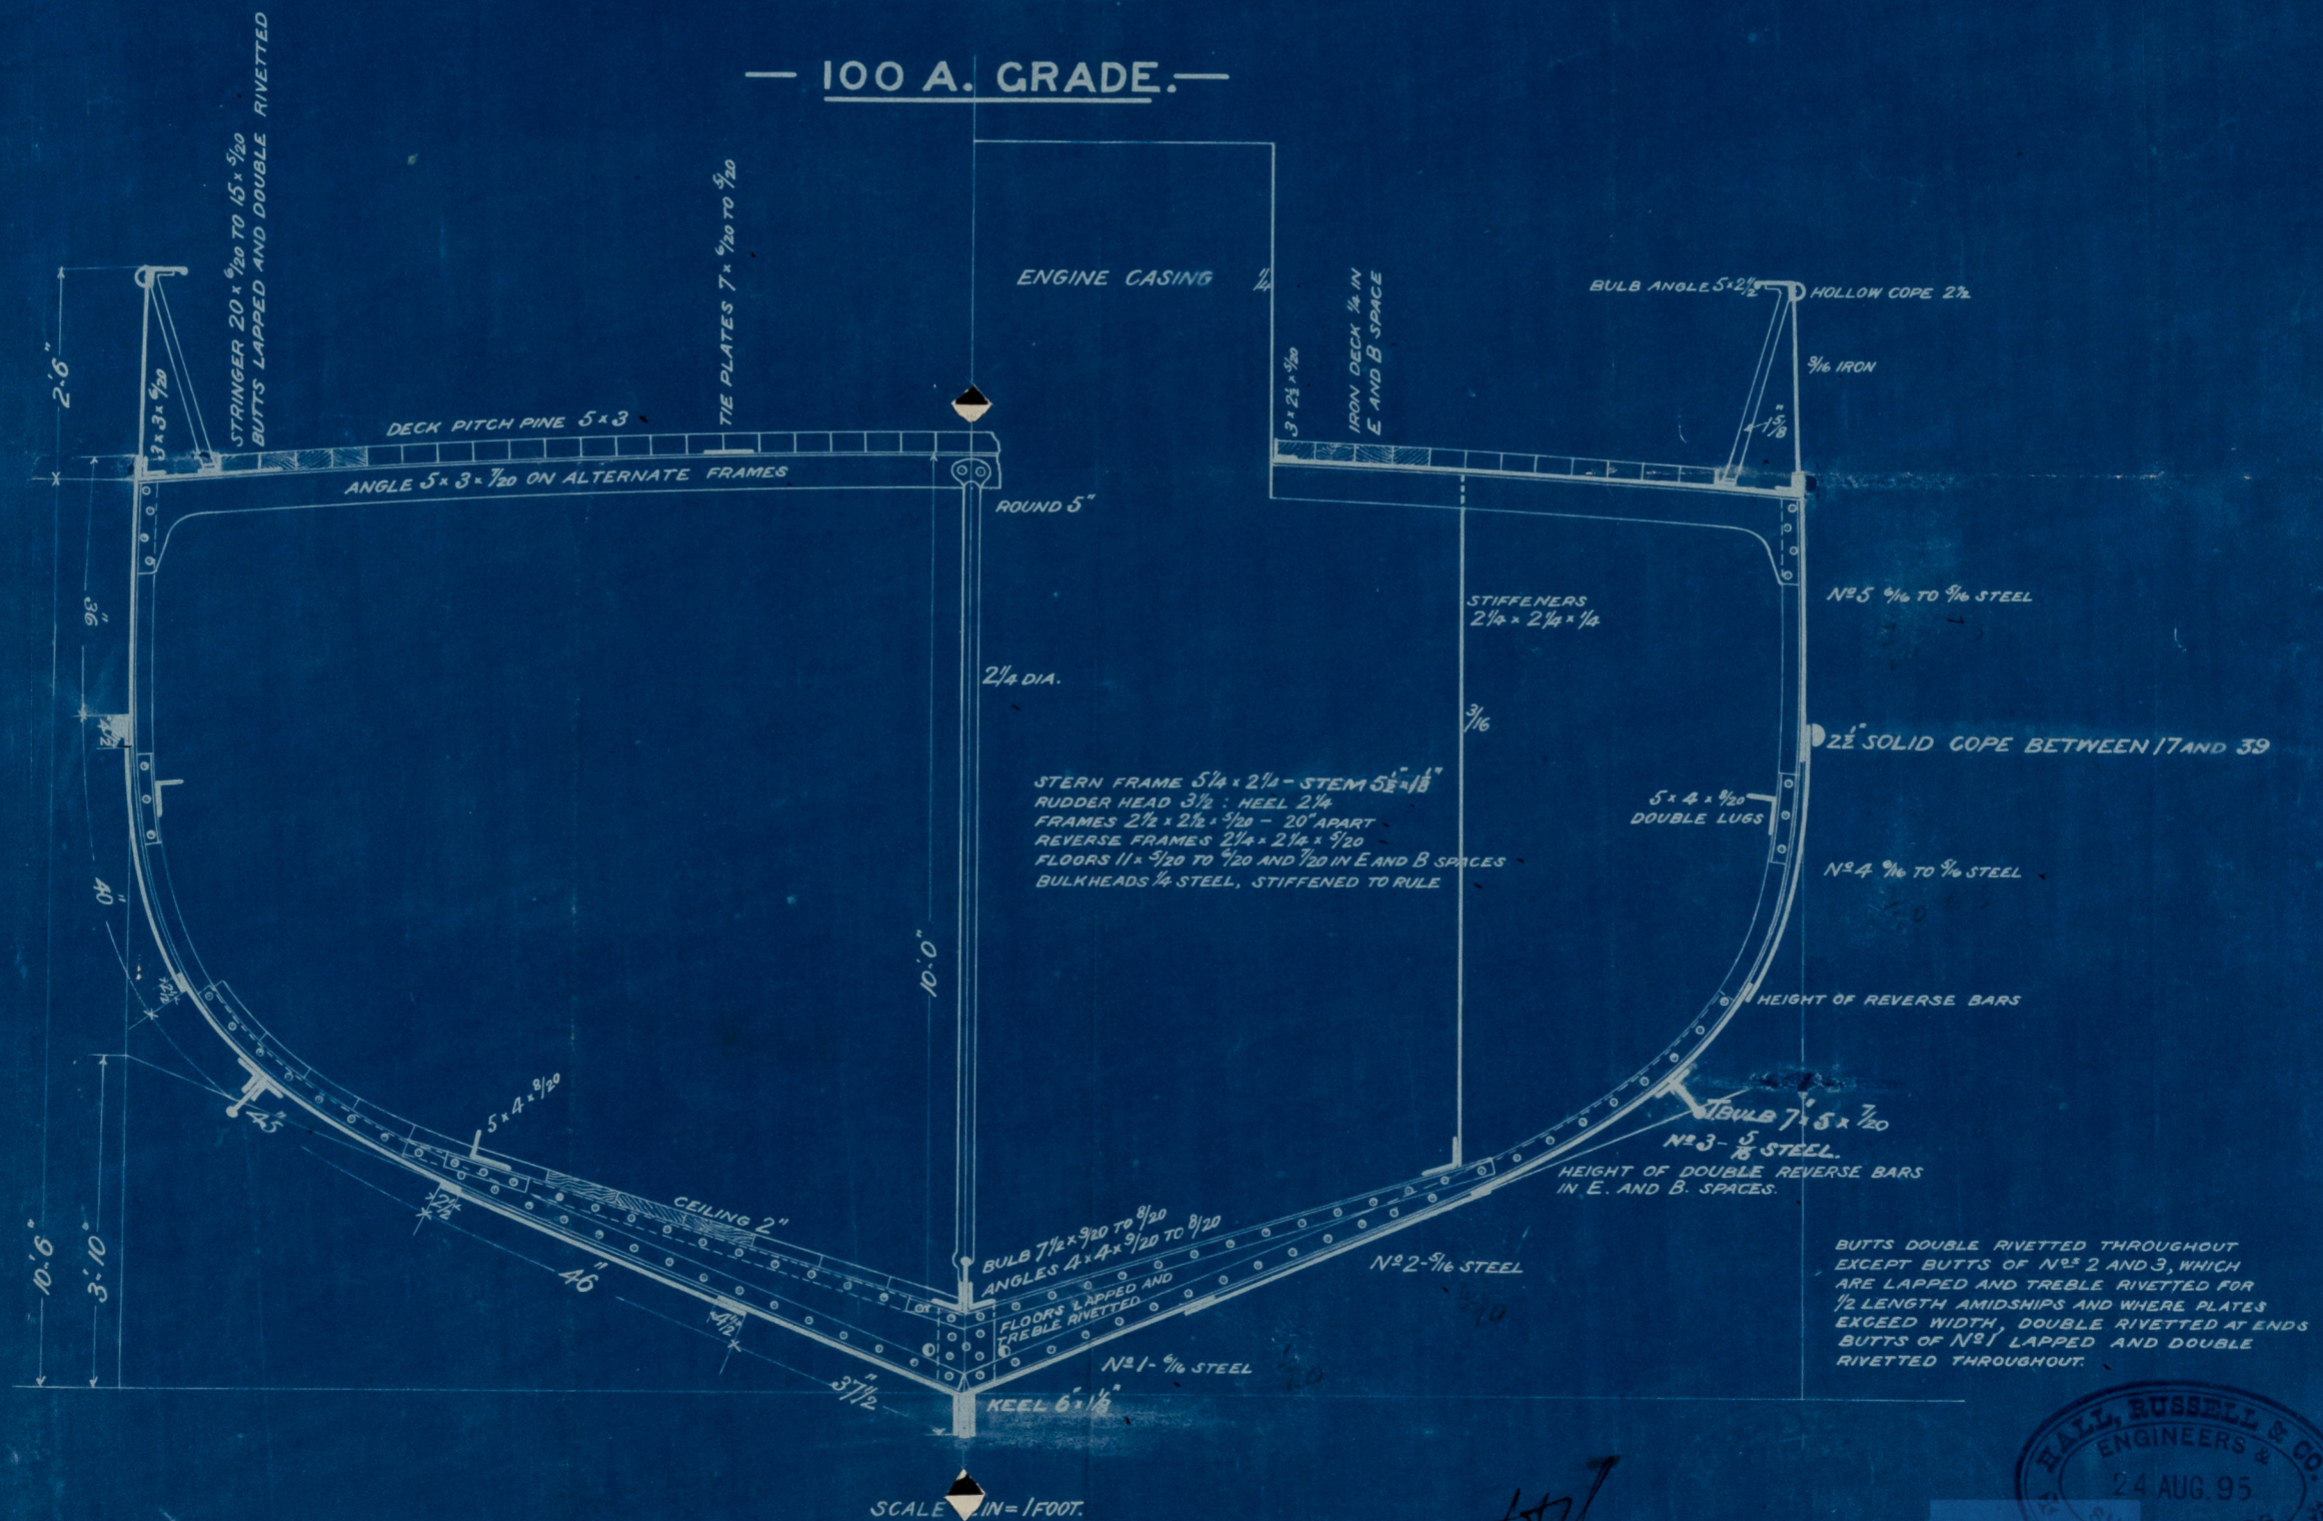

HALL, RUSSELL & CO.
ENGINEERS & CO.
24 AUG. 95
SHIPBUILDERS
GLASGOW & ABERDEEN.

ABW24-0113

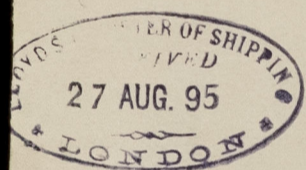


Shipping Section
Messrs Hall Russell
& Co
S.S. No 295-6



S.S. Craigellachie
No 295-

S.S. Craig Gowan
No 296

Abm no. 5120.

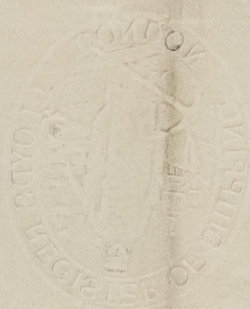

ABN24-0173



© 2021

Lloyd's Register
Foundation