

Lloyd's Register of British and Foreign Shipping.

(Report on Vessel No. _____ Port _____)

No. 351

SHIP FORGINGS OR CASTINGS.

The words FORGINGS or CASTINGS, IRON or STEEL, should be struck out as may be required.

I have to report that the undermentioned Iron ~~or Steel~~ Forgings or Castings,
 manufactured by *James Carmichael & Co. (Lim.)*
 of *Dundee* for the Vessel No. *359*, being built
 by *A. Hall & Co.* of *Aberdeen*
 have been inspected by me as set forth below, and found to be, so far as can be seen,
sound

Mark on Forgings.

Lloyd's


No. 449

J. J.

J. Thomson
Dundee

	STERN FRAME.	RUDDER FRAME.	STEM.
Material* ...	<div style="transform: rotate(-45deg); transform-origin: center;"> <i>Scrap Iron Forged Head 3½. Heel 2½ x 2 Forging & finished 16th Jan. & 8th Feb. 1896</i></div>	
How made ...			
Dimensions ...			
Progress on Inspection			
Date when Inspected			

SKETCHES OF FRAMES SHOWING POSITION AND DESCRIPTION OF WELDS OF FORGINGS, OR PARTICULARS OF TESTS APPLIED TO CASTINGS.

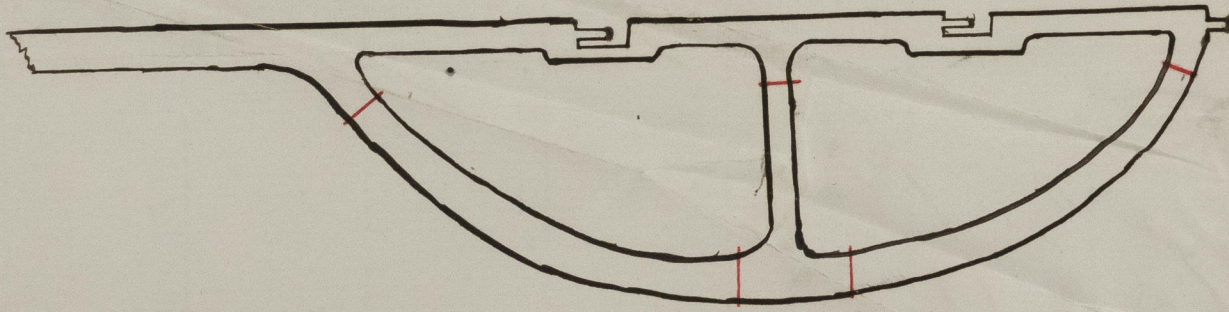

Fee (if any chargeable) £ ✓ : :

To be paid at ✓



© 2021

Lloyd's Register
Foundation

Ref^{ce} a Hall & Co
Ruddle & Co
D.D. No 359

D.D. Agnes^r
Abn No 5165—



© 2021

Lloyd's Register
Foundation