

5.12.95

# MIDSHIP SECTION

S.S. N<sup>o</sup> 359

CLASS 100A.

## DIMENSIONS

LENGTH TWIXT PERPENDICULARS	95 FEET	LENGTH PER RULE	94 FEET
BREADTH MOULDED	19.56 "	BREADTH	19.5 "
DEPTH IN HOLD	10 "	DEPTH	11 "
NUMBERS FOR SCANTLINGS $9.75 + 11 + 16.33 = 37.08 \times 94 = 3485.52$			


SCALE  $\frac{3}{4}$ " = ONE FOOT

ALEXR HALL & CO

SHIPBUILDERS, ENGINEERS & BOILERMAKERS

ABERDEEN.

*Proposed  
length 94 ft. breadth  
19.5 ft. depth 11 ft.*

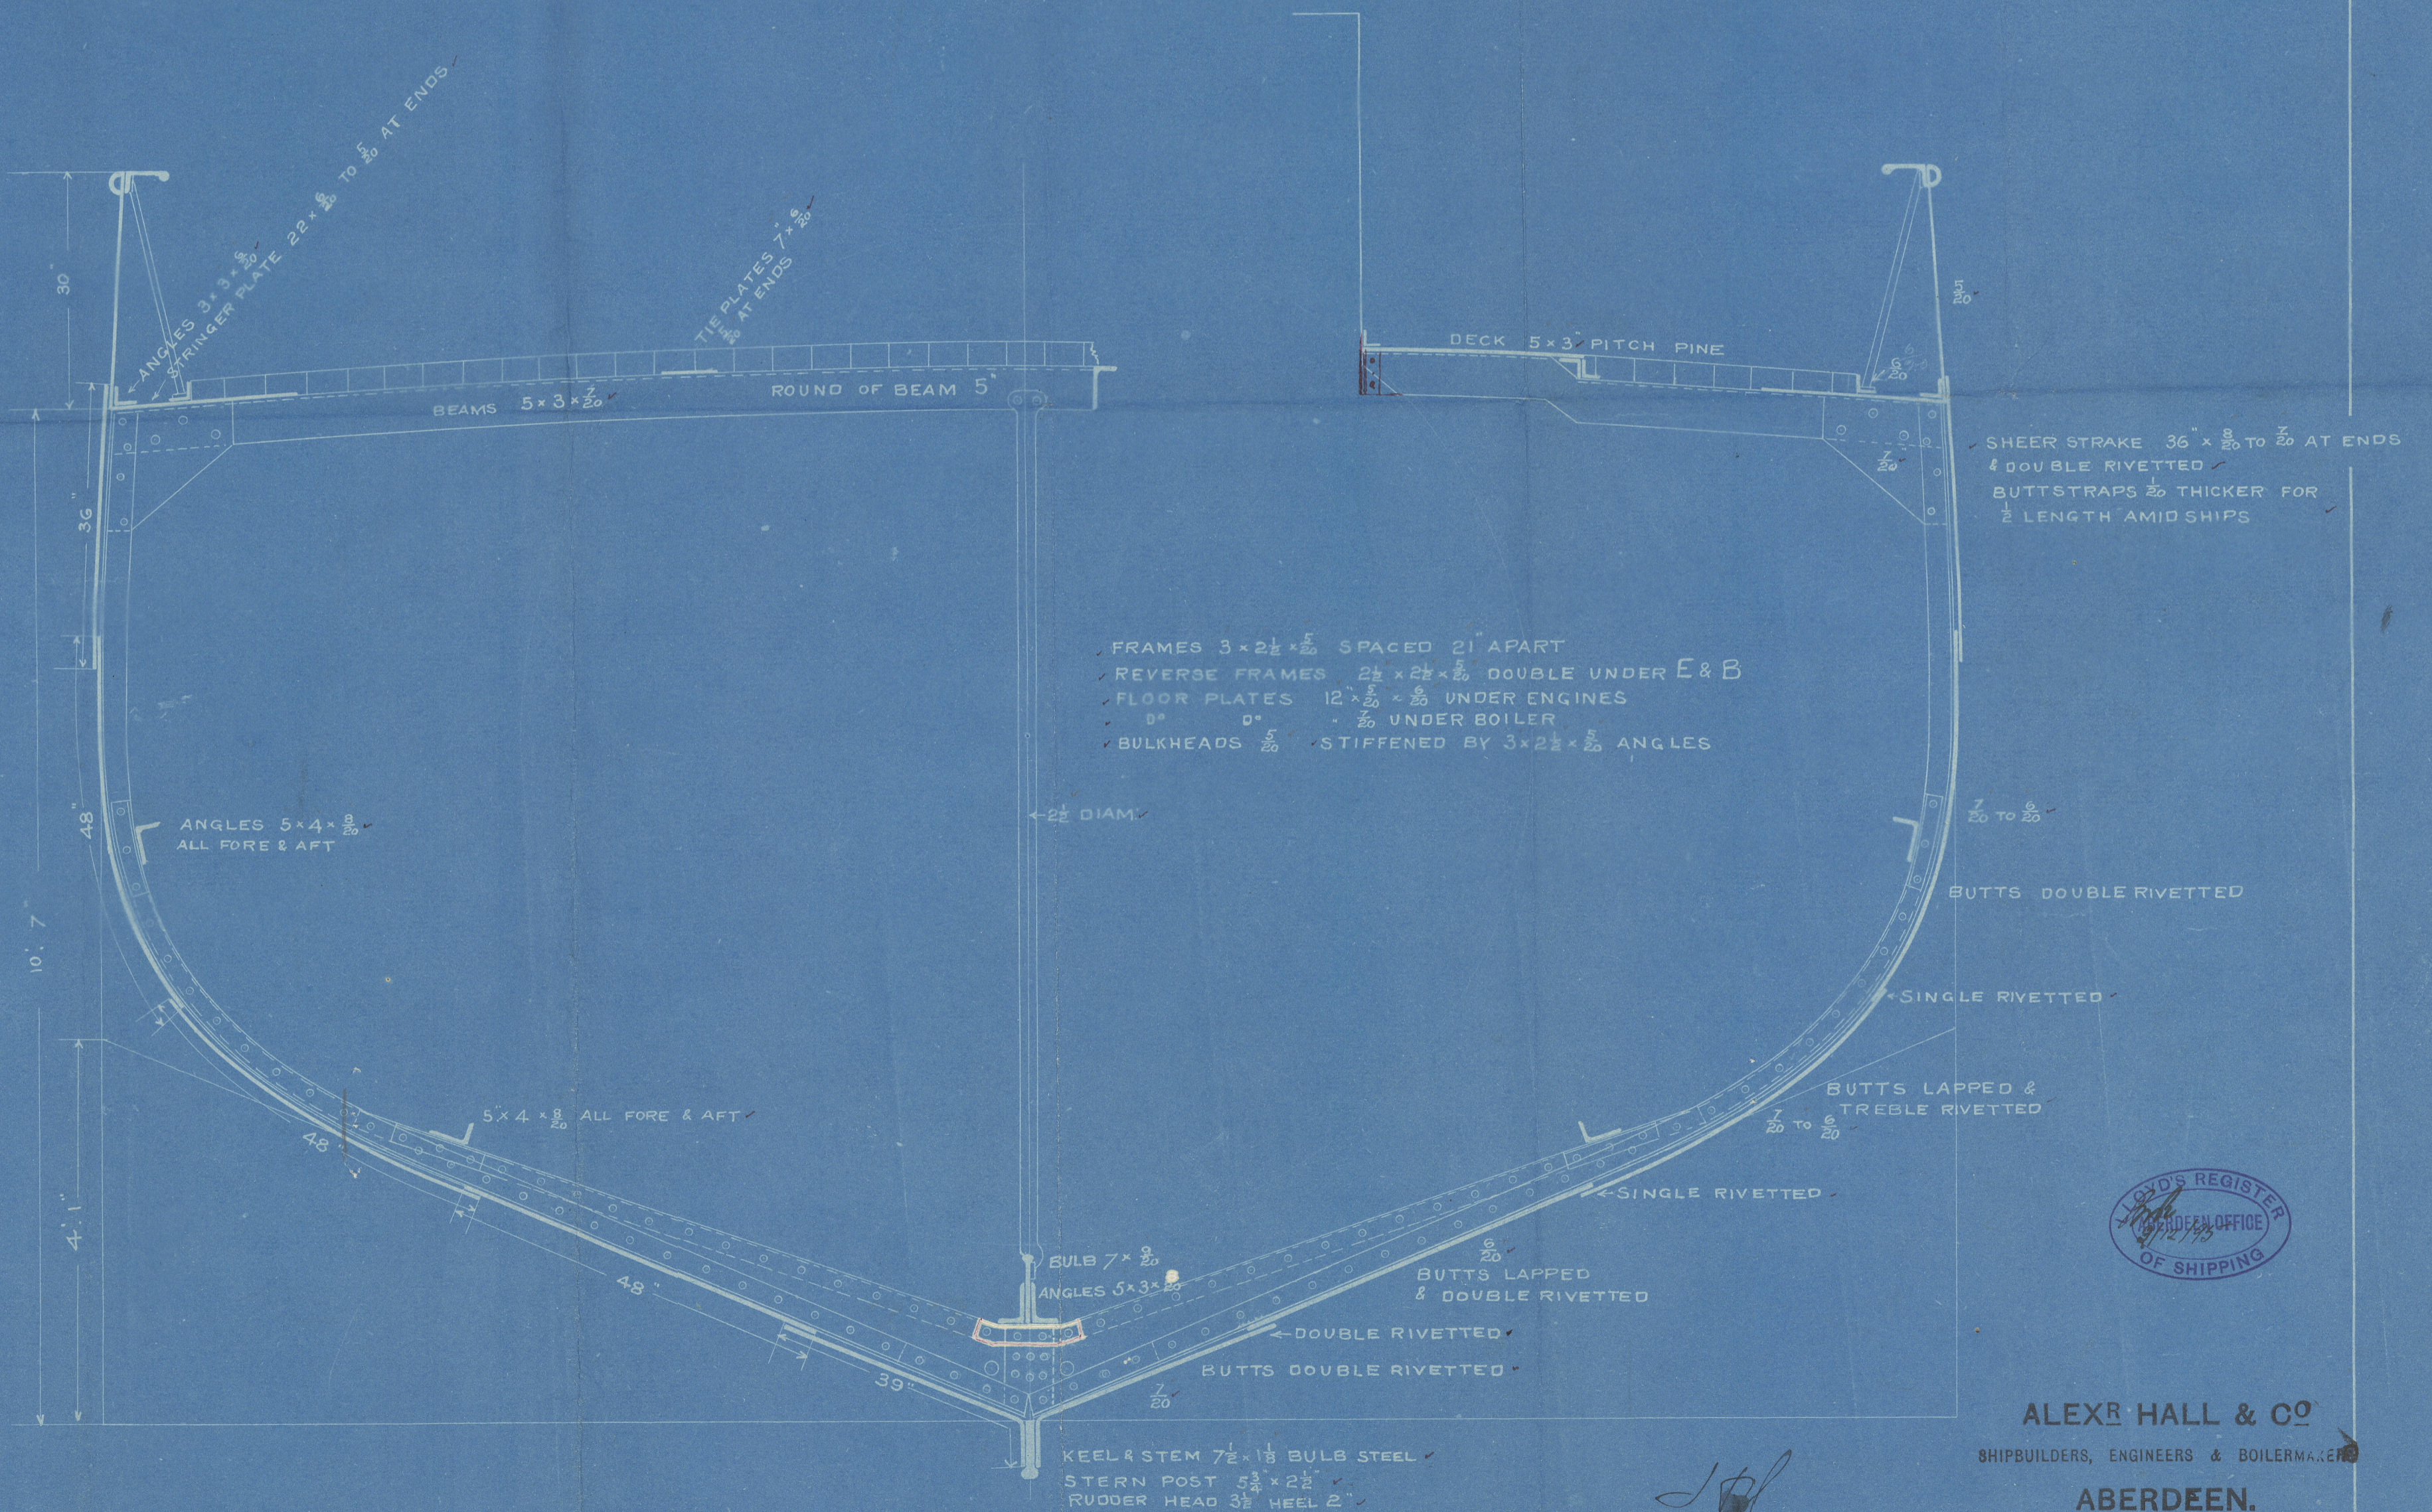

ALEXR HALL & CO


SHIPBUILDERS, ENGINEERS & BOILERMAKERS

ABERDEEN.

24/11/95


359

*J.H.L.  
4/12/95*

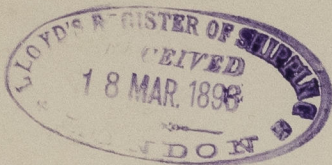

Messrs A. Hall & Co  
Midship Section  
for  
S. S. No 352

S.S. "Agnes"

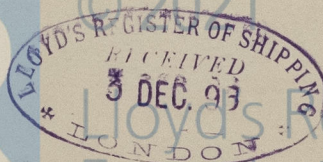

Lloyd's Register  
Foundation

ABNZS-0060