

J.D.L.  
4/2/95

2/12/95


**ALEX<sup>R</sup> HALL & CO**  
SHIPBUILDERS, ENGINEERS & BOILERMAKERS  
**ABERDEEN.**

ABERDEEN.  
24/11/95  
Lloyd's Register  
Foundation



Messrs A. Hall & Co  
Longitudinal Section  
for  
S. S. No 359

W. D. Agnes  
No 205-165 -

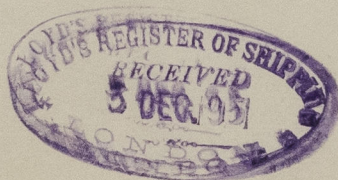

© 2021

Lloyd's Register  
Foundation

ABN25-0061