

# Lloyd's Register of British and Foreign Shipping.

(Report on Vessel No. \_\_\_\_\_ Port \_\_\_\_\_)

No. 340 SHIP FORGINGS OR CASTINGS.

The words FORGINGS or CASTINGS, IRON or STEEL, should be struck out as may be required.

I have to report that the undermentioned Iron ~~or Steel~~ Forgings ~~or Castings~~,  
manufactured by *James Carmichael & Co. (Lim.)*  
of *Dundee* for the Vessel No. *359*, being built  
by *A. Hall & Co.* of *Aberdeen*  
have been inspected by me as set forth below, and found to be, so far as can be seen,  
*sound*


Mark on Forgings.

Lloyd's  
No. *433*  
*J.S.*

*J. Thomson*  
*Dundee*

	STERN FRAME.	RUDDER FRAME.	STEM.
Material* ...	<i>Scrap Iron</i>	/	/
How made ...	<i>Forged</i>		
Dimensions ...	<i>5 3/4" x 2 1/2"</i>		
Progress on Inspection	<i>Forging &amp; finished.</i>		
Date when Inspected	<i>6<sup>th</sup> &amp; 28<sup>th</sup> Dec. 1895. 8<sup>th</sup> Jan. 1896</i>		

SKETCHES OF FRAMES SHOWING POSITION AND DESCRIPTION OF WELDS OF FORGINGS, OR PARTICULARS OF TESTS APPLIED TO CASTINGS.

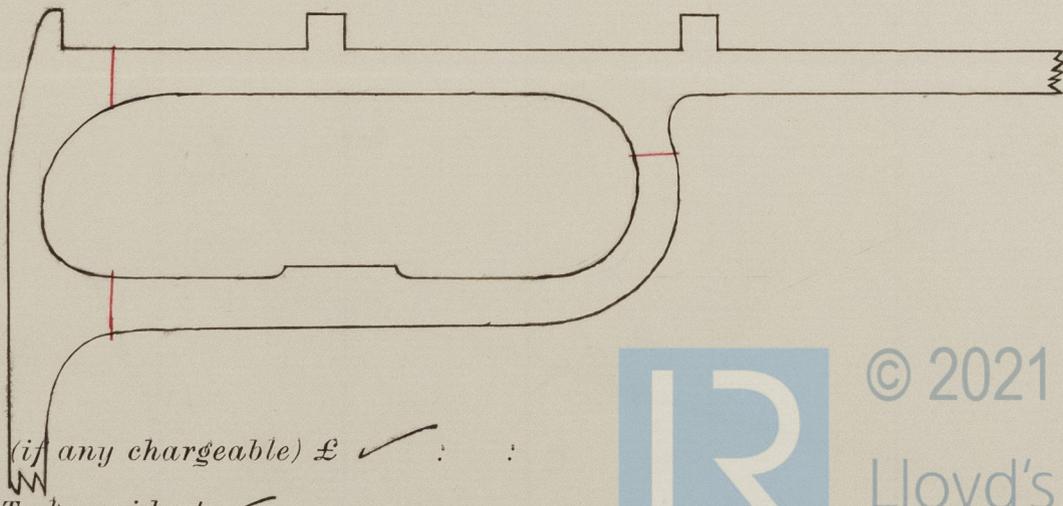

Fee (if any chargeable) £  :  
To be paid at



\* If of Iron, state whether scrap or puddled Iron.

Slow Post -  
Rep - a Hall & Co

no 359

or  
@ P. Agnes

no 5165



© 2021

Lloyd's Register  
Foundation