
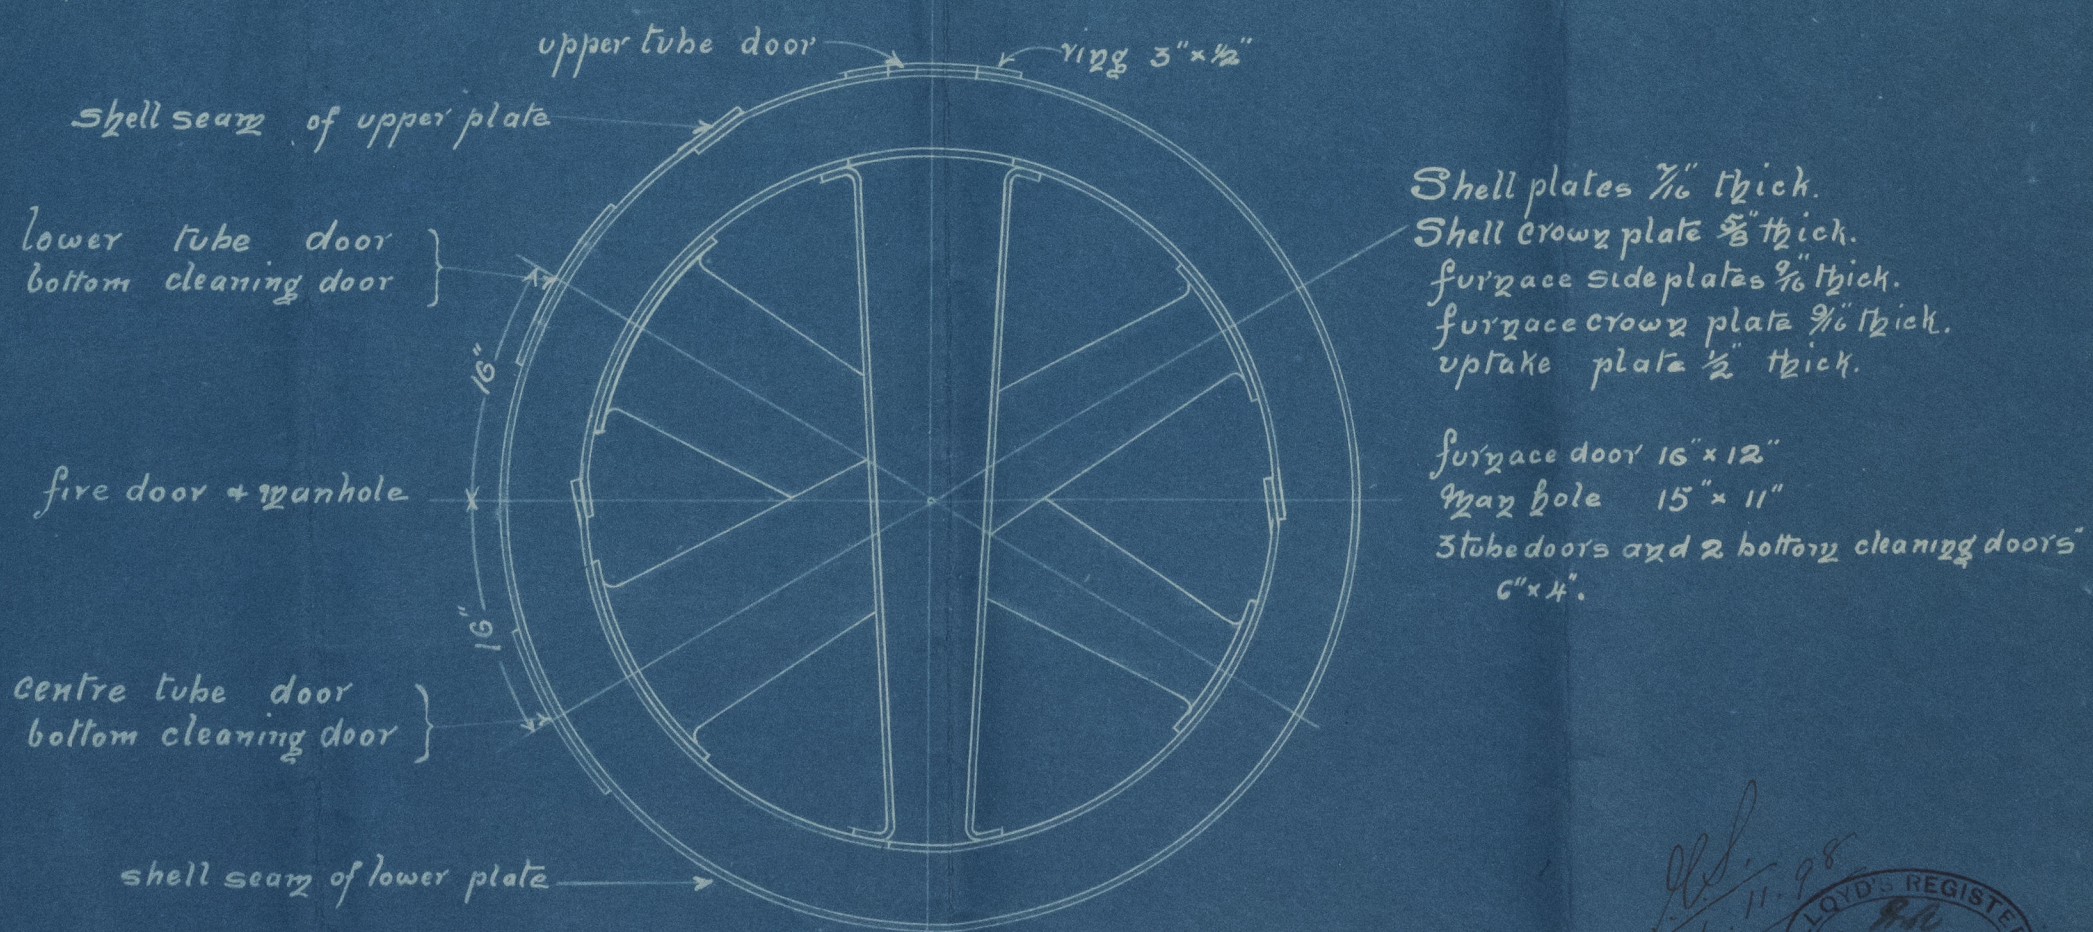
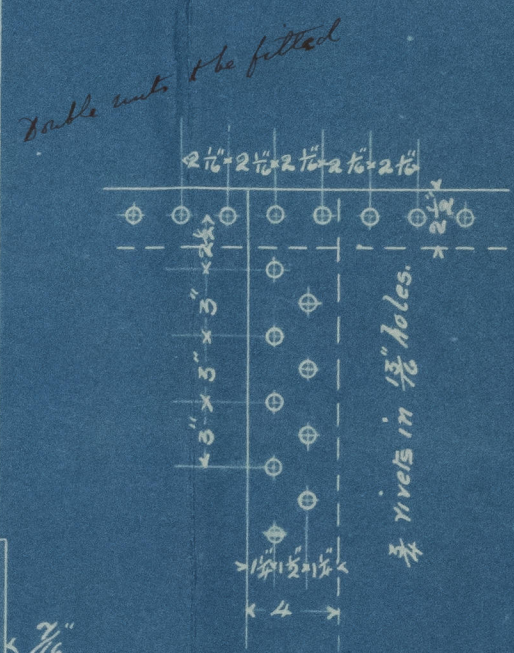


28. 11. 98

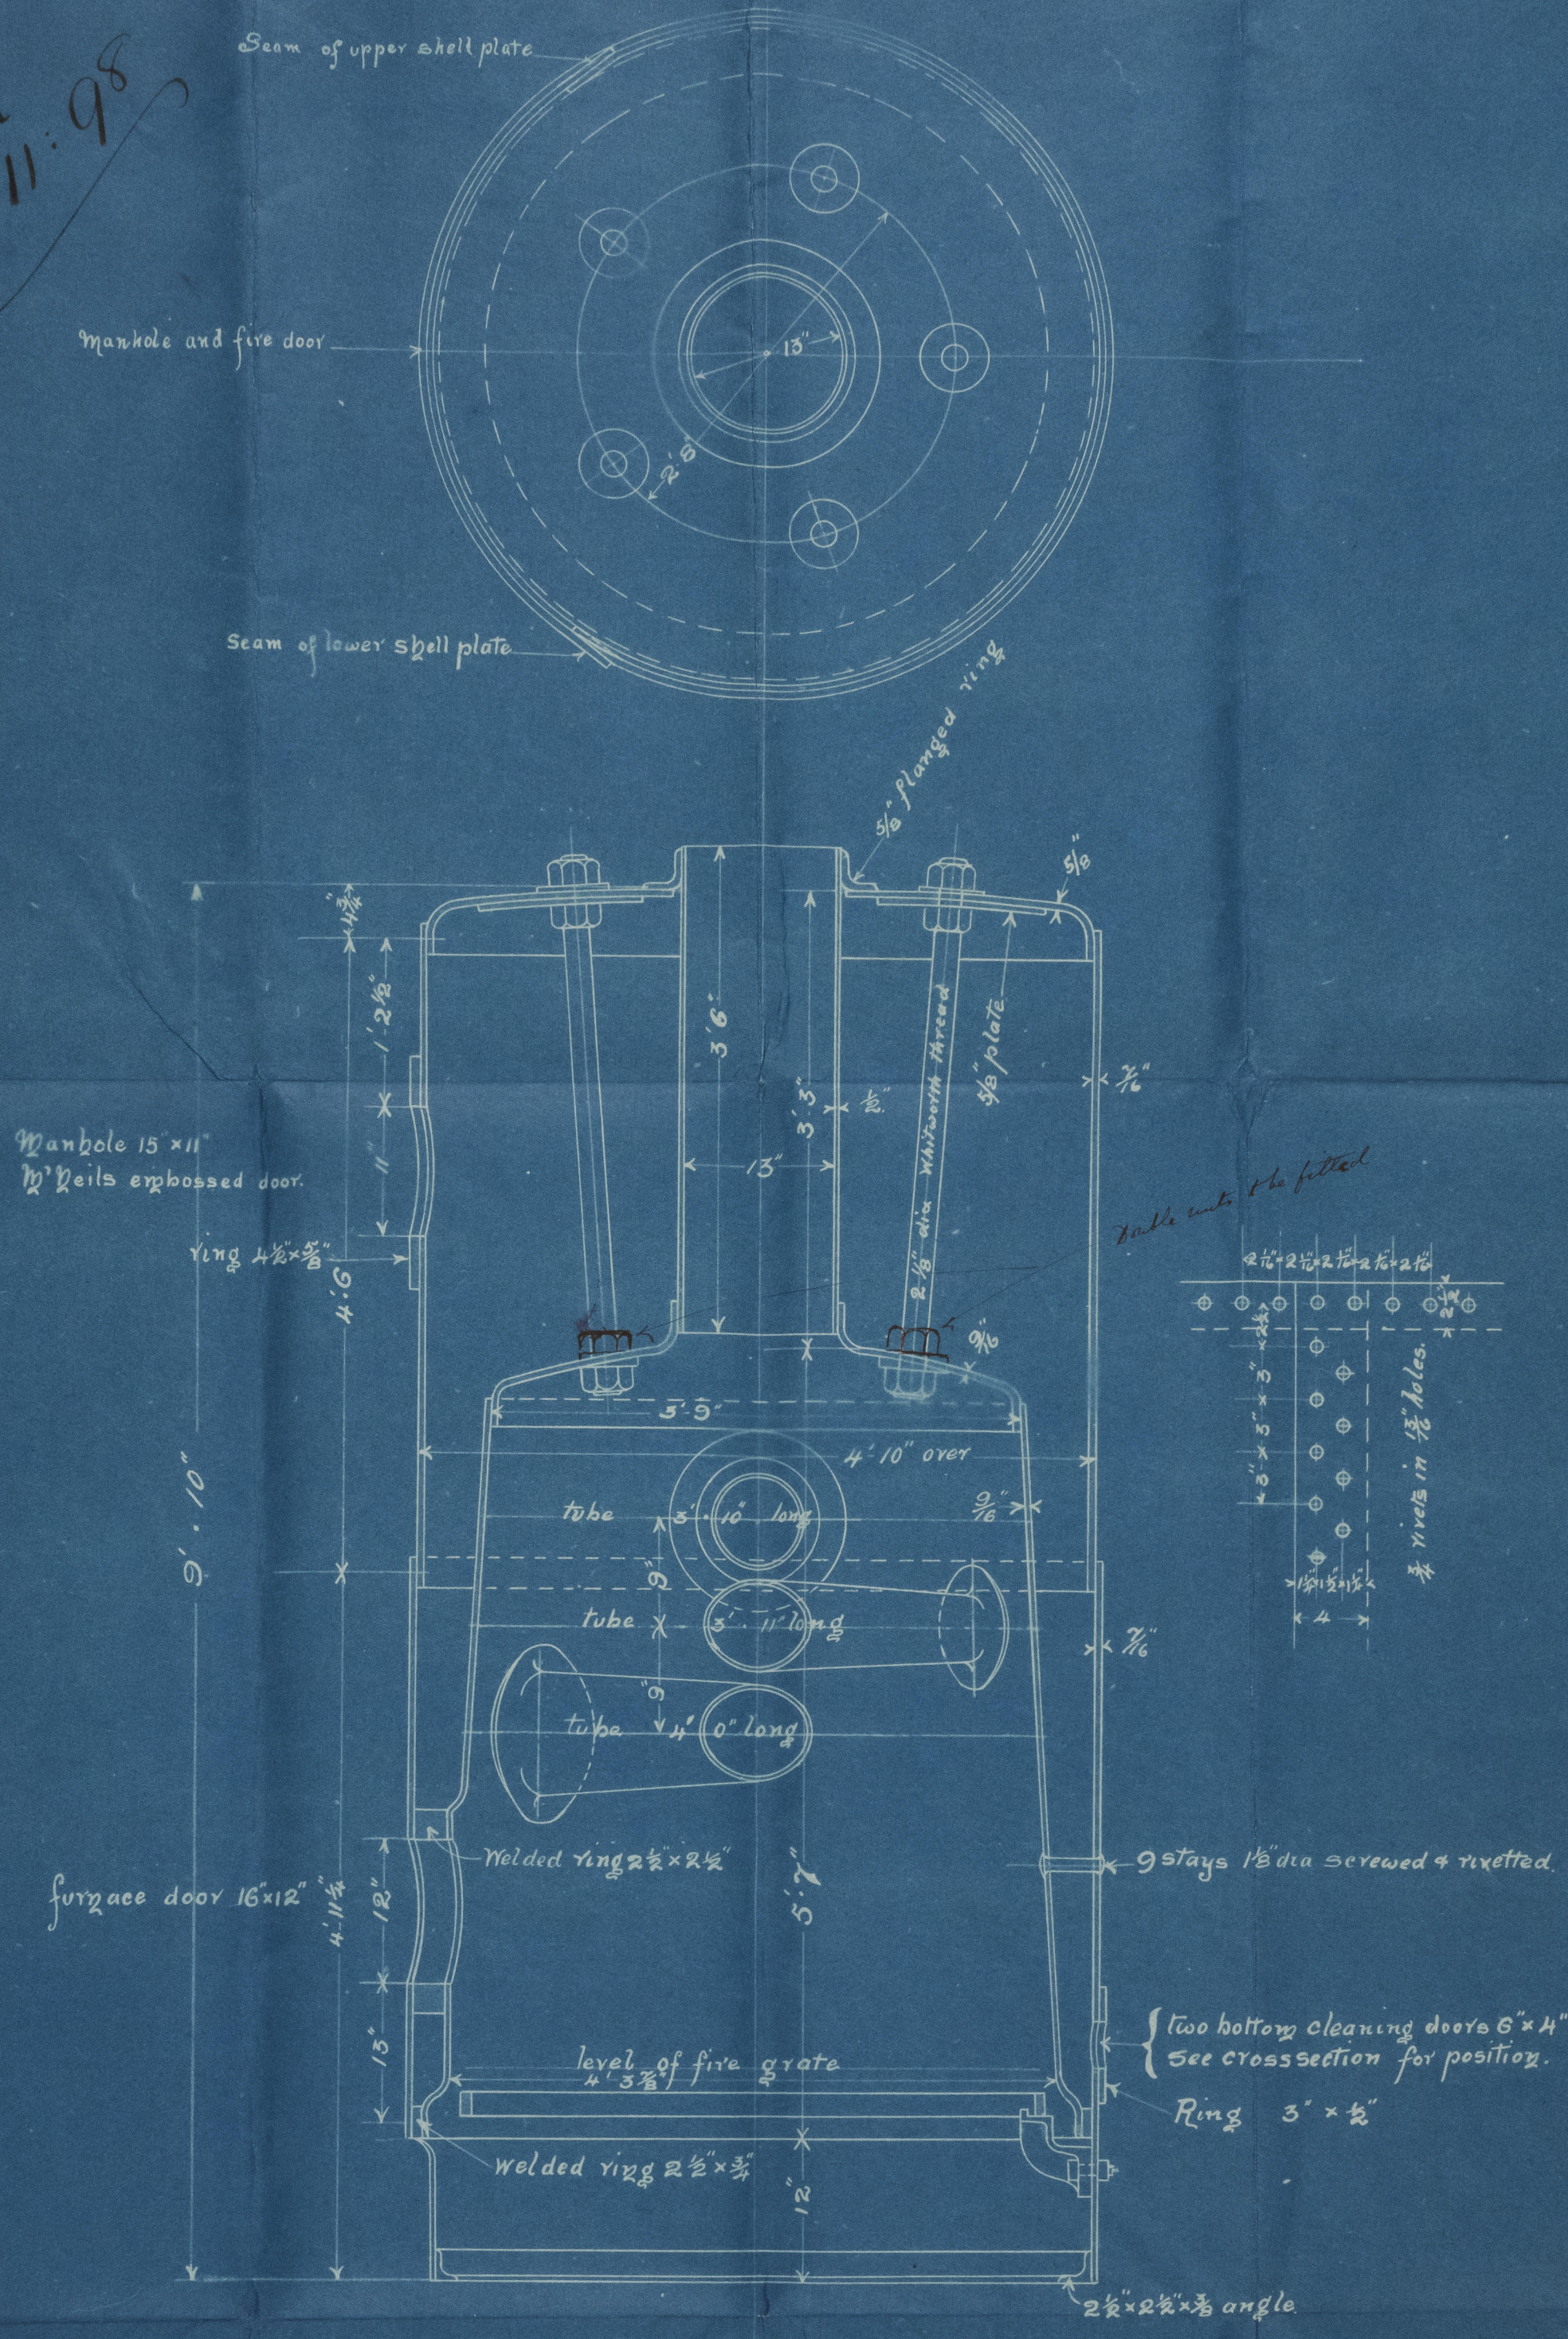

Steel VERTICAL BOILER FOR S.S. ST. CLAIR.

WORKING PRESSURE 75 LBS.

Scale 1 inch to a foot.

22/11/98.





---

Steel Fontley Boiler  
for the  
O. P. Saint-Clair  
to be made by  
Messrs. J. & A. Abernethy & Co  
Aberdeen

---



A8N28-0033



© 2021

Lloyd's Register  
Foundation