


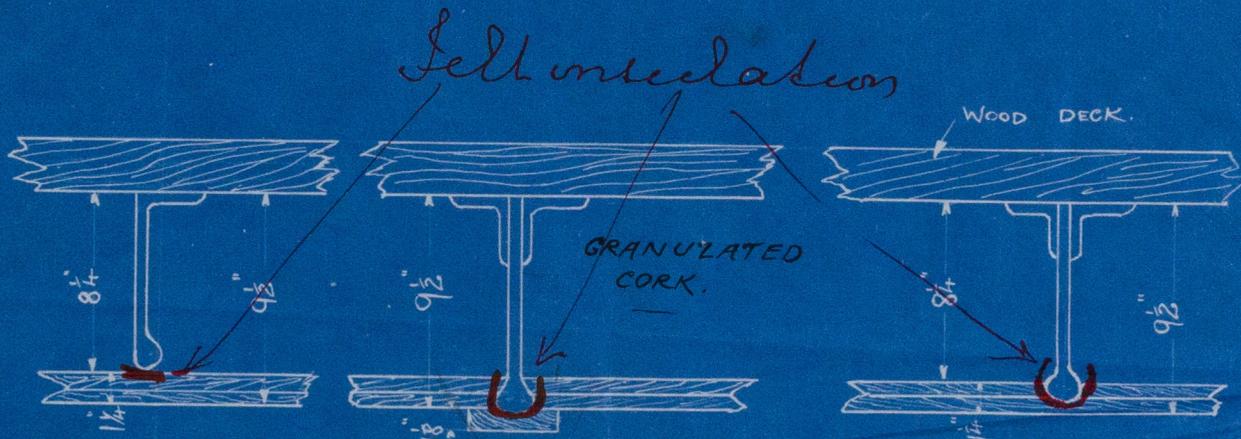

S. S. ARMIDA.

DETAIL OF INSULATION UNDER DECK.

SCALE 1/2" = 1 FOOT.



SECTION THRO' 8"

BULB ANGLE

DECK BEAMS

SECTION THRO' 10"

BULB PLATE DECK

BEAMS

SECTION THRO' 9"

BULB PLATE DECK

BEAM.

ASD
28/6/13



© 2019

Lloyd's Register
Foundation

ABN 32 - 0167