
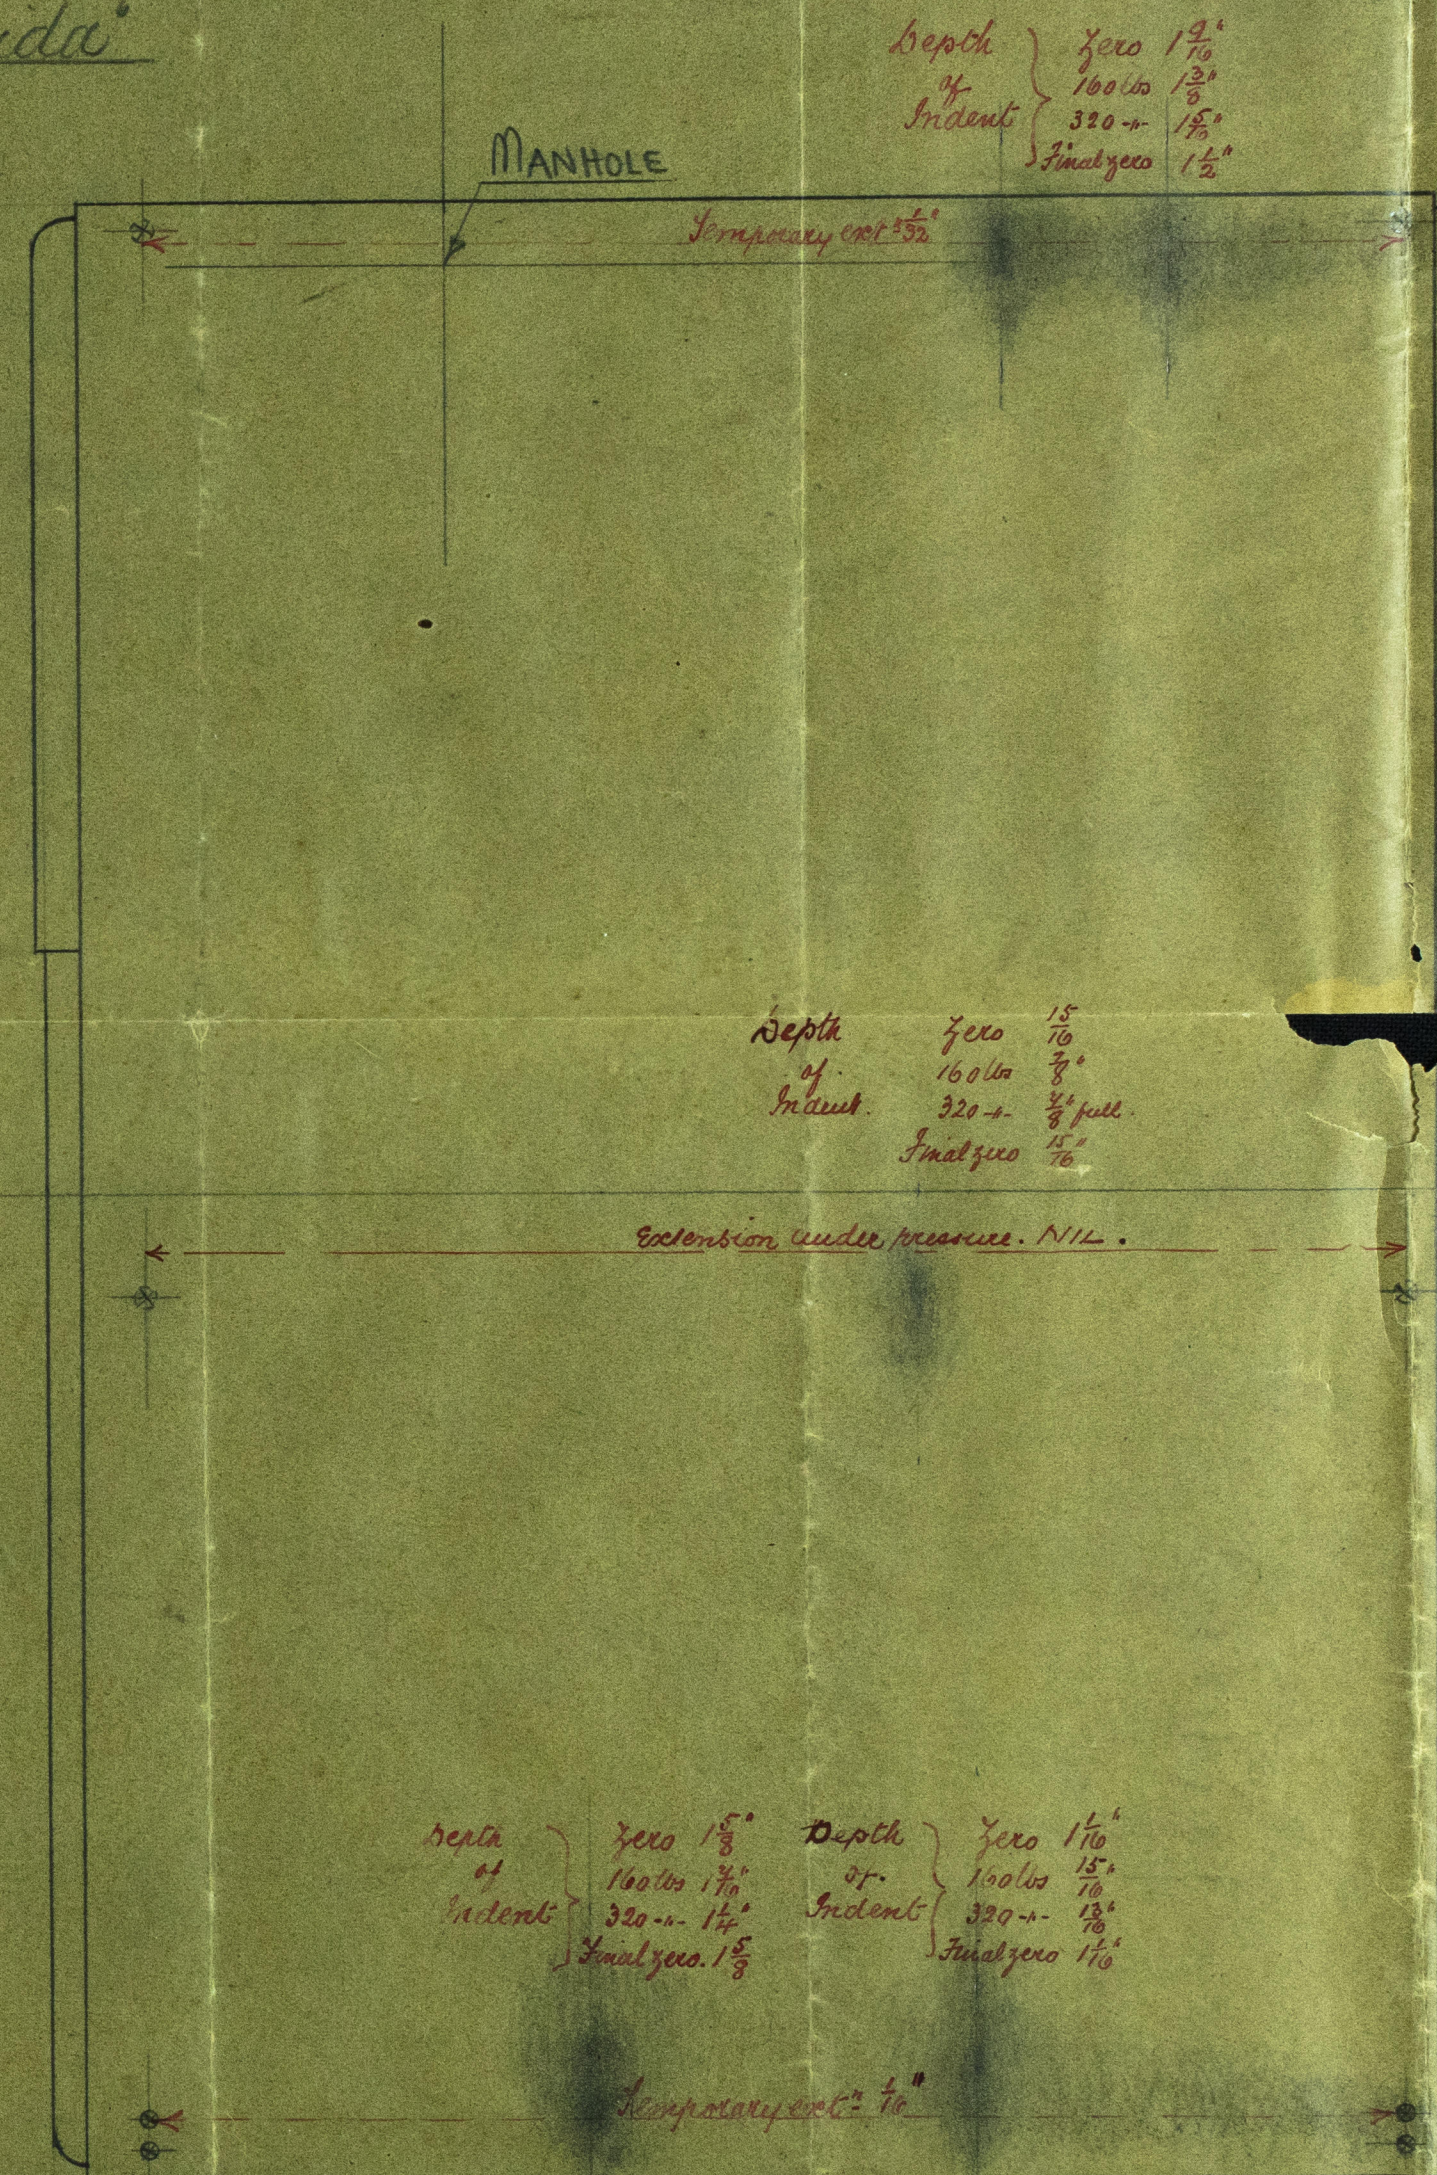


Main boiler salvaged from wreck of S.S. 'Yadorna' near Cork and intended
to be fitted on board S.S. 'Armeda'

Sketch showing indentations
on shell
and Gaugings of same under hydro test.

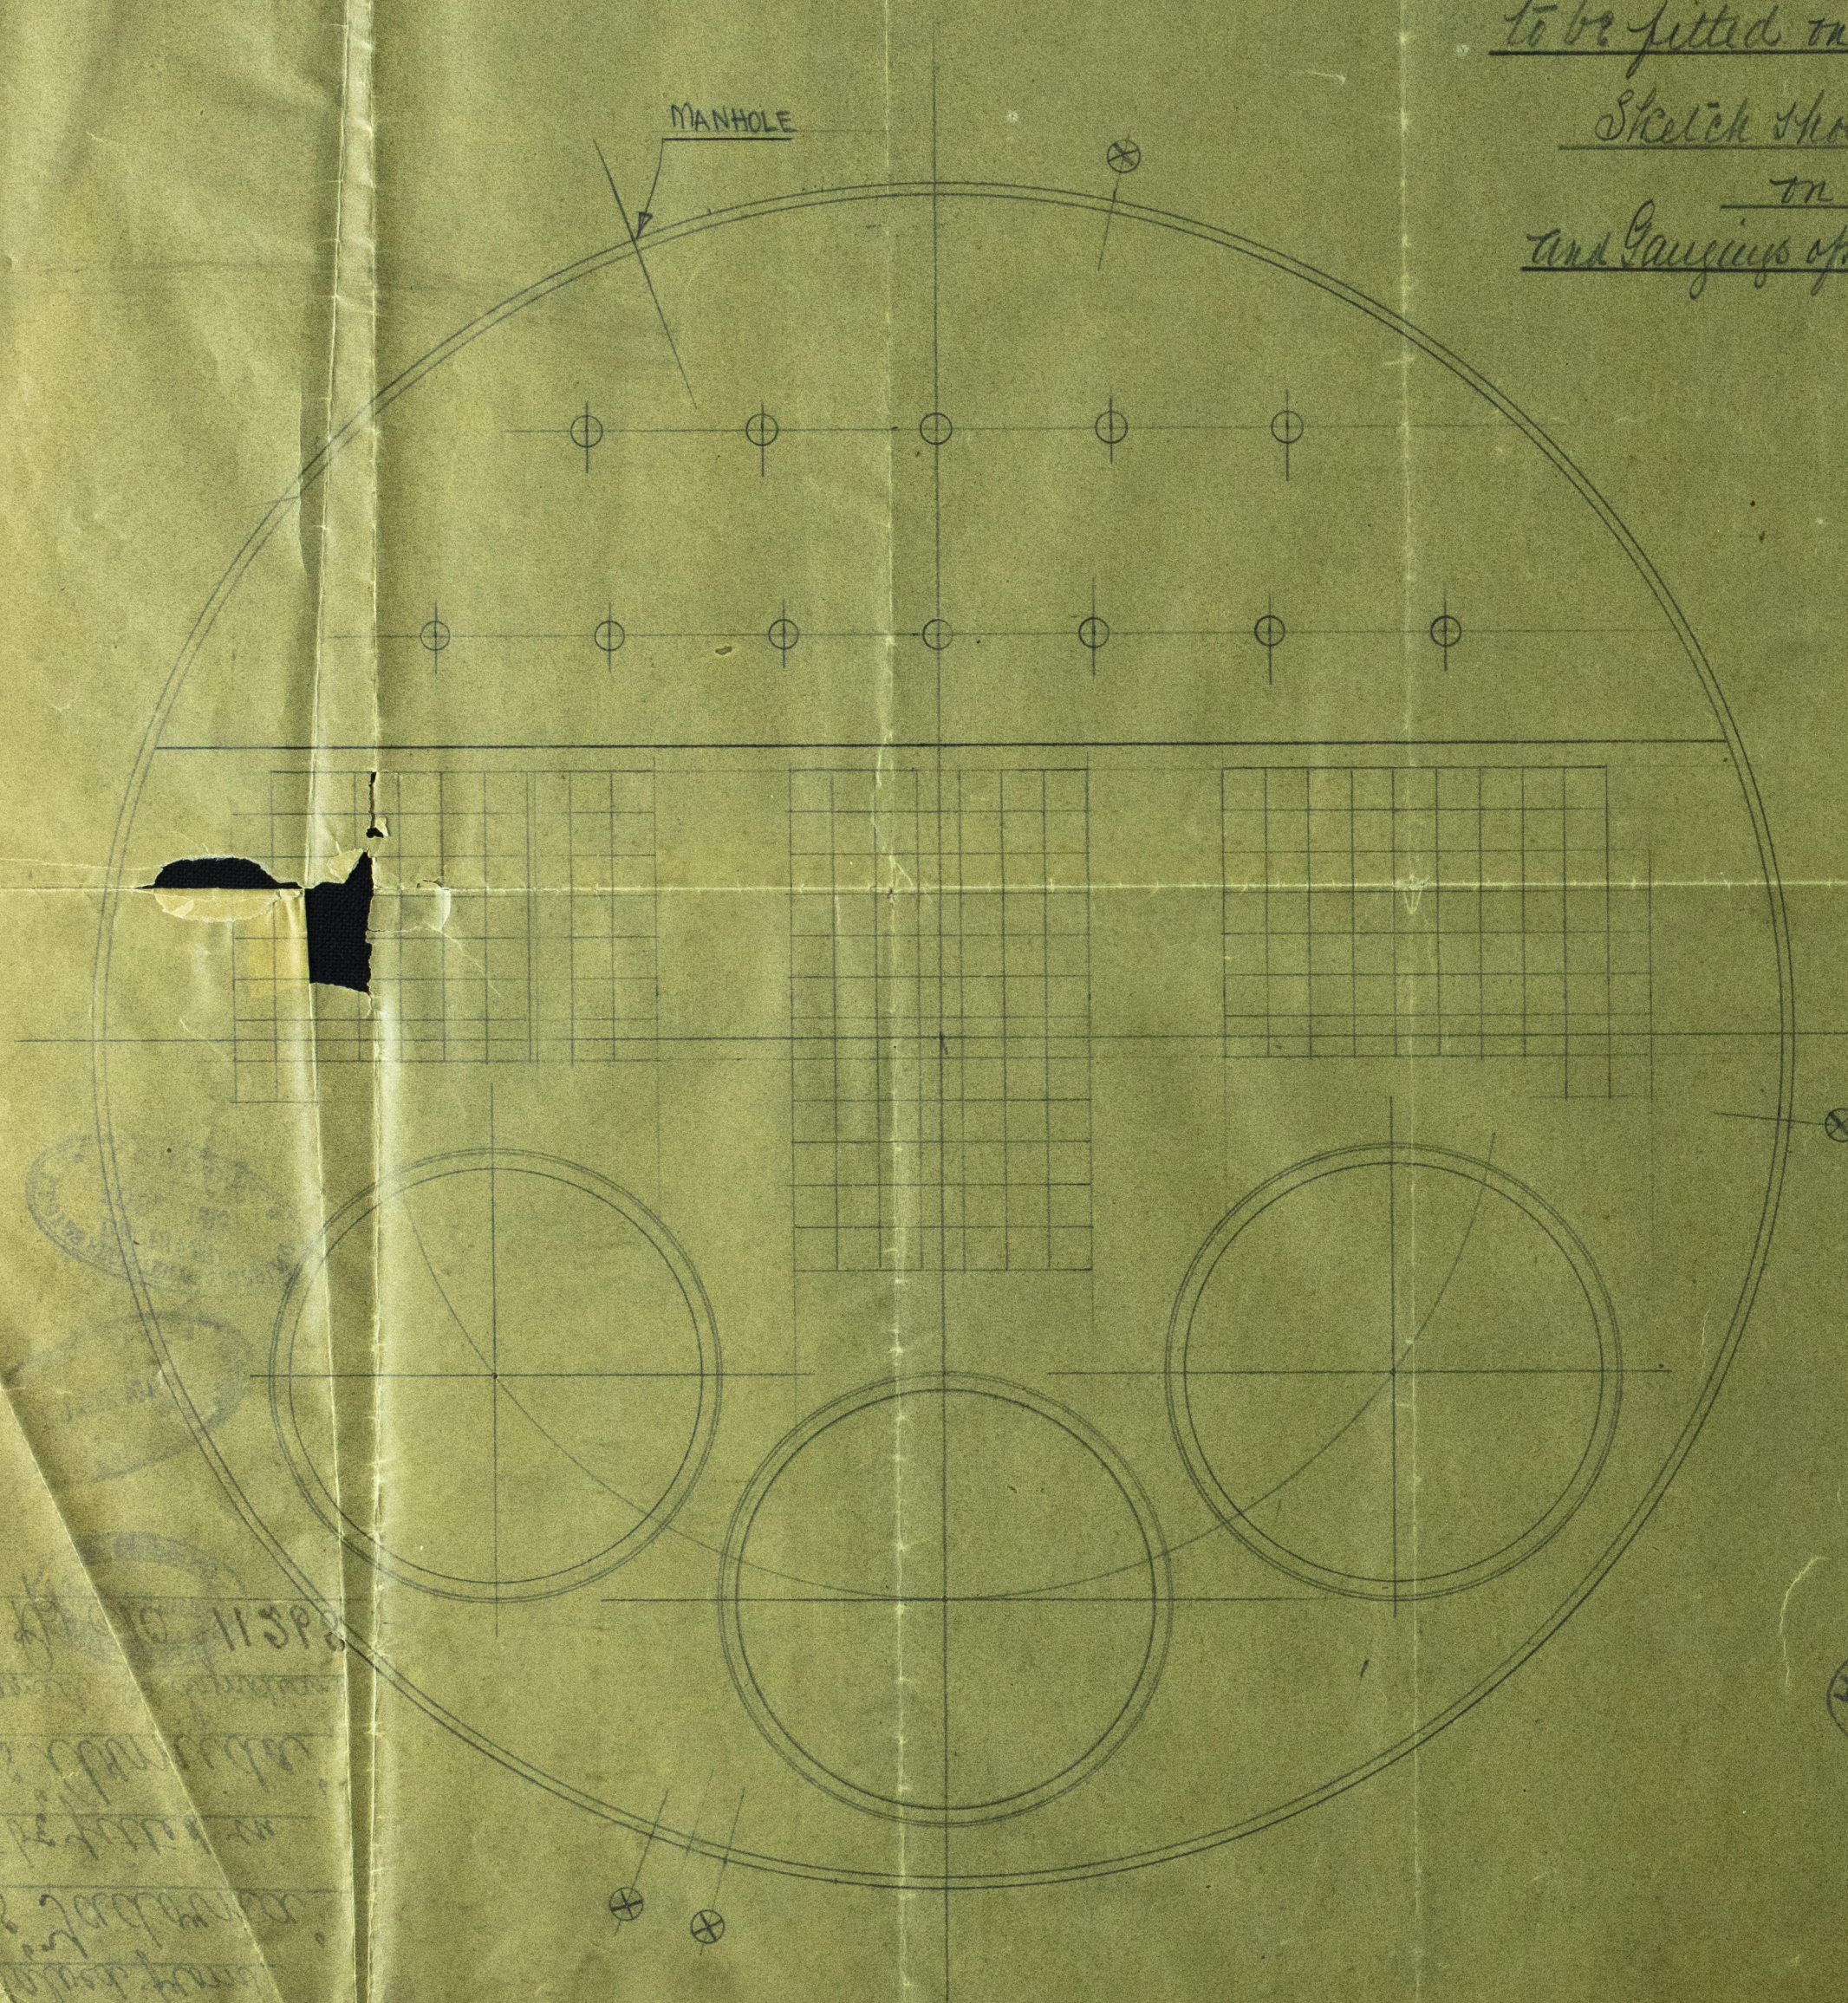

Depth of Indent







Boiler front

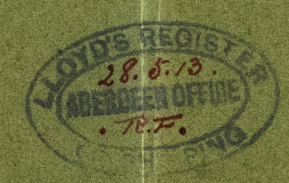

© 2019
Lloyd's Register
Foundation

AS1152-0186

Main Boiler
Salved from
S.S. "Tadorna"
to be fitted in
S.S. "Armida"
renamed S.S. "Symdiani"
Ch. R. C. 11268

