


Composite Ship, build at Amsterdam.


1870, by W. H. Meursing.

Length aloft 130 feet
 Depth from top of Upperdeck Beam to
 top of Floor 19 1/2 "
 Extreme Breadth 34 "

Rec 28/11/76
 16

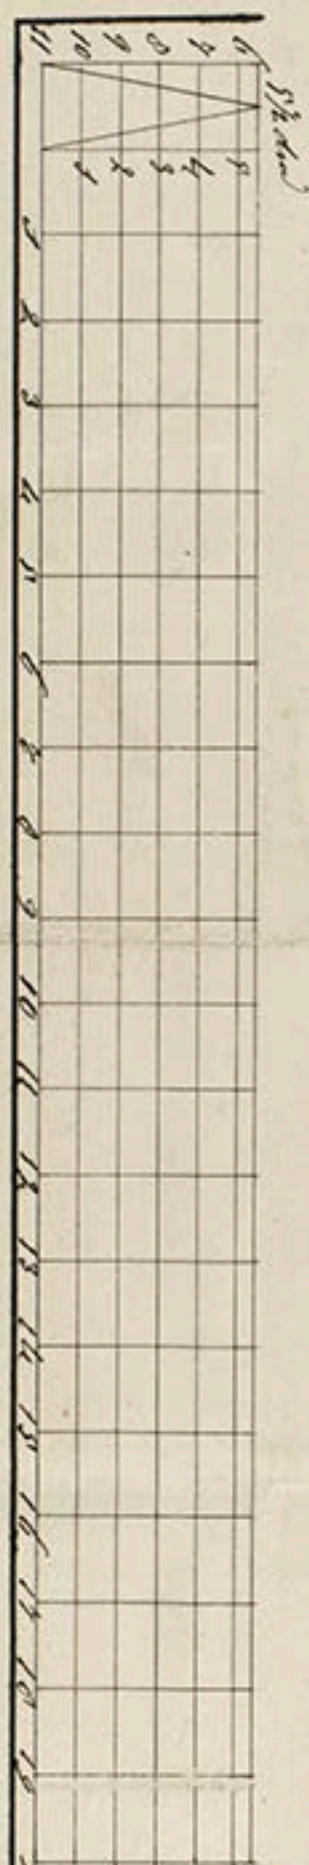

20 1/2 inch

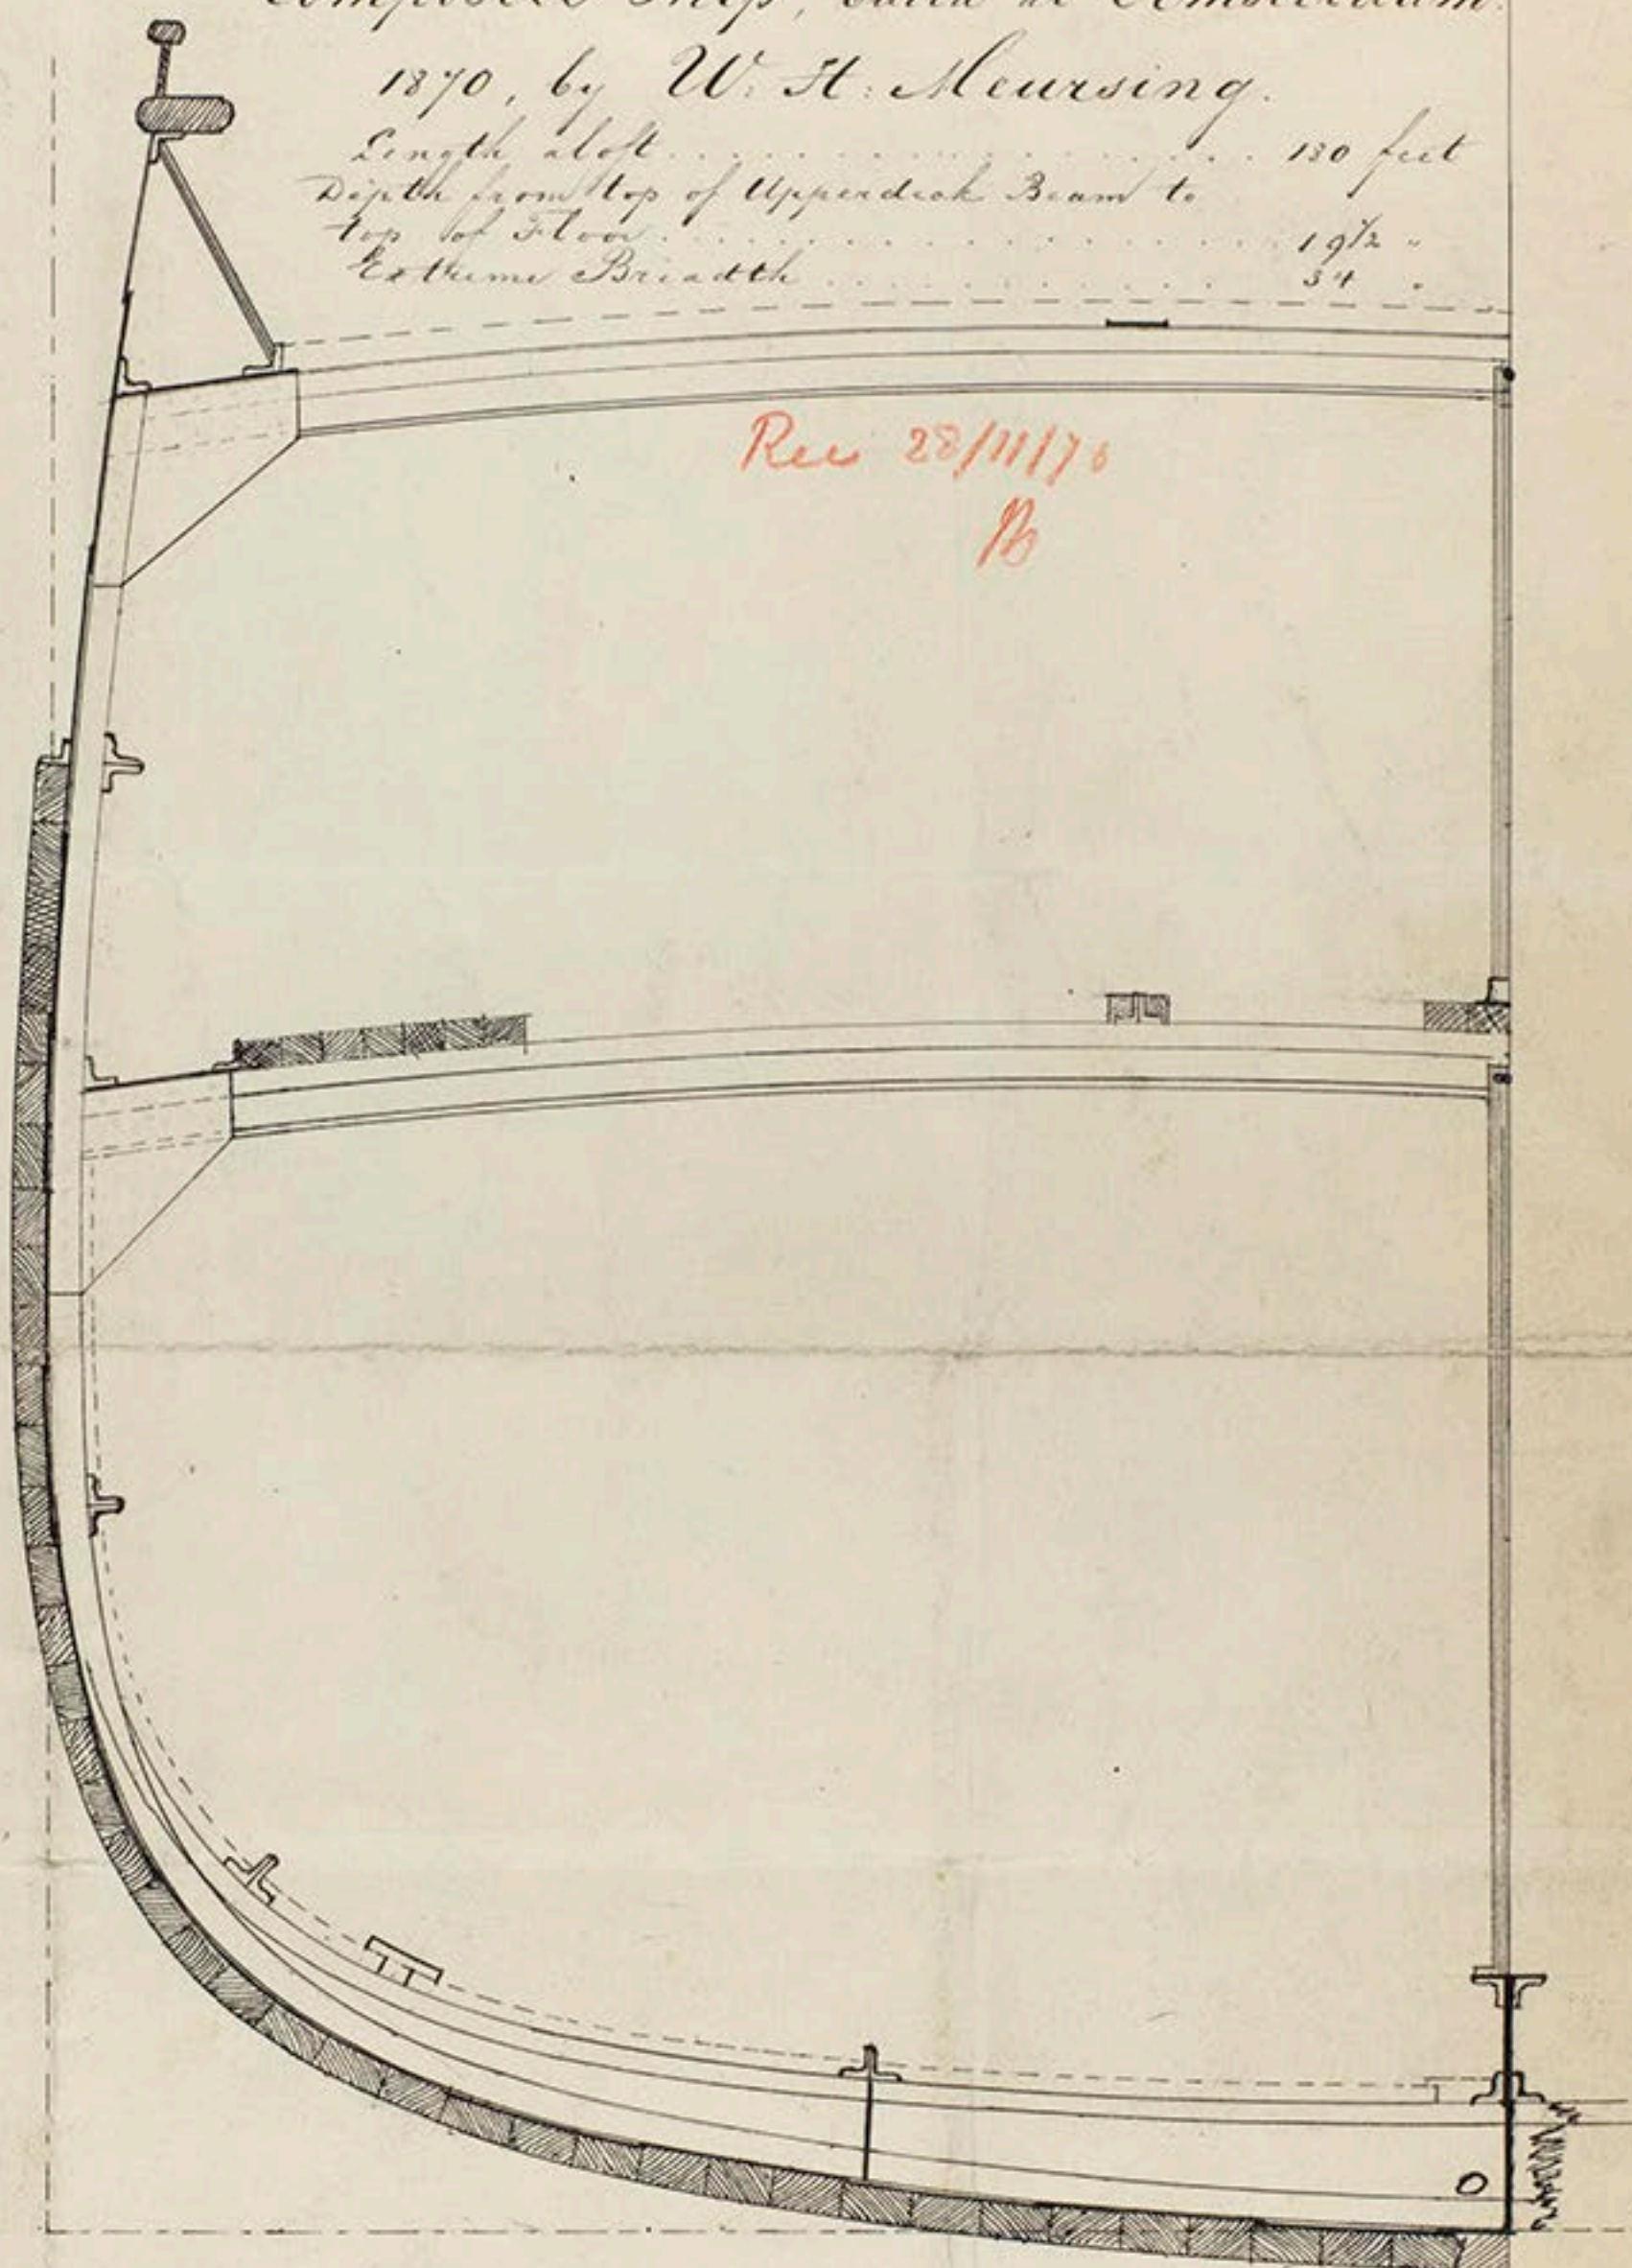

Clipper Bark Anna Elisabeth
 Kaplt: H. J. Klasen
 groot 449. gemeten lasten
 November 1876



© 2018

Lloyd's Register
 Foundation