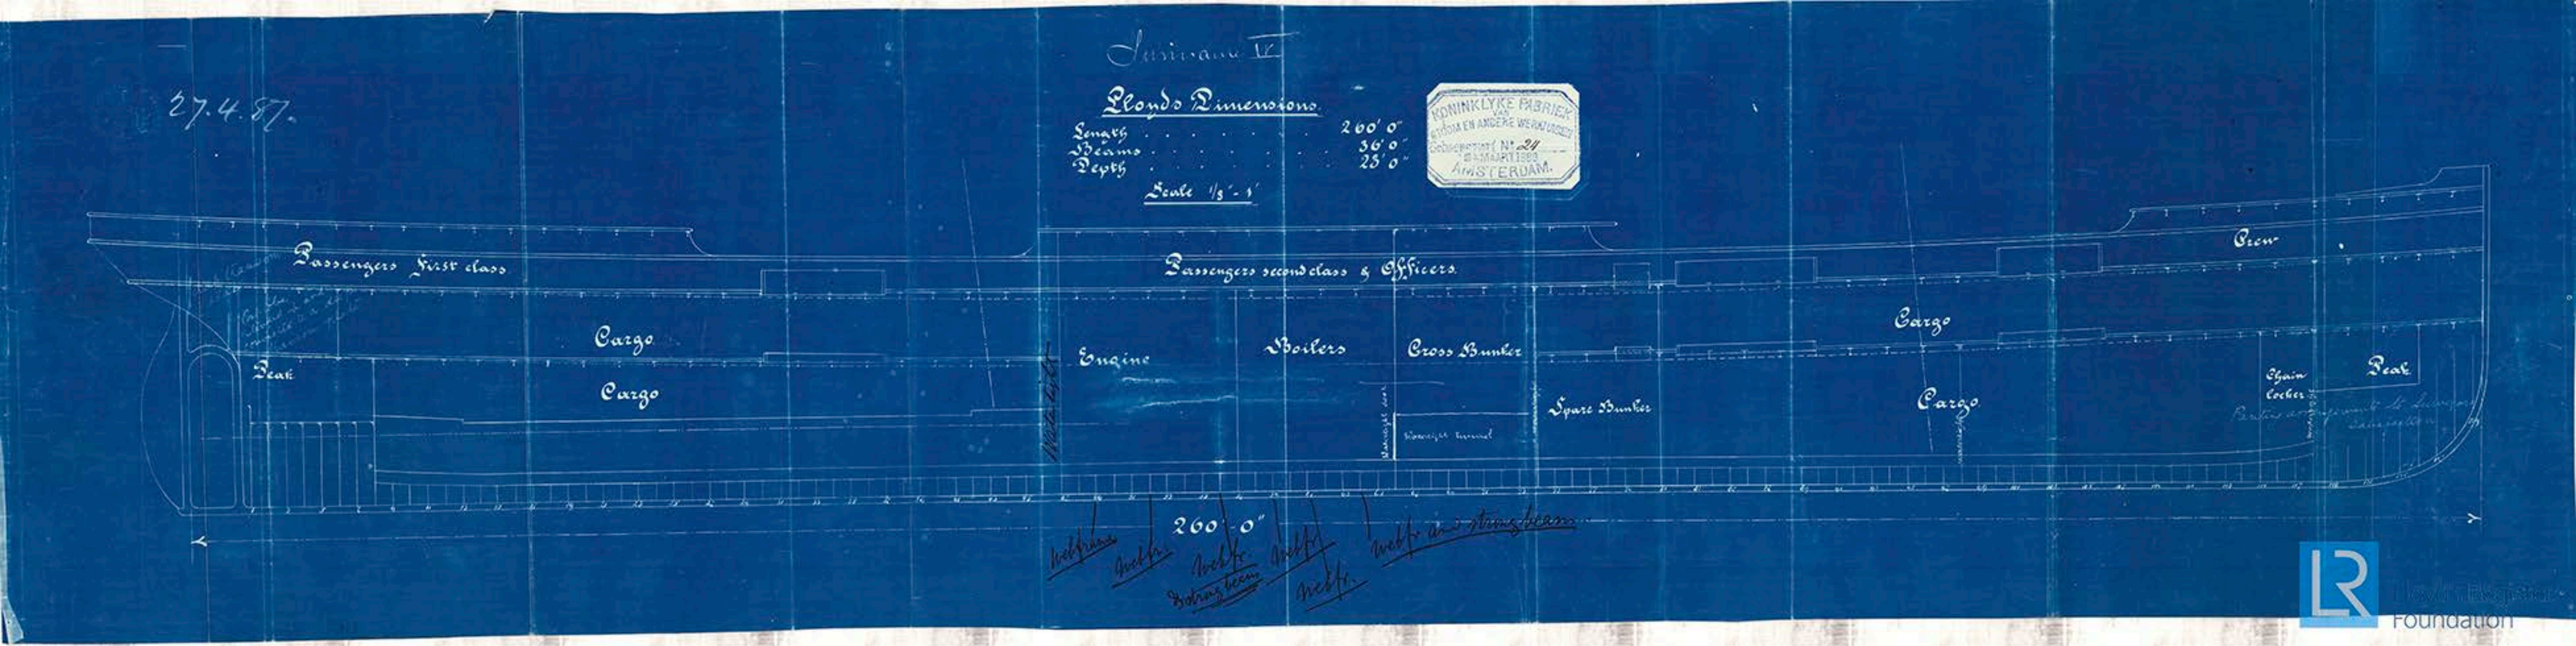
27.4.87.
Suriname IV
Lloyds Dimensions
Length 260' 0"
Beams 36' 0"
Depth 23' 0"
Scale 1/8" - 1'
KONINKLYKE FABRIEK VAN STOOM EN ANDERE WERKTUIGEN
Geboortenr. No 24
AMSTERDAM.
Passengers First class
Passengers second class & Officers
Crew
Cargo
Cargo
Cargo
Cargo
Peak
Peak
Engine
Boilers
Cross Bunker
Spare Bunker
Chain Locker
260' 0"
Webfr.
Webfr.
Webfr.
Webfr.
Webfr.
Webfr. and strong beam
Strong beam