
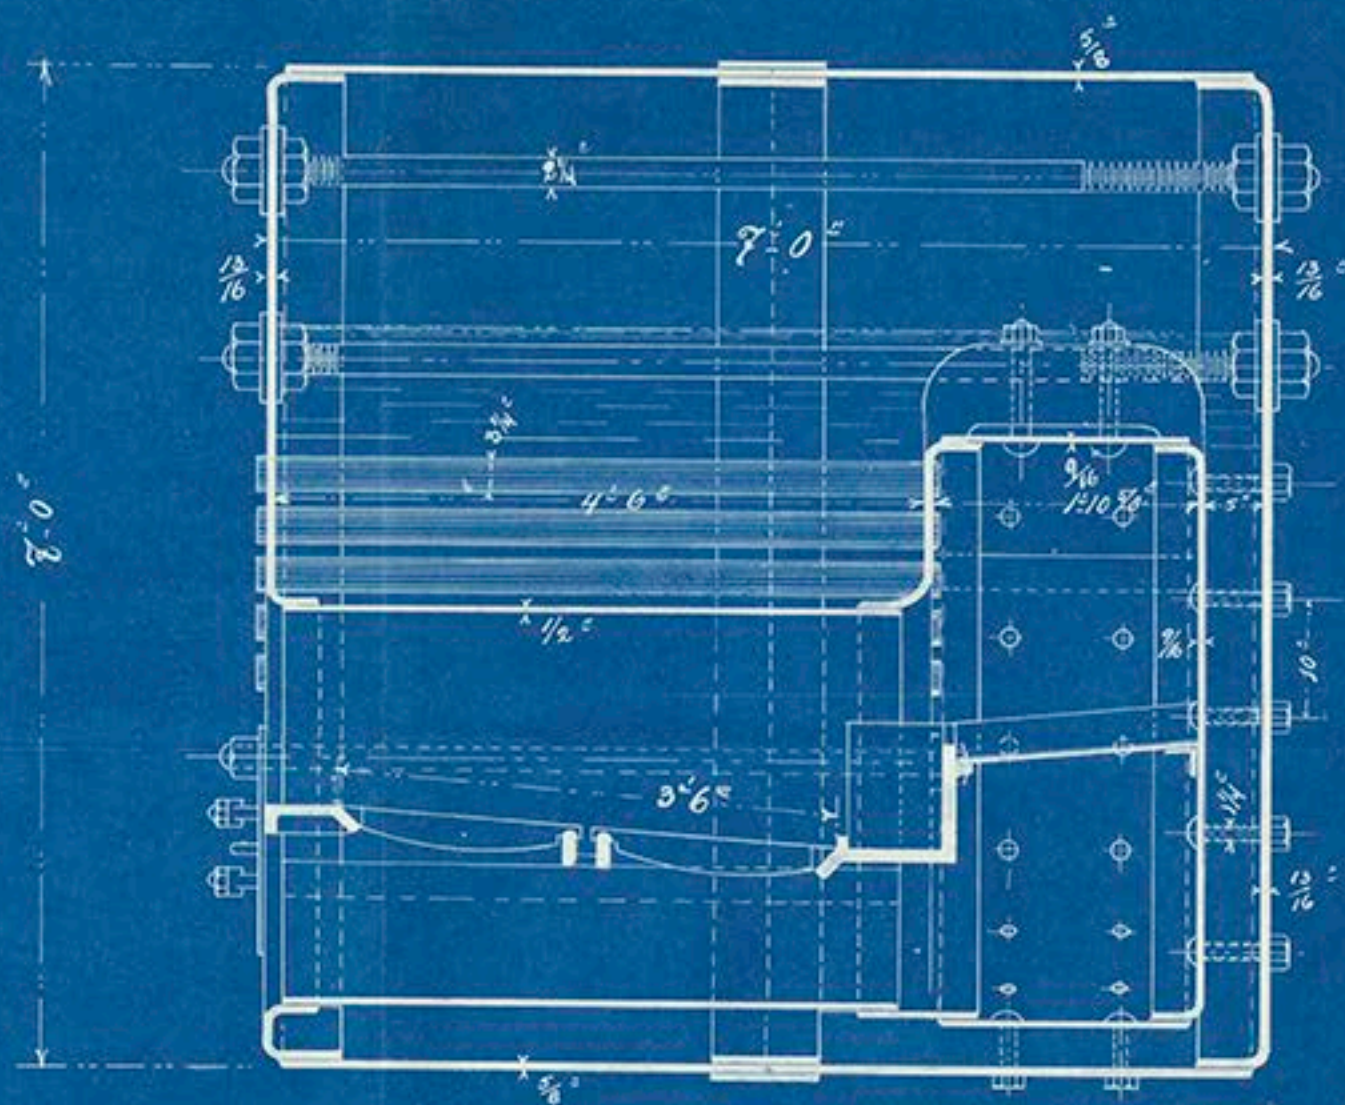


Donkey Boiler for fourth Steamer of the Koninklyke  
West Ind. Maildienst

Rec. 24/5/87  
June

Working Pressure 80 lbs

Scale  $1'' = 1'$

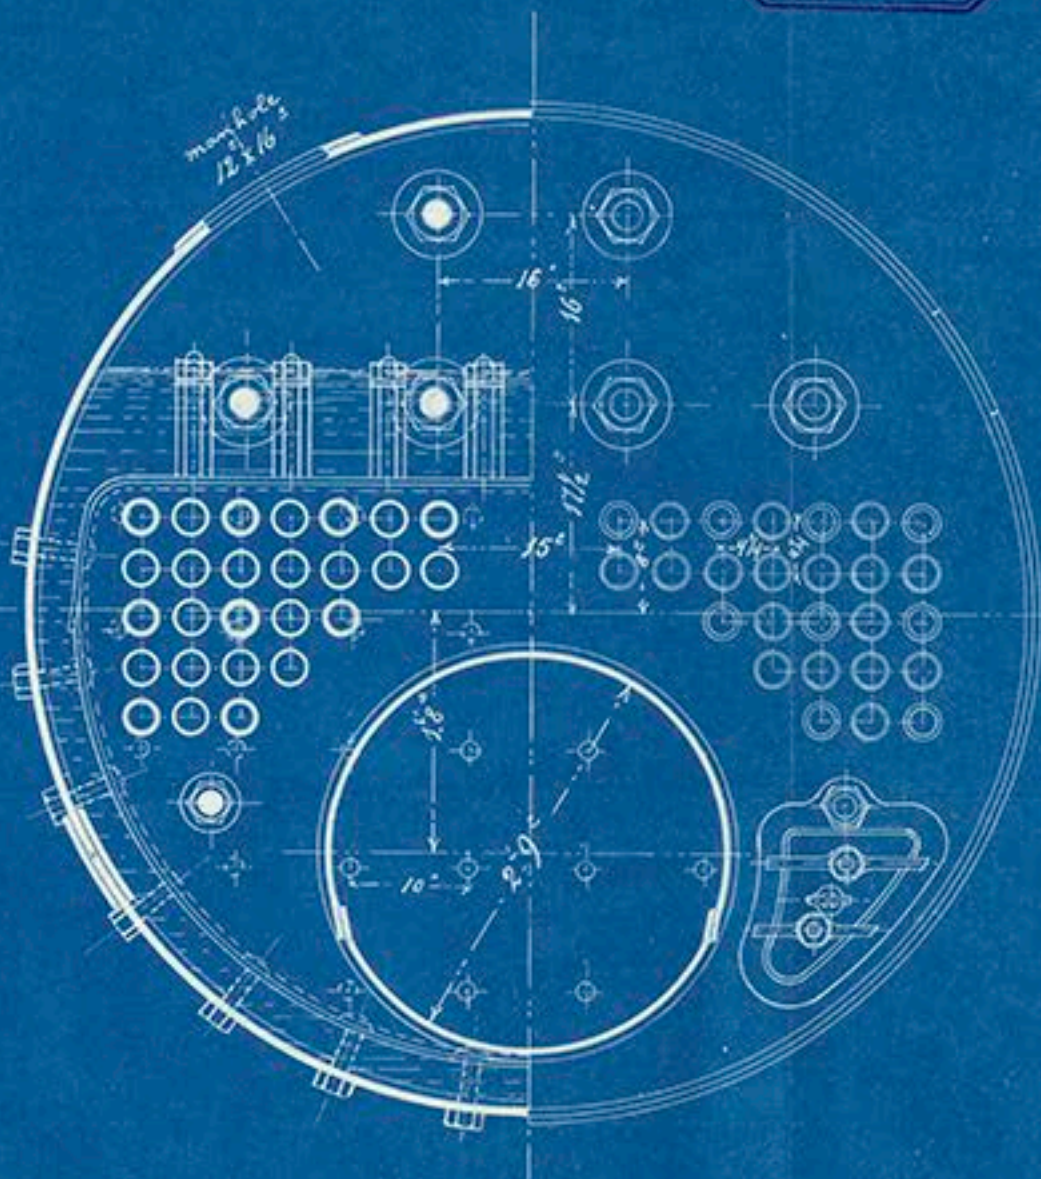



Prins Frederik Hendrik.

Ans: Report no. 848.



© 2018

Lloyd's Register  
Foundation