


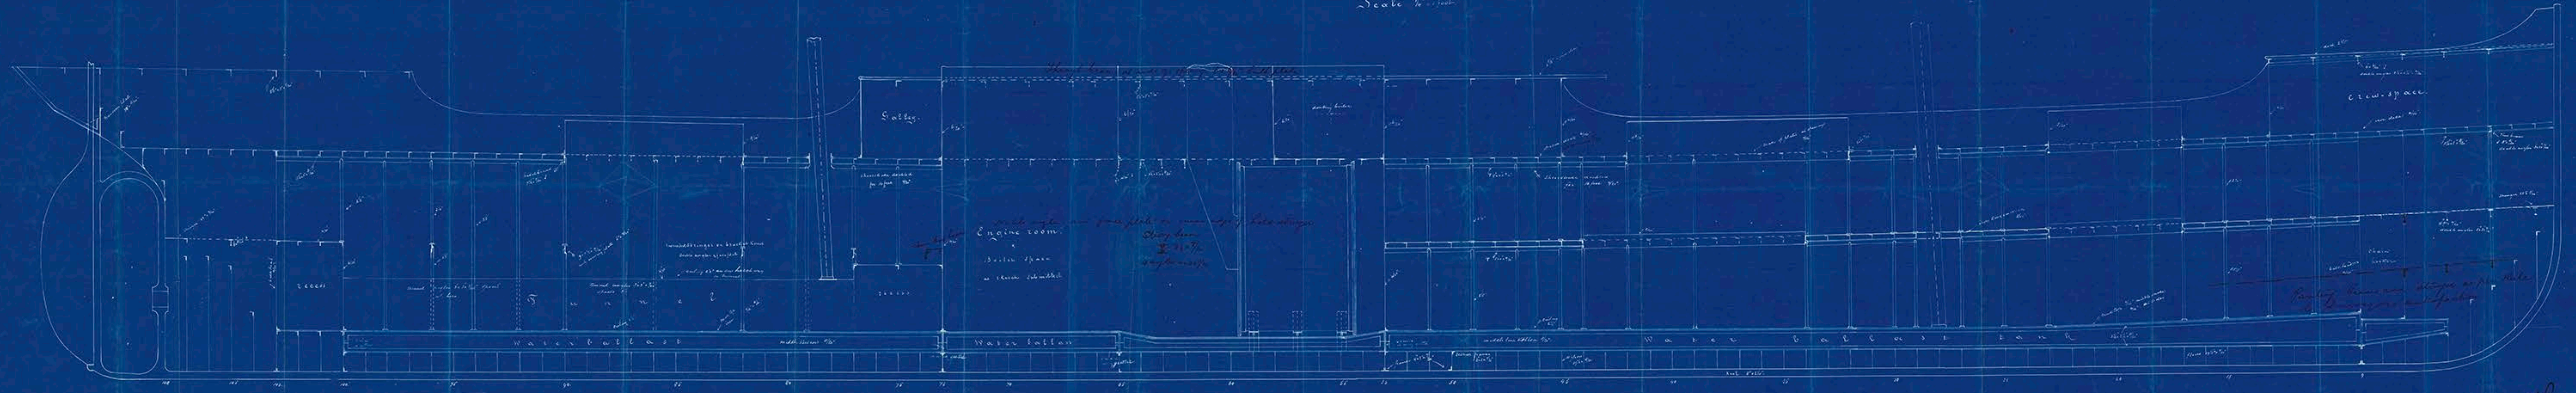

10/0.94.

Sheerplan S.S. HSM. N^o 159.

Scale 1/4" = 1 foot



10/0.94.
10/0.94.
10/0.94.

Profilo
"Zanckroom"
Ans 1623.



© 2018

Lloyd's Register
Foundation