
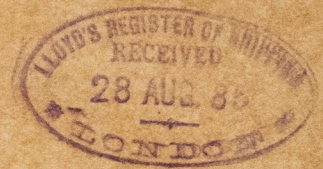


S.S. PELHAM. Ave 91.

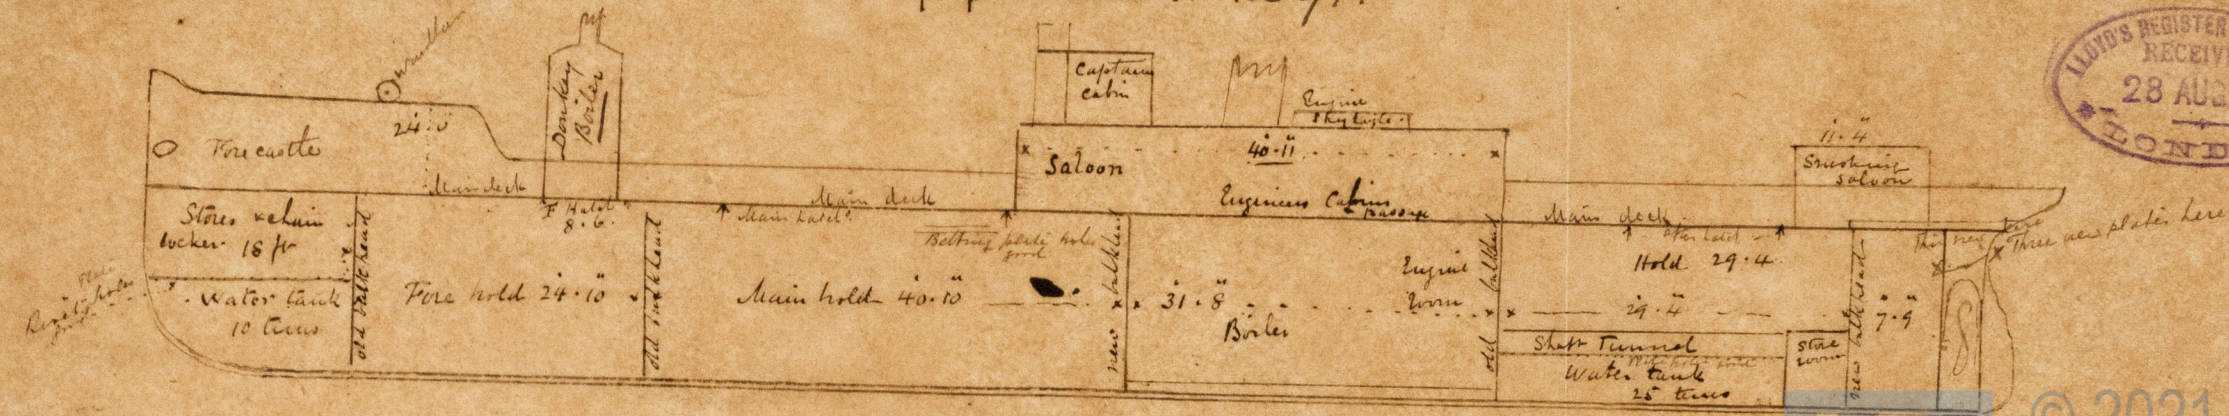

Scale $\frac{1}{16}$. S.S. "Pelham" altered from sailing ship into Steamer 1885
requires 90 tons ballast besides her present water tanks

© 2021
Lloyd's Register
Foundation