

4.12.79
678780

"British Queen" Belfast Report No. 2733.
& Iron

— Profile of Steel Steamers —


— No 138 —

— 410 x 39 x 29 (hold) —

— Scale $\frac{1}{16}$ " = 1 ft —

26 Nov

1879

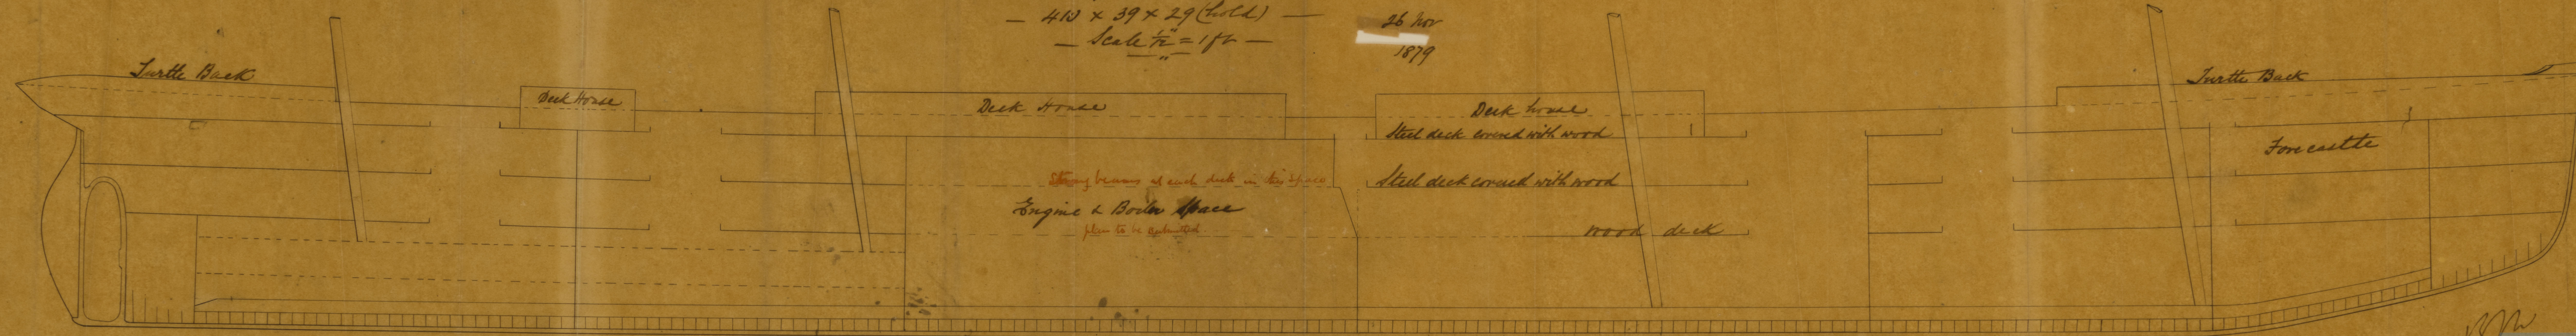

Jan 27/11/79

18 Nov
3/12/79

© 2021

Lloyd's Register
Foundation