


1.6.80

Longitudinal Section of No. 3 S.S. - "Ethelbert"
 To Class 100 A.1 at Lloyd's. -
 Scale 1/8" = one foot. -
 Belfast Report No 2743

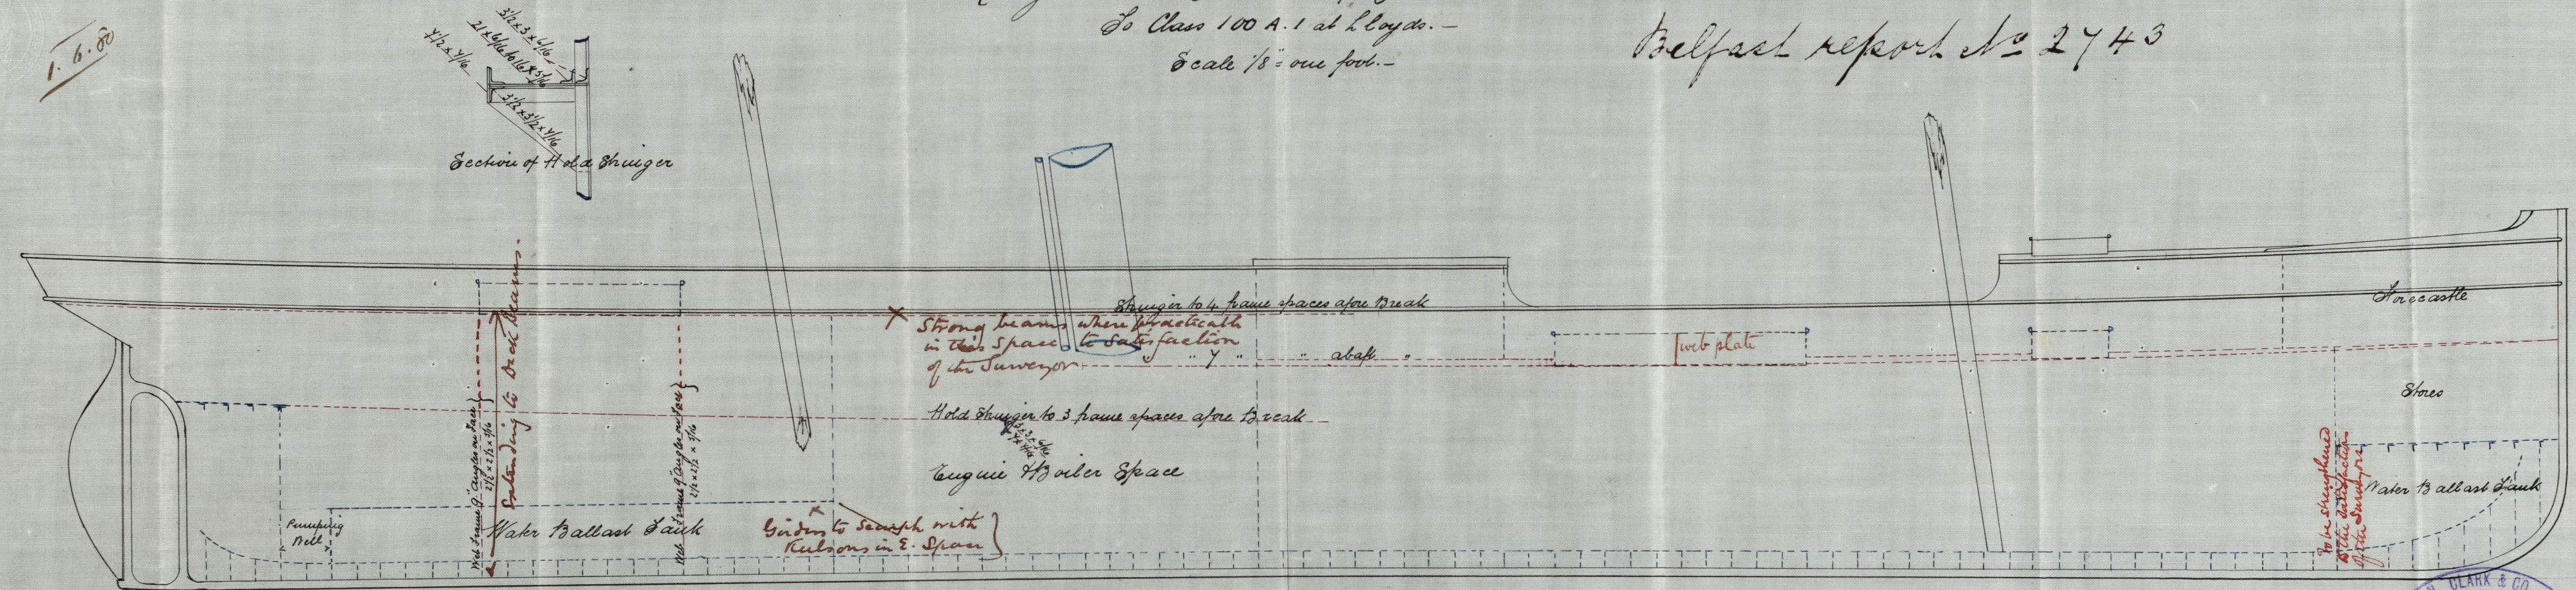

J.W.S. 29/5/80



18th
 1/6/80