

30.12.80

Midship Section of No. 8 S.S. -

"S.S. Ethelwolf"

To class 100 A. 1 at Lloyds.

Helfast report of 2785

Scale 1/2 inch = one foot.

Proportions 6.89 Breadths

11.8 Depths to main Dk.

Generals 1/2 Breadth 12.25


1/2 Girth 23.9

Depth 14.25



$$= 9369.3 \text{ Equipment } 70.$$

Equipment	
2 Bower anchors & Stock	10 cwt.
1 " " " "	8 1/2 "
1 Sheave " " "	3 3/4 "
1 Kedge " " "	1 1/4 "
1 " " " "	3/4 "
195 Fathoms 1 1/2 "	Stud Chain Cable.
60 " 1 1/2 "	Sheave chain.
75 " 8 "	Towline
90 " 6 "	Warp.

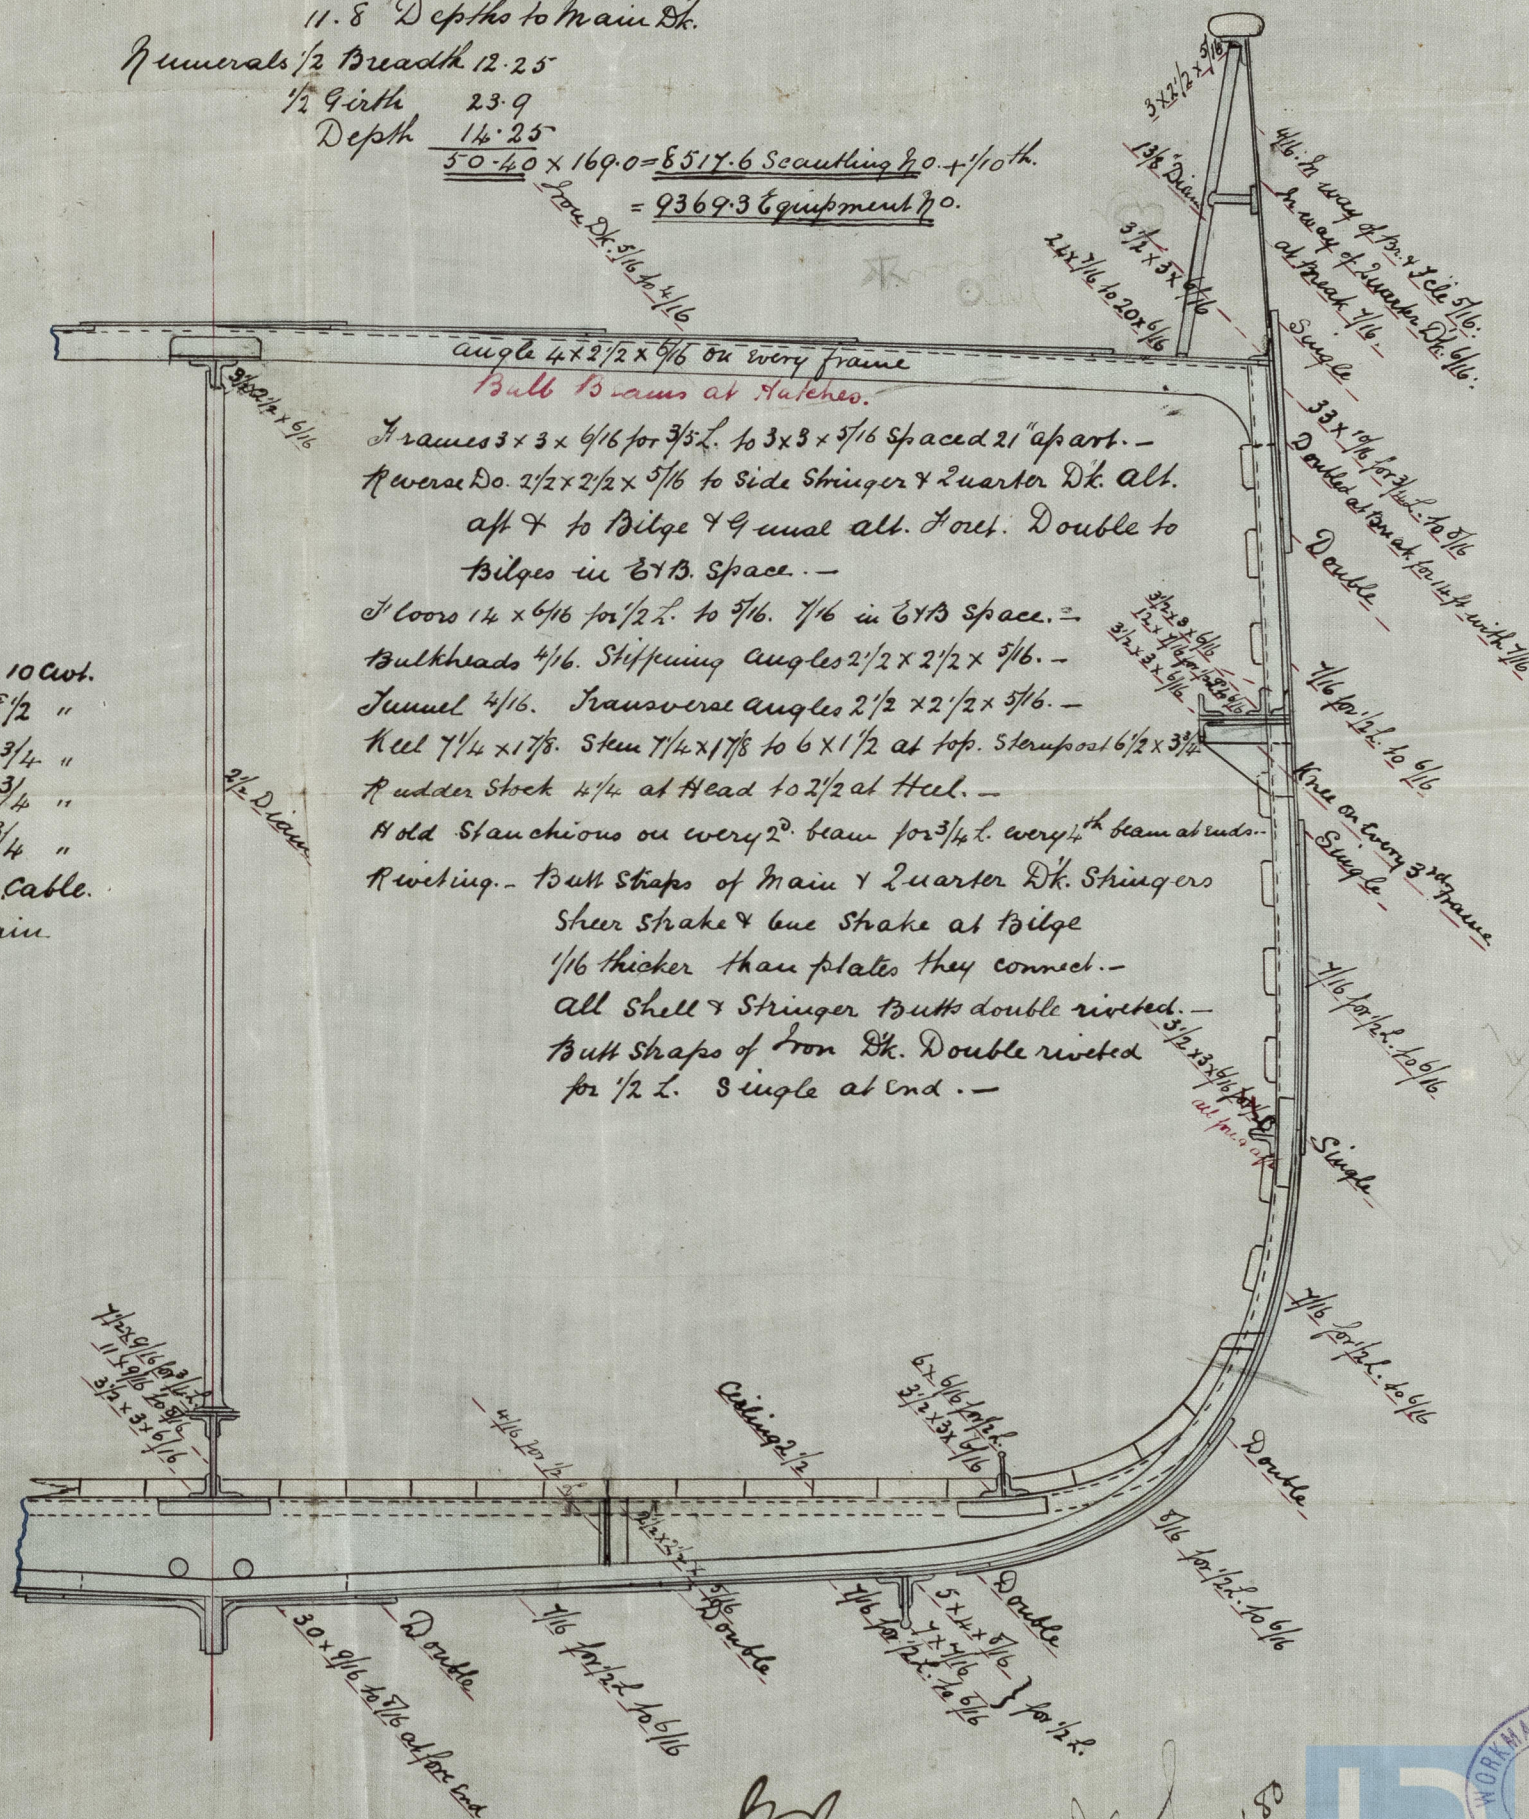

M.D. 31/12/80

29/12/80

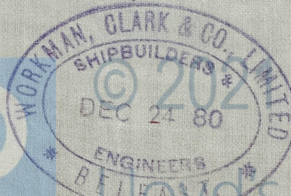

Lloyds Register Foundation