


Proposed Compensation for Cutting lower dia. Stringer No 7 S.S. -
Scale $\frac{1}{4}$ inch = one foot.

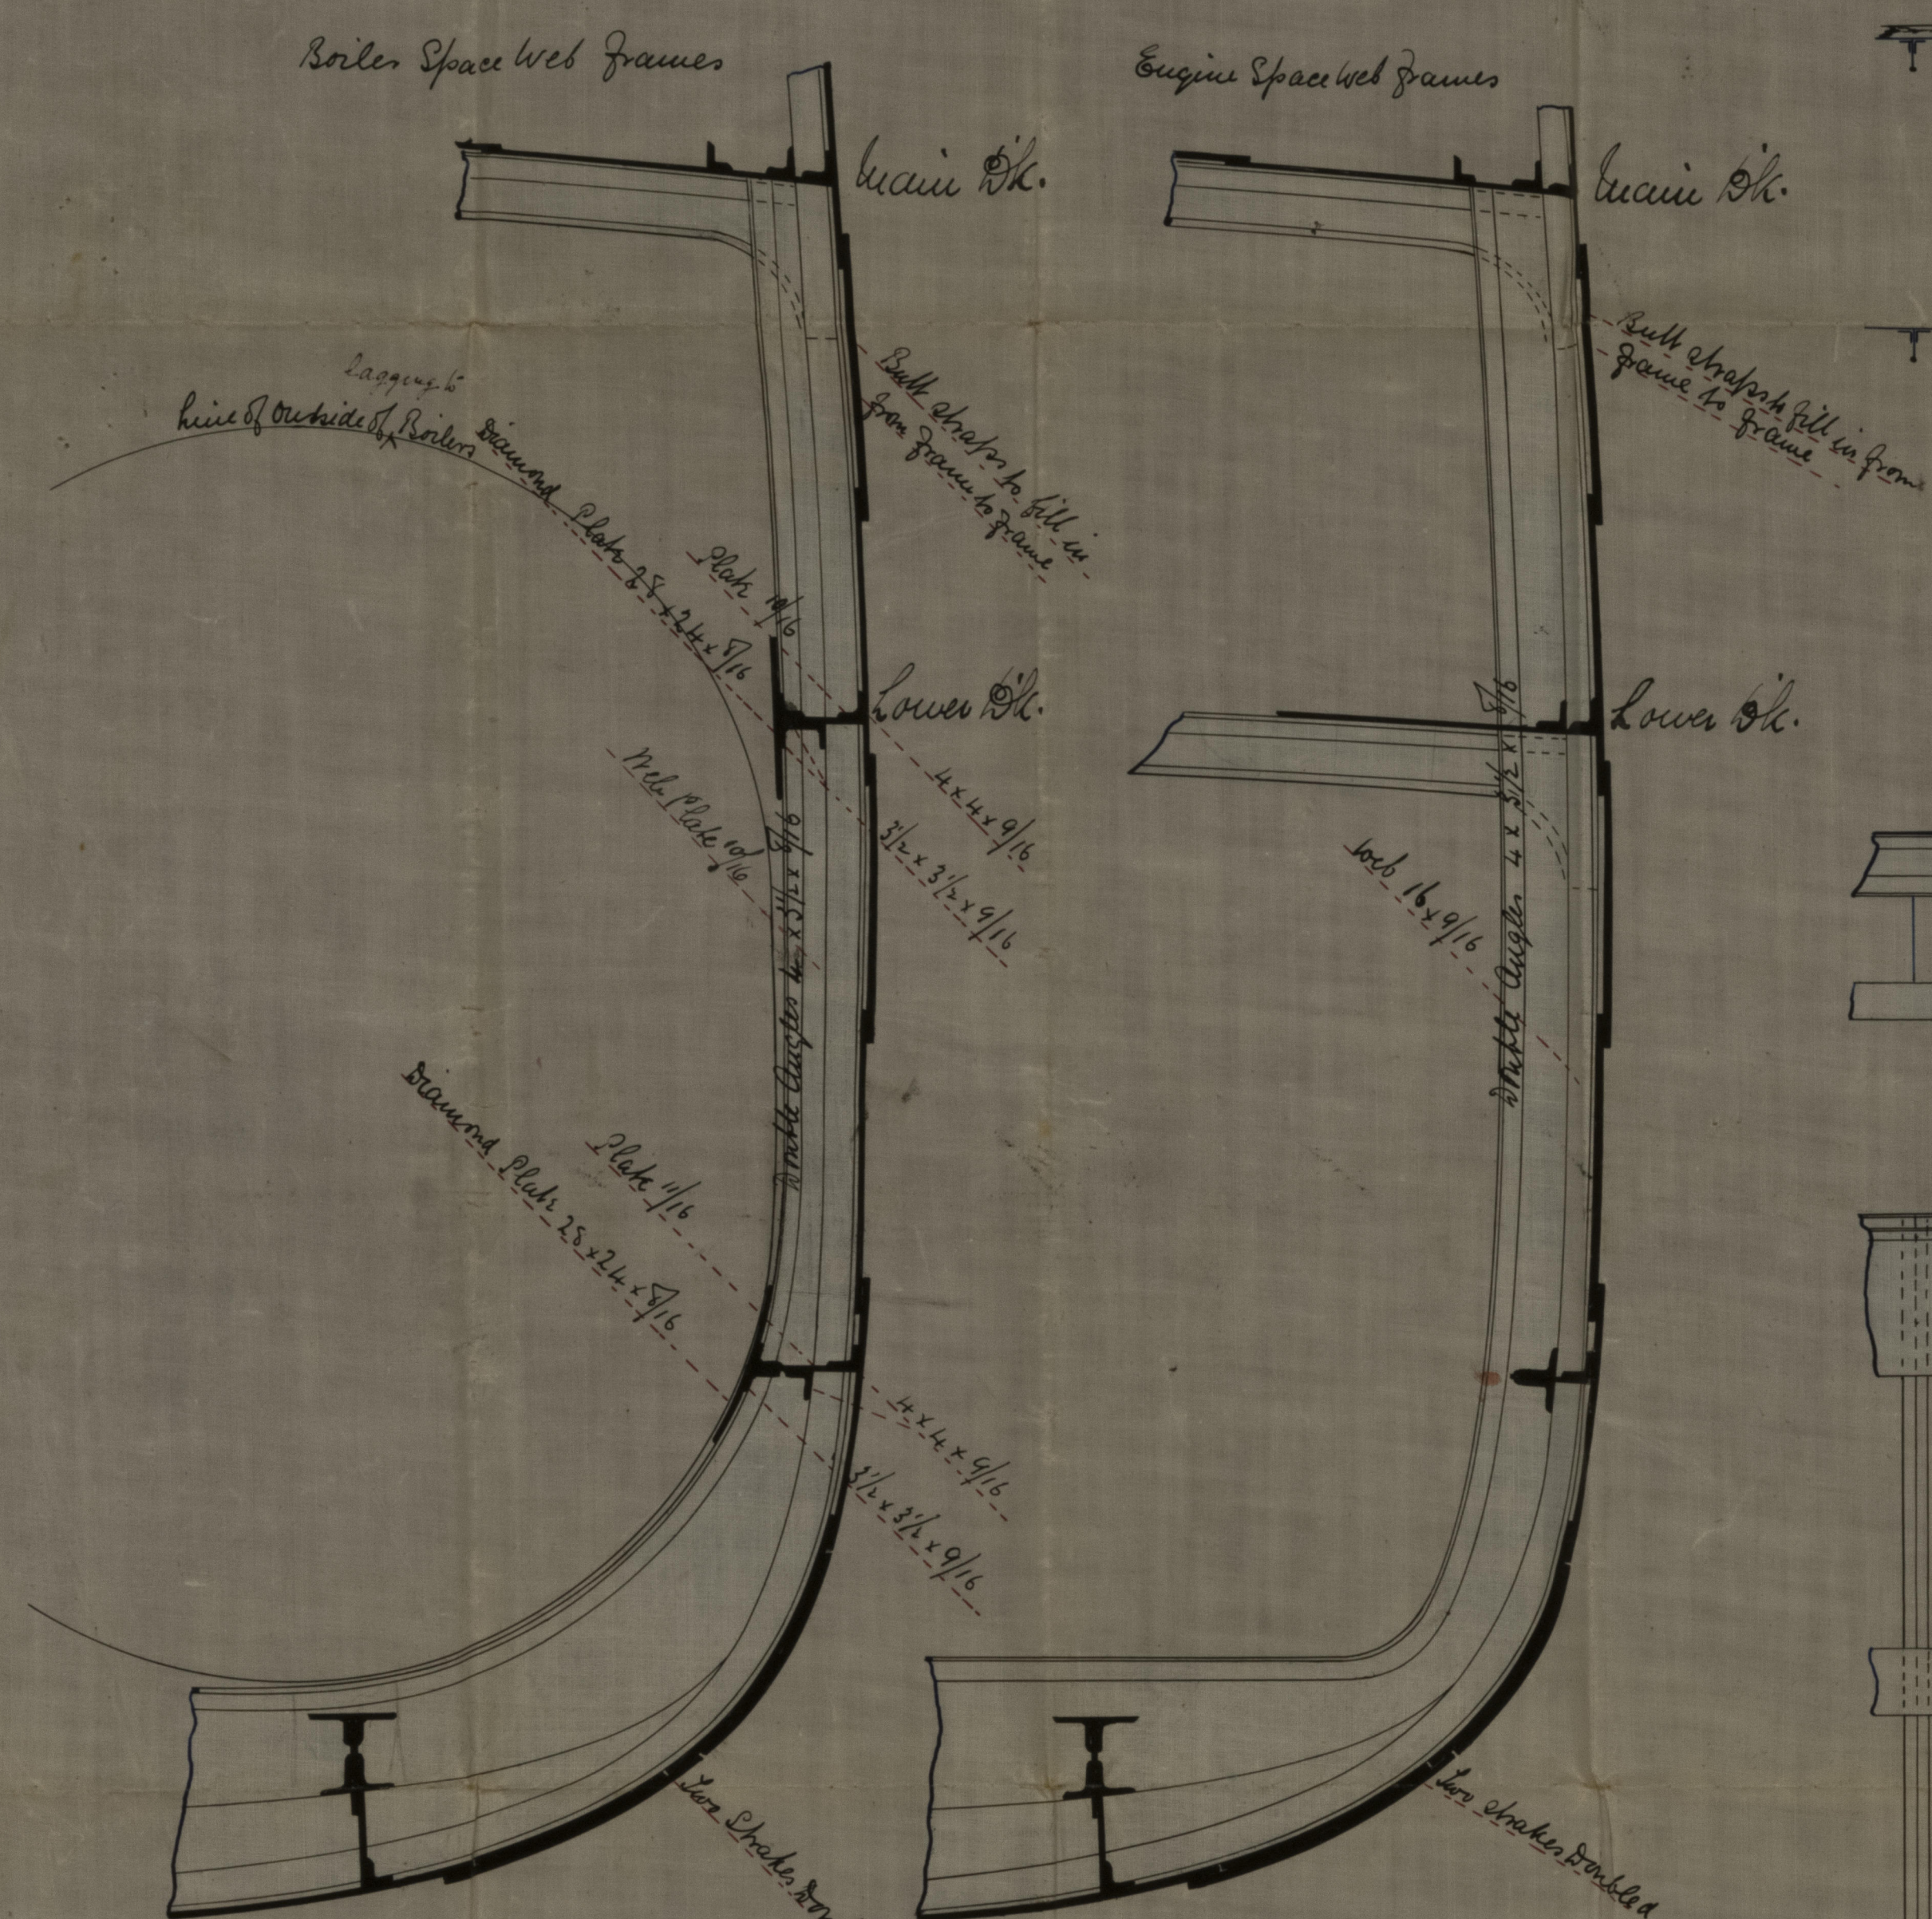

Scale $\frac{1}{2}$ inch = one foot

Note: All Shell Bullets from Belt to Gunole Filler rivets in Boiler Space -
All Reverse Frames to Upper Dk. in E & B. Space -