RECEIVED 8th MAY 82.

Midship Section of No. 7 S. S. —

To Class 100 A 3 Dk'd. — "City of Cambridge"

Scale 1/2" = one foot. —

Belfast Report No. 2913

J.D. 19.12.82

Dimensions		
Length as per rules	398.5	
Half moulded Breadth	20.87	93.7
Girth of Half midship section	47.7	
Depth from top of Keel to U. Deck	32.16	
" " " " Floors " "	29.97	
" " " " - L. "	14.83	
" " " - Keel - M. "	24.5	

Excessive Proportions	
Depths in Length to Upper Dk.	12.39
" " " " Main "	16.26
Breadths in Length	9.54
Scantling Numeral	37351
Equipment "	42816

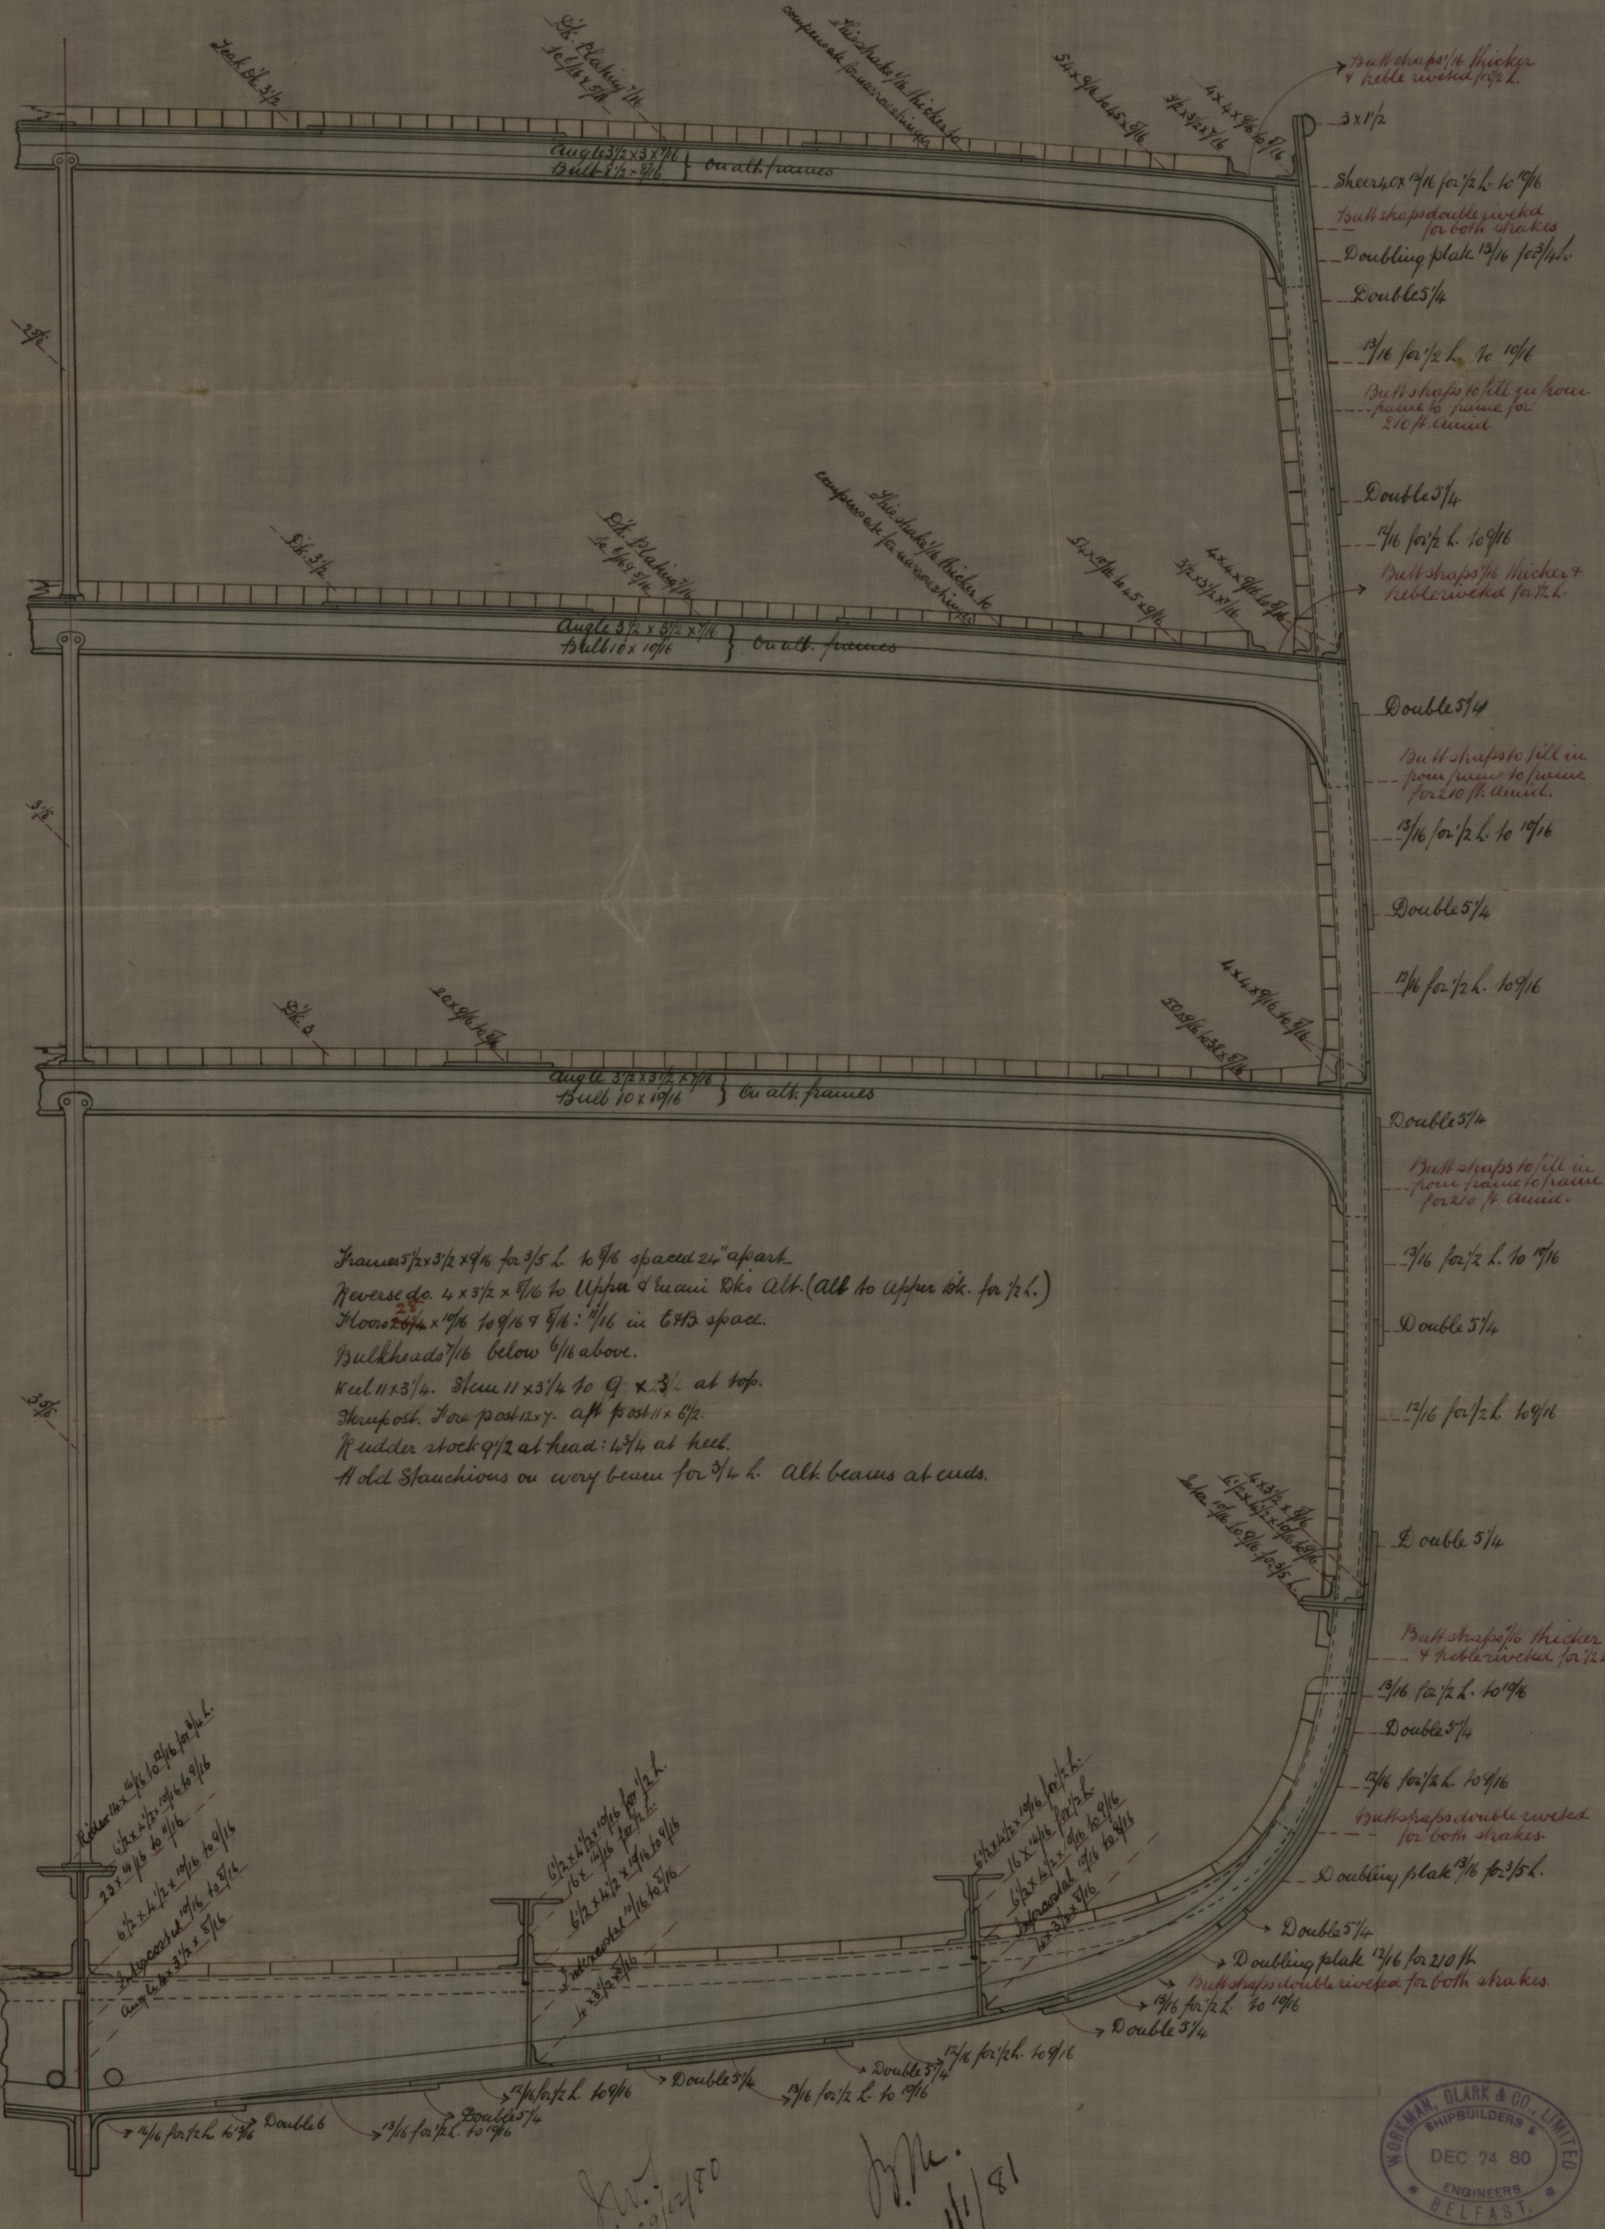

WORKMAN, CLARK & CO., LIMITED
SHIPBUILDERS
DEC 24 80
ENGINEERS
BELFAST.

29/12/80

1/1/81

© 2021 Lloyd's Register Foundation