

Lloyd's Register of British and Foreign Shipping.

Received in the London Office, RECEIVED 5th. MAR. 83.

P.

No. ✓

REPORT ON SHIP FORGINGS.

Sir,

I beg leave to report that the undermentioned Forgings, manufactured by *The Portland Forge Co* of *Helmarrack* for the Vessel No. *16*, being built by *Messrs Workman Clark & Co* of *Belfast* have been inspected by me in course of being forged and smithed, and found to be, so far as can be seen, *sound and satisfactory*.

Mark on Forging.

Lloyd's

No. ✓

G. N

The Secretary,
London.

I am, Sir,


Your Obedient Servant,

George Newcomb

Glasgow

	STERN FRAMES.	RUDDER FRAMES.	STEMS.
Material*	Scrap iron	/	Scrap iron
How made	Forged		Forged
Dimensions	$7\frac{1}{2} \times 5$ & 8×5		
Progress on Inspection .	Forged & smithed		Forged & smithed
Dates when Inspected .	$17\frac{1}{2}, 29/11/82 - 7. 14. 20 \& 29/12/82$		$18. 4/2/83.$

SKETCHES OF FRAMES SHEWING POSITION AND DESCRIPTION OF WELDS.

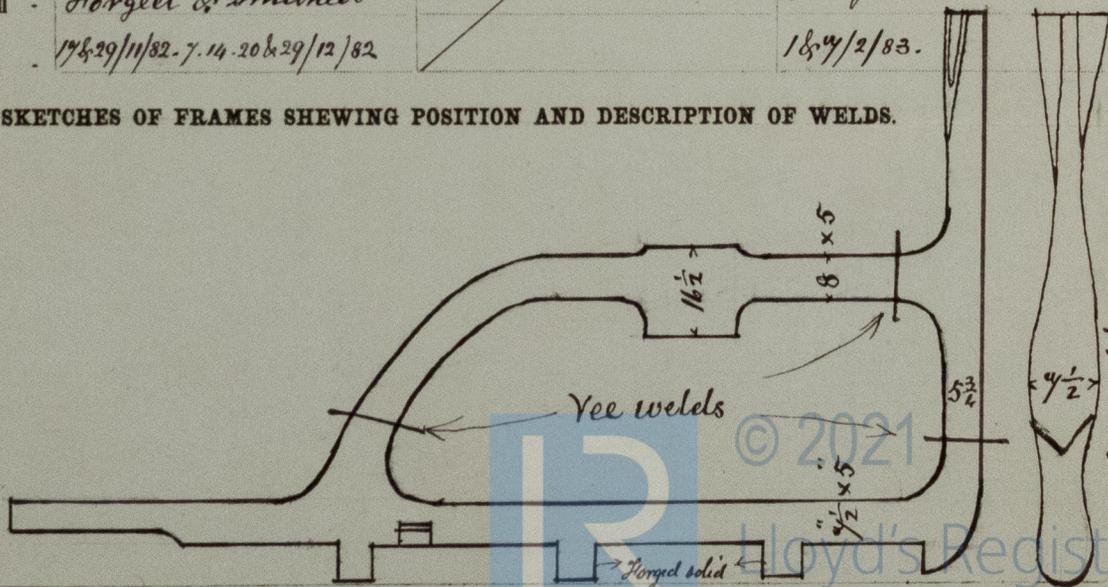

* If of iron, state whether scrap or puddled iron.

S. S. Maraglio
Belfast Report
W. 2909
Feb. 26. 7. 83

D. G.
5/3/83