

6.4.82

Nº 155 2.5.82

500 x 42.6" x 25 (Holds)

TO CLASS 100 A1 AT LLOYDS

SCALE  $\frac{1}{2}'' = \text{ONE FOOT}$

W. J. Pirrie  
Belfast Report No. 2942

21.25 + 27.37 + 43.25 = 91.87 FRAME NUMBER


91.87 x 298.16 = 27391 PLATING

27391+1826 = 29218 EQUIPMENT

7 BREADTHS 10.89 DEPTHS

31 March

1882 W. S. H.

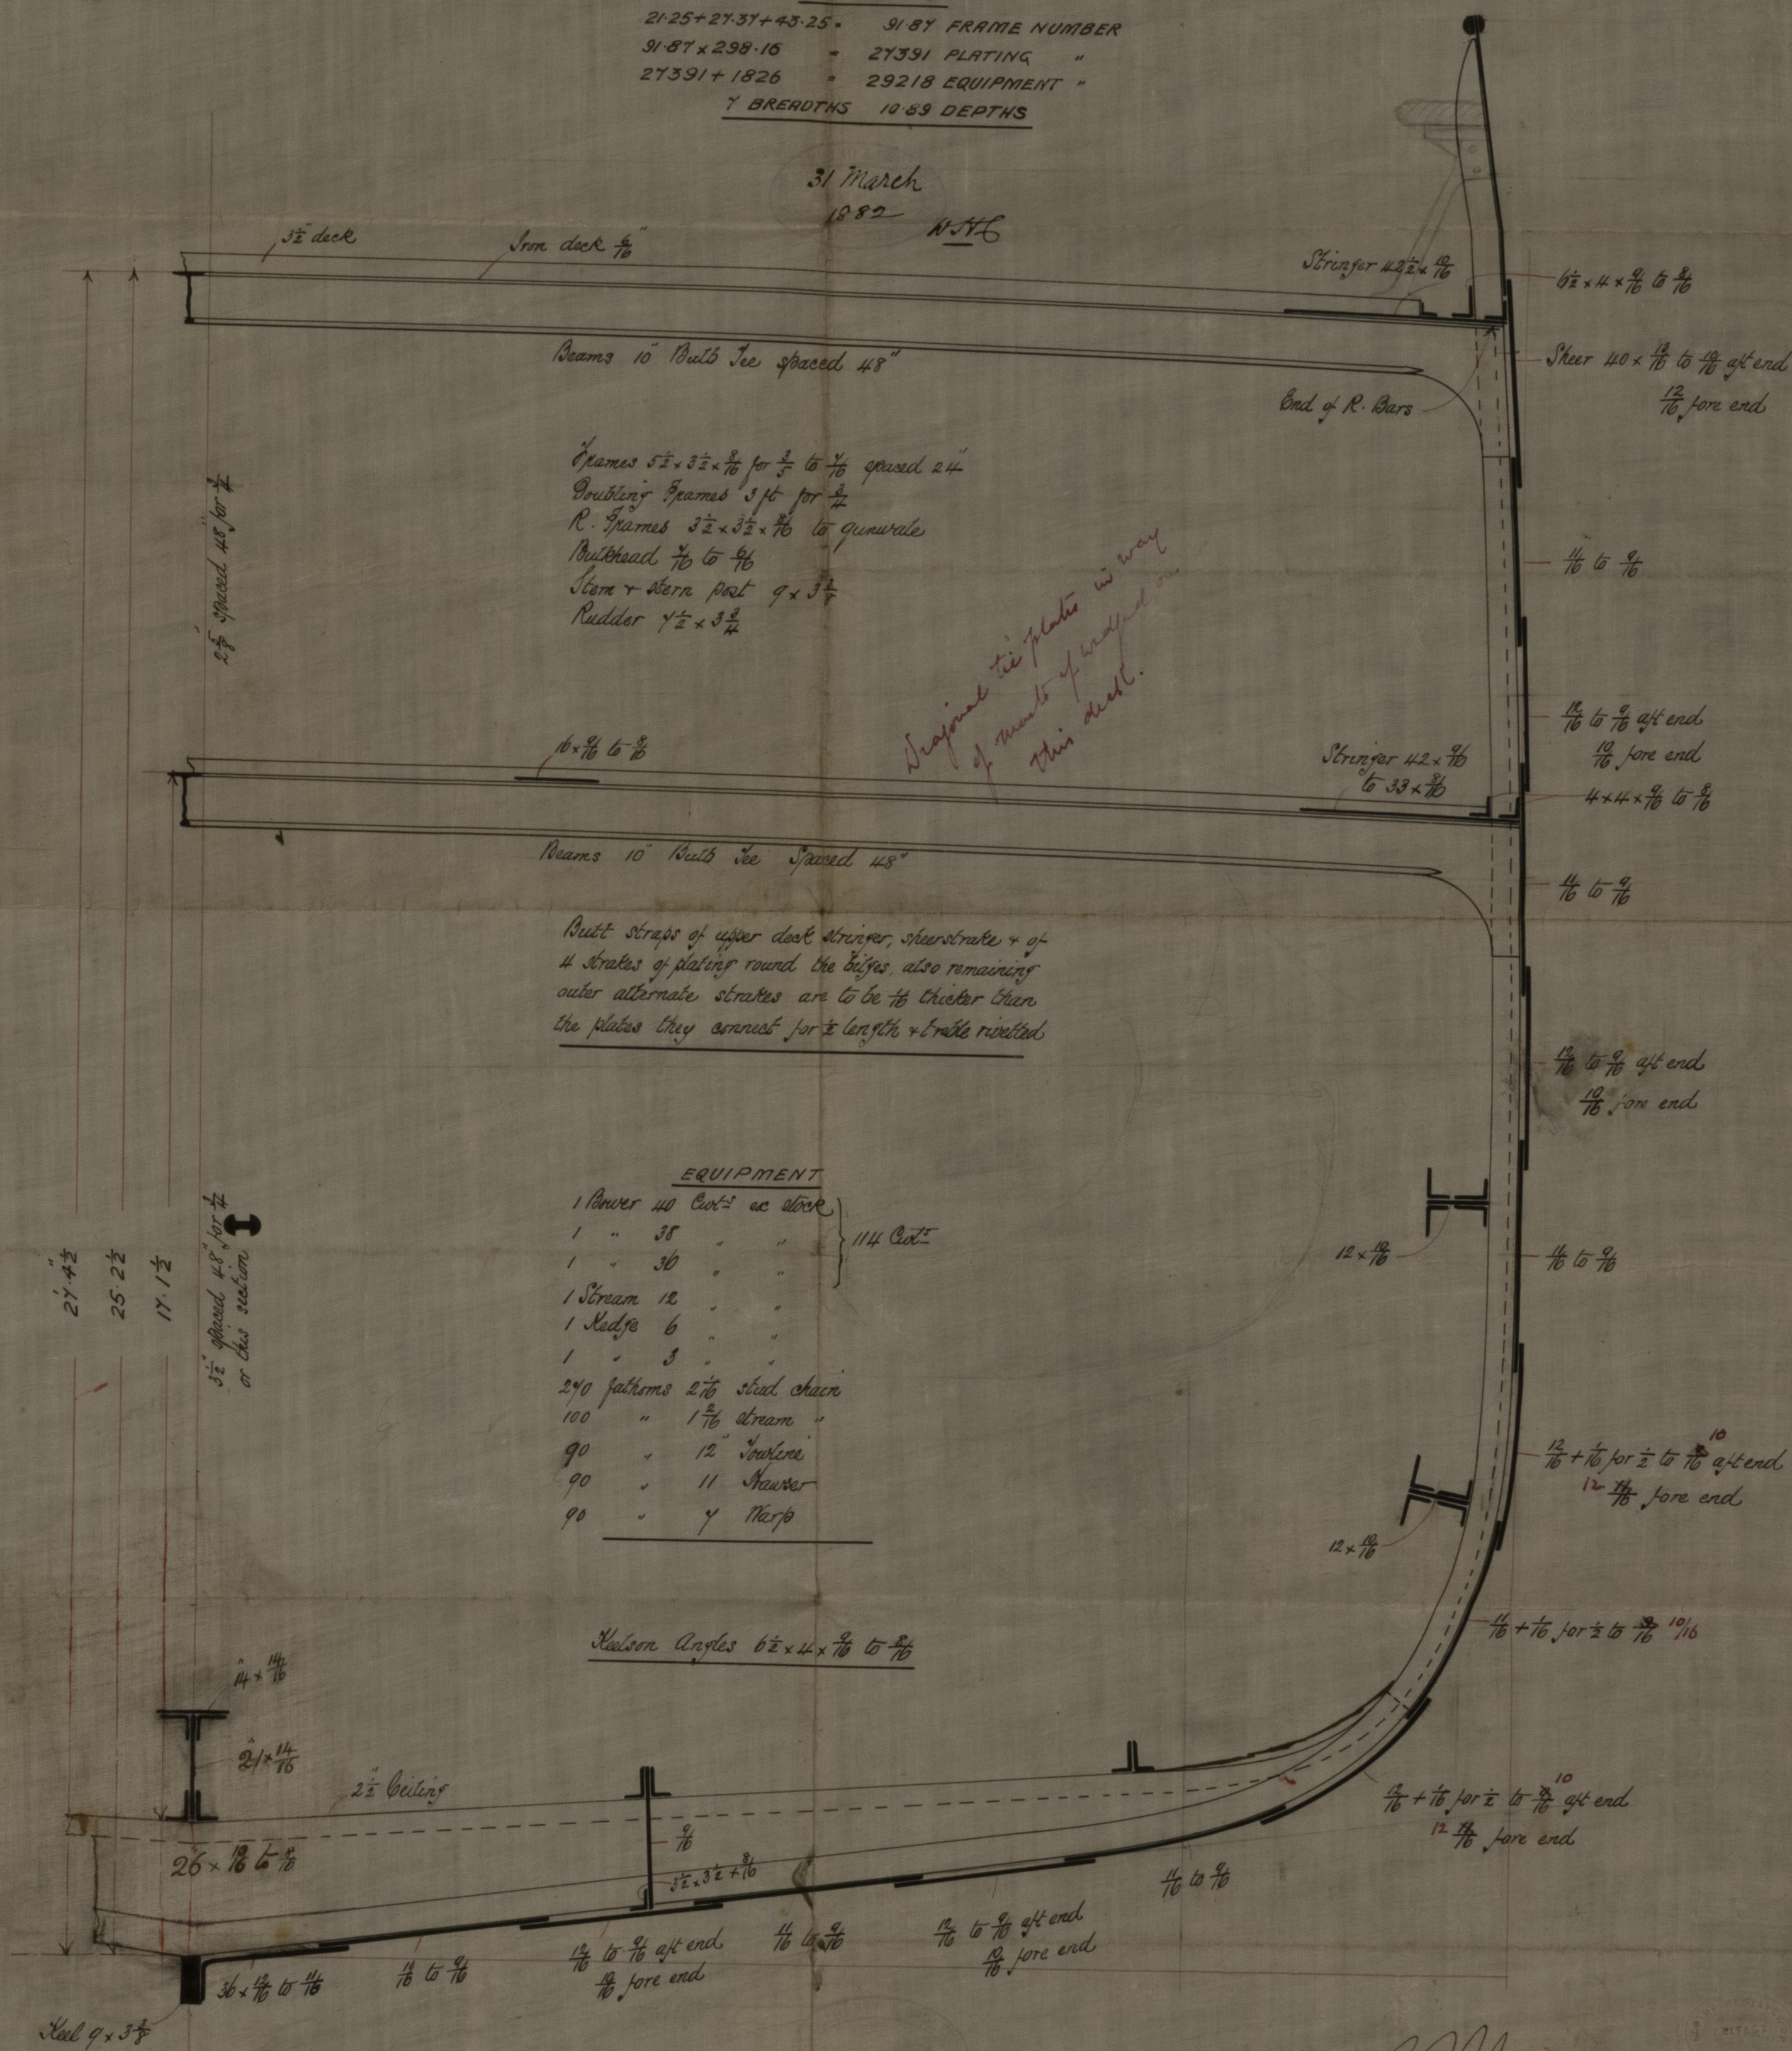

Sealed in plate in way  
of mouth of bagged  
this seal.

## EQUIPMENT

1	Powder	40	Cot <sup>2</sup>	ac	stock	} 114 Cot <sup>2</sup>
1	"	38	"	"	"	
1	"	36	"	"	"	
1	"	34	"	"	"	
1	Stream	12	"	"	"	
1	Redge	6	"	"	"	
1	"	3	"	"	"	
270	fathoms	2 <sup>7</sup> / <sub>16</sub>	"	Lead	chain	
100	"	1 <sup>7</sup> / <sub>16</sub>	"	Stream	"	
90	"	12	"	Twine		
90	"	11	"	Twine		
90	"	4	"	Warp		

Keelson Angles  $6\frac{1}{2} \times 4 \times \frac{9}{16}$  to  $\frac{8}{16}$

18. M  
074/82

3.4.82



