



TRACING N^o 898.

BOILER

SHIP N^o 18.

T. T. Sargent Revier

N^o 183.

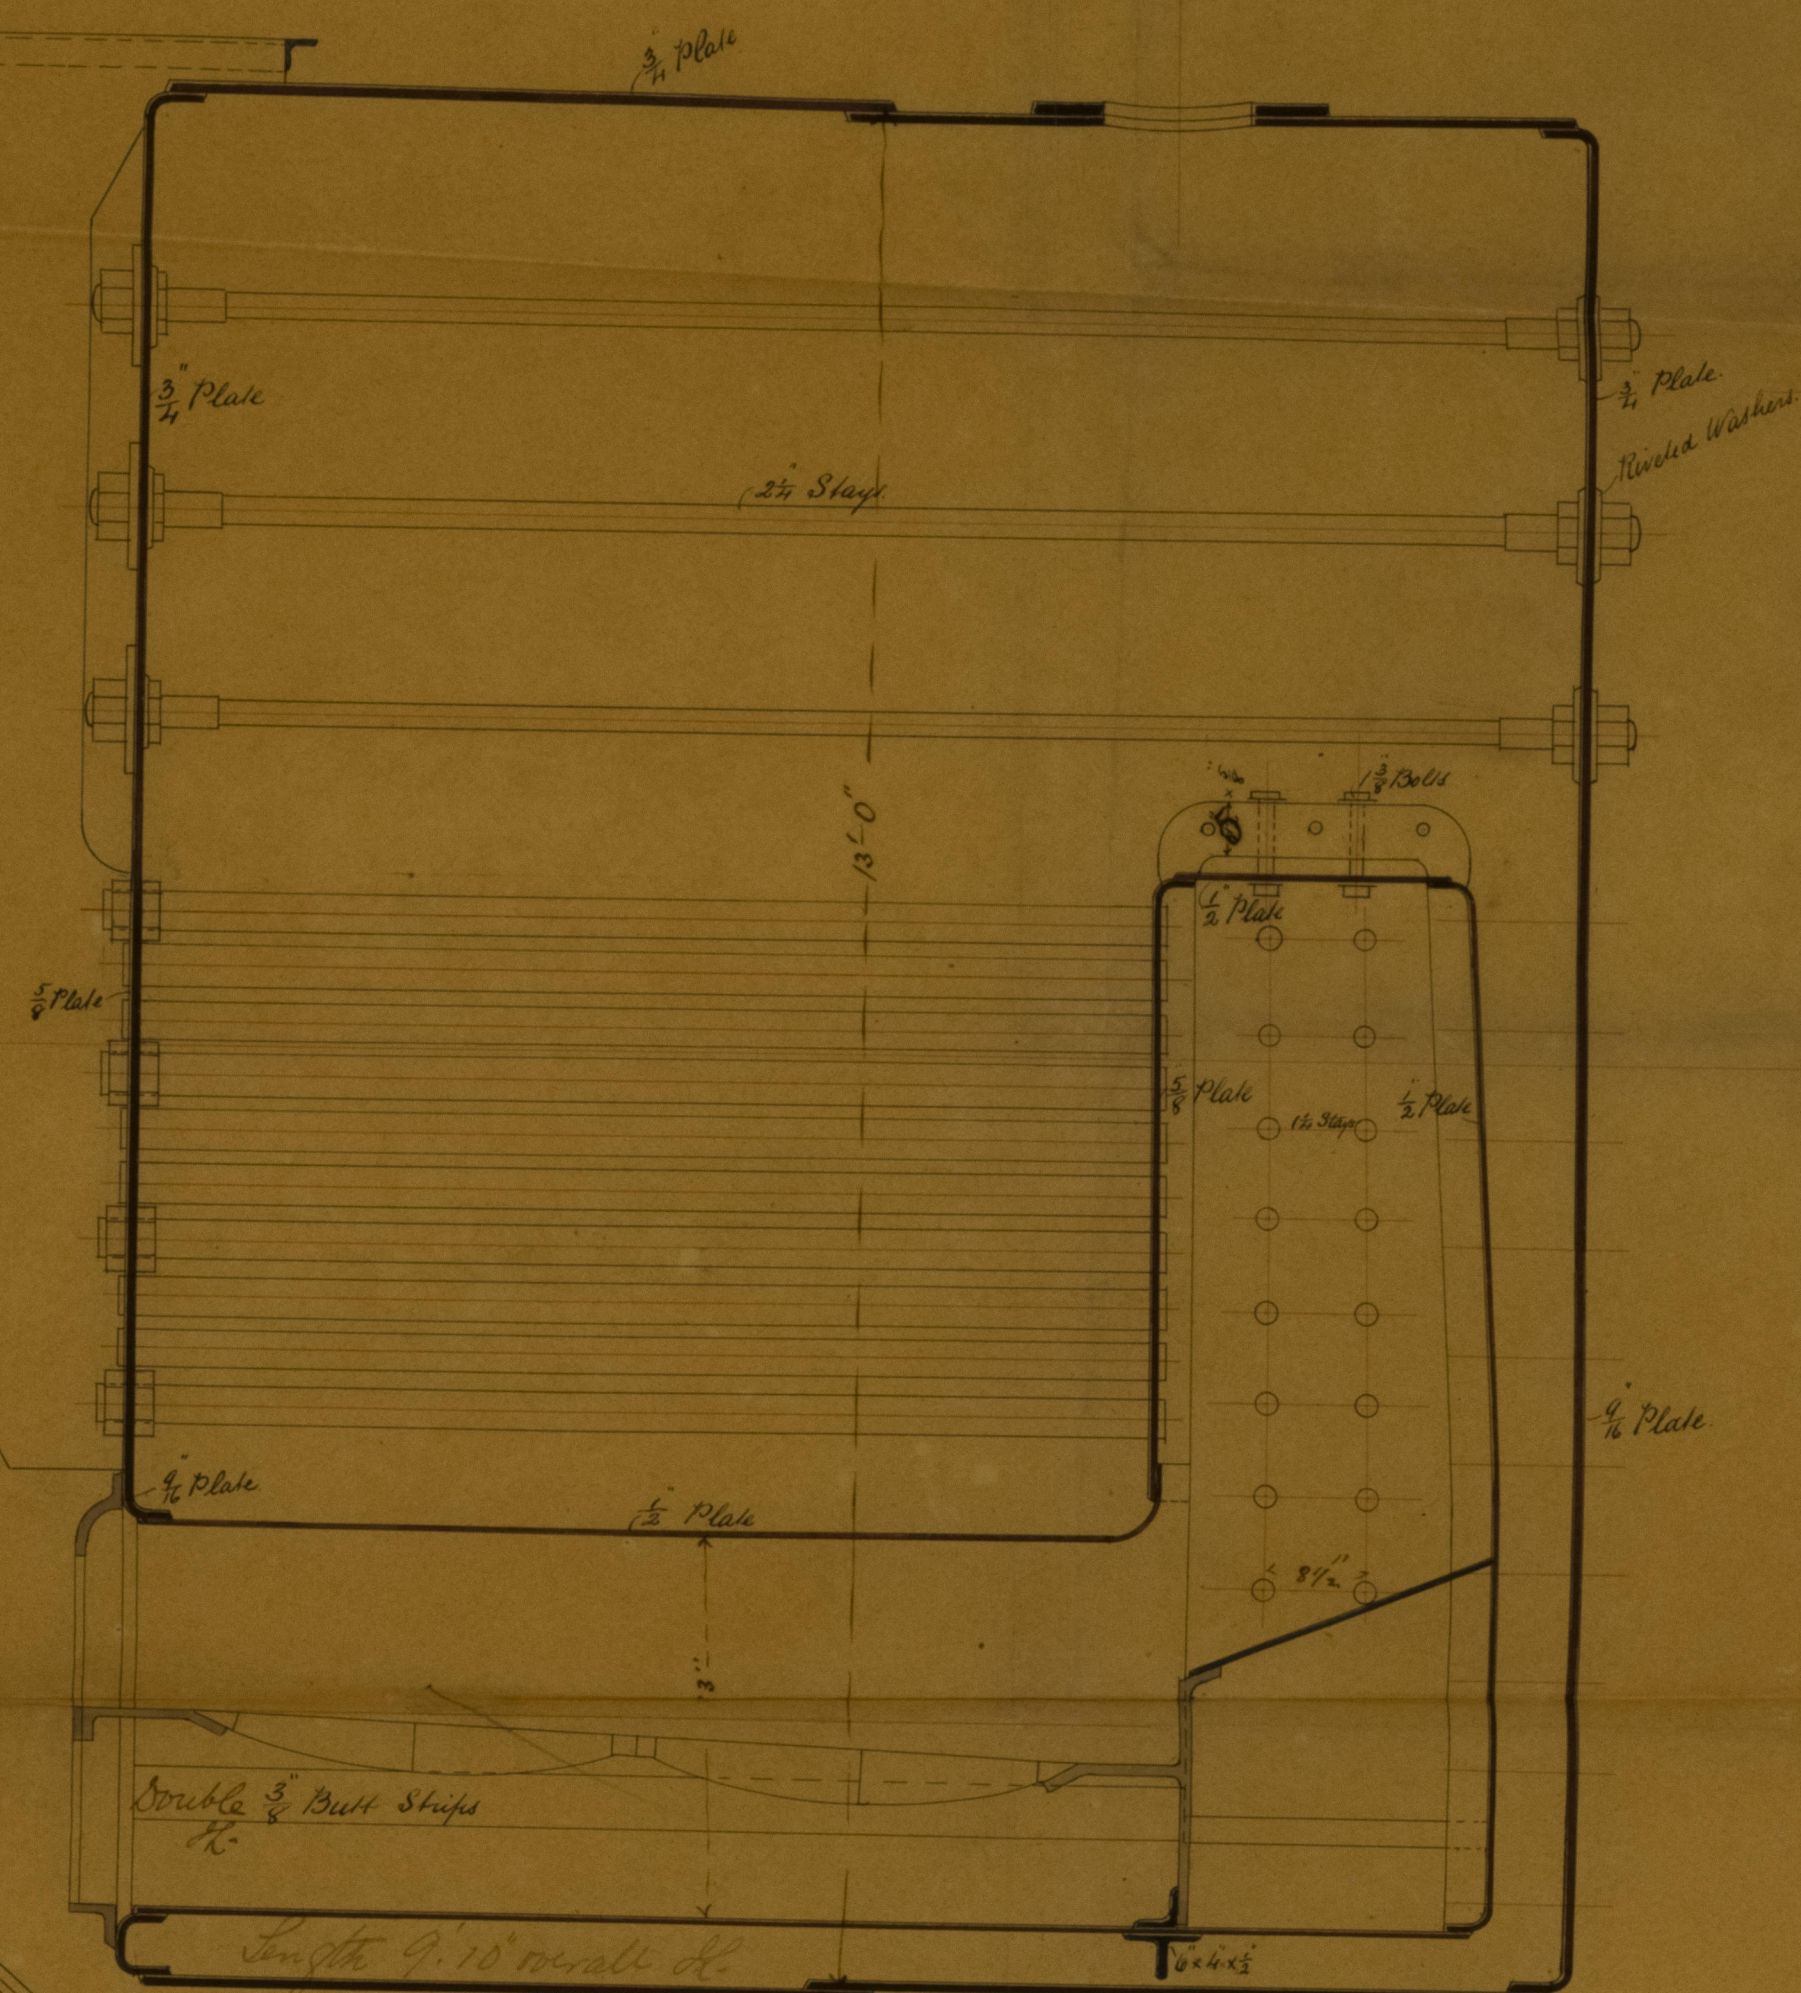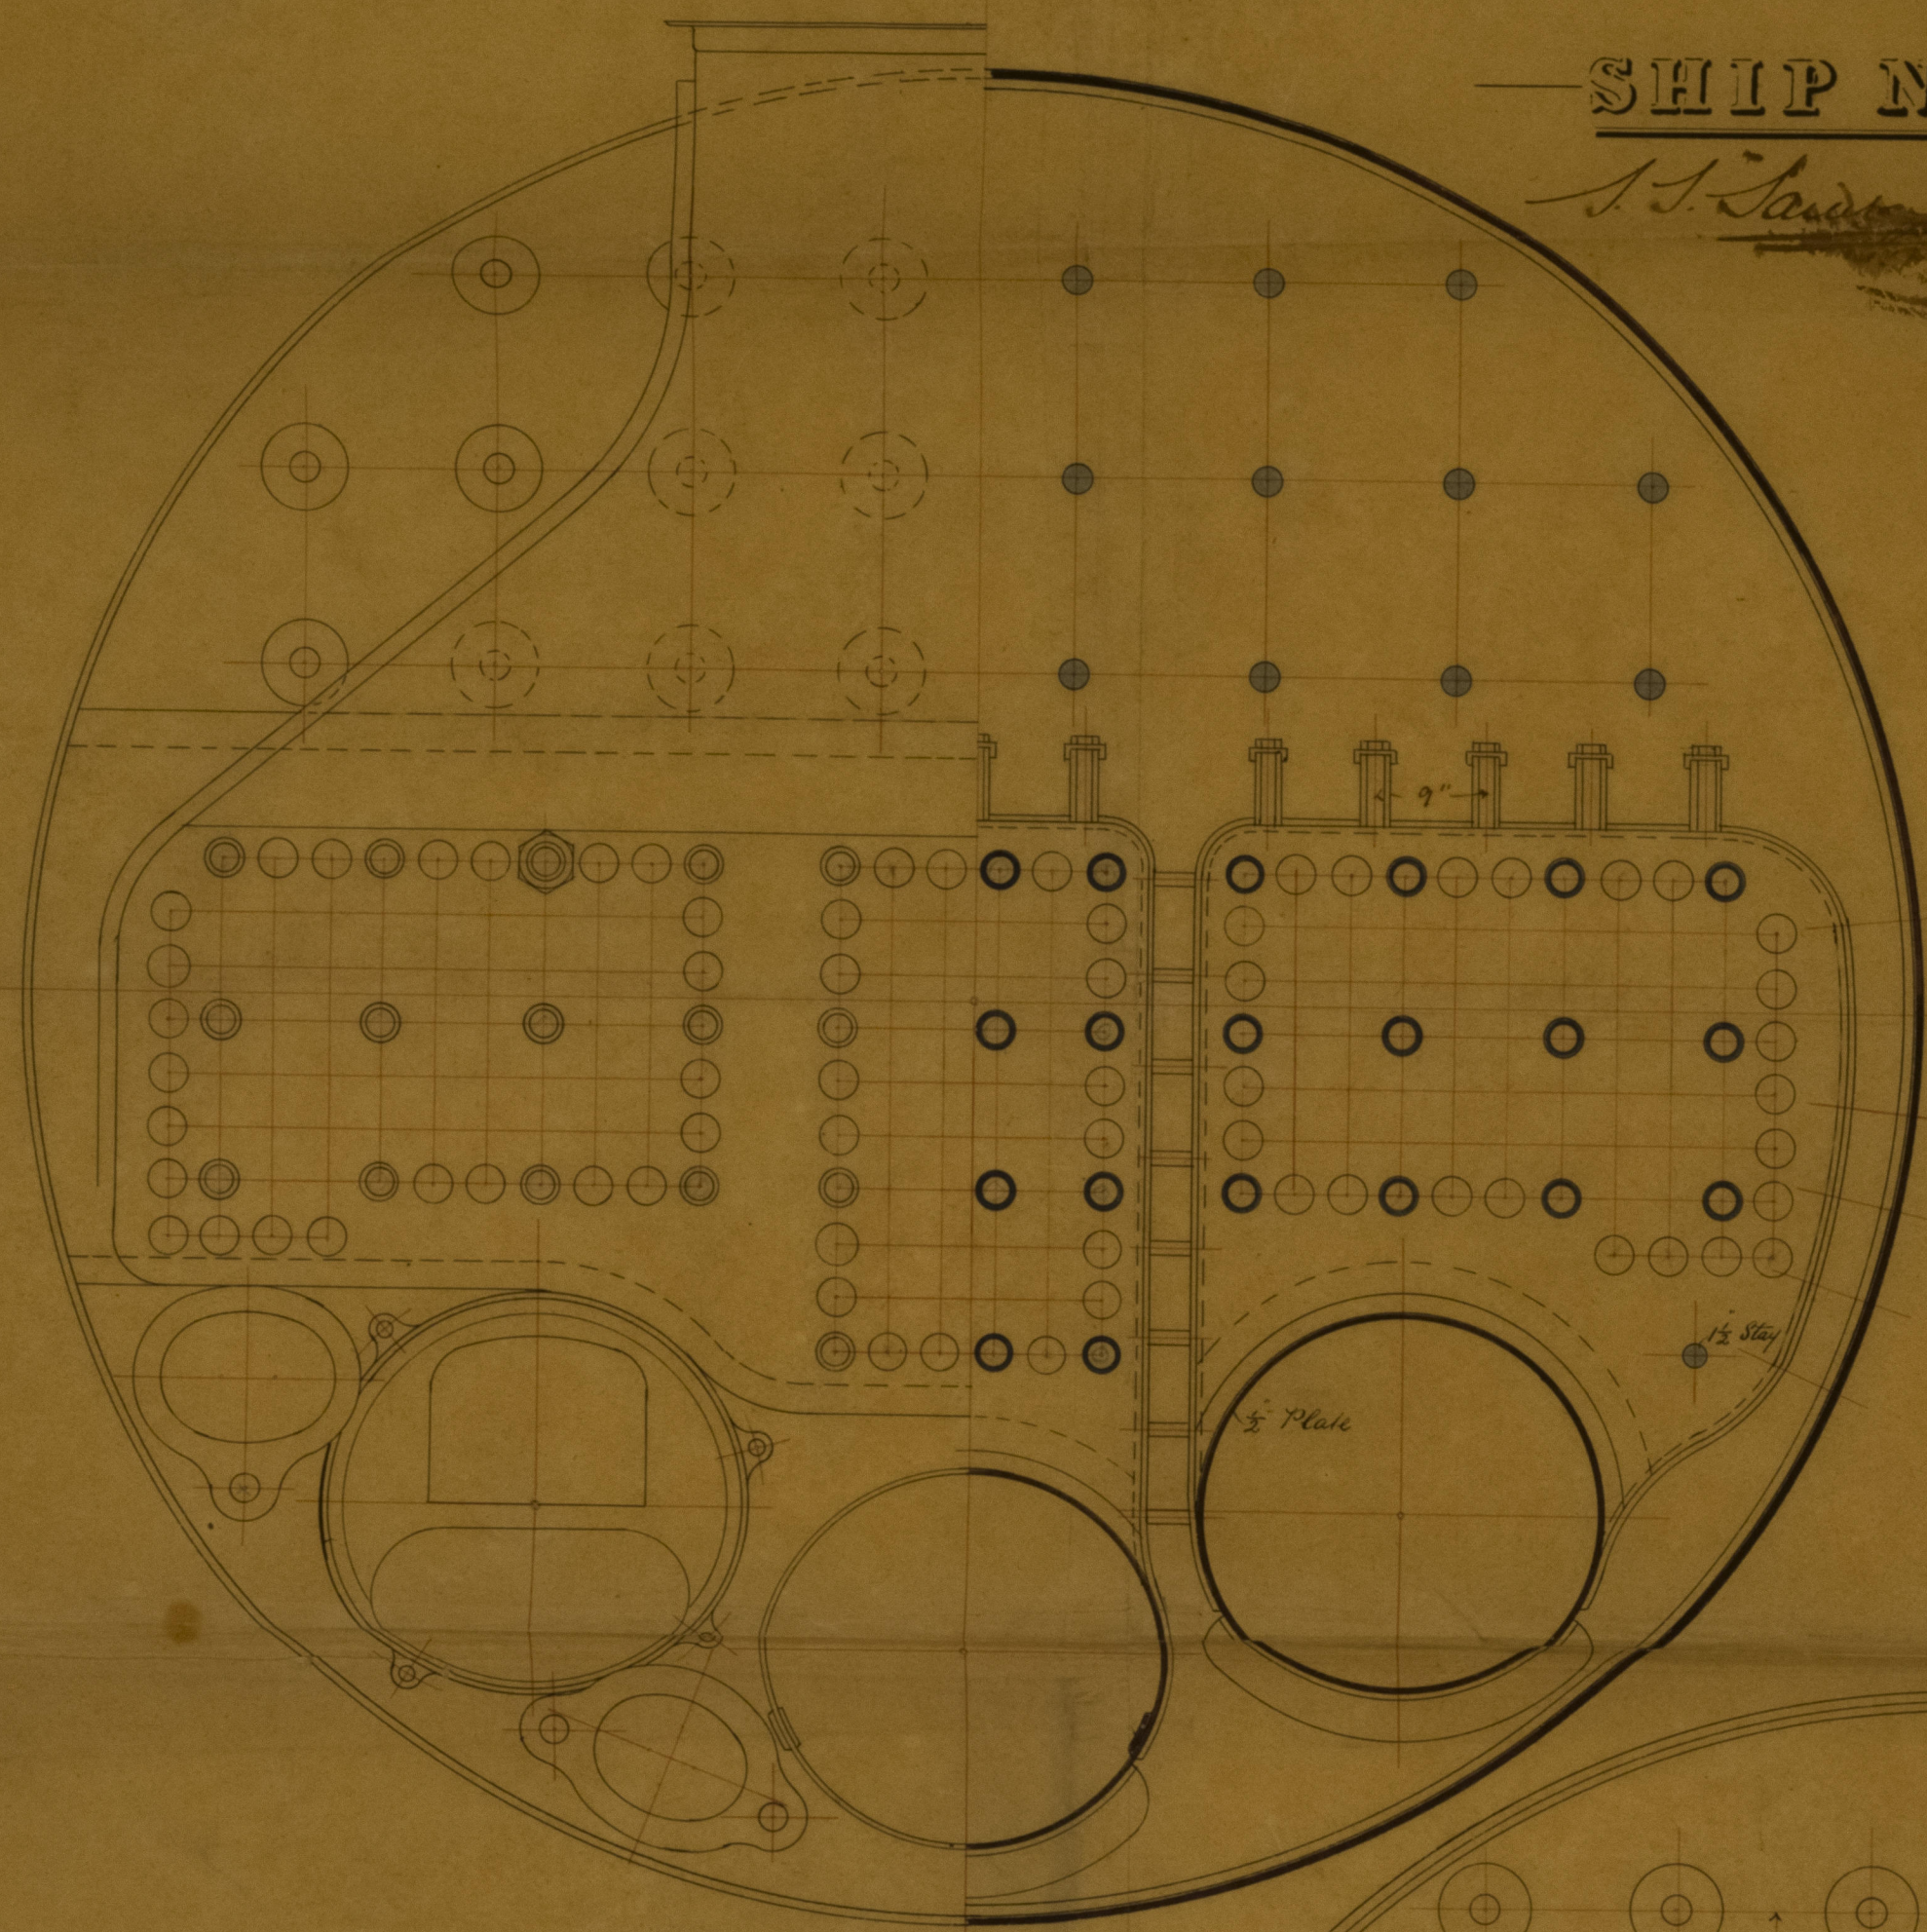

13'-0" diameter
Working Pressure 85 lbs
Boiler all Steel
In h 46°

Stays $\frac{1}{2}$ dia^r at Bottom of Thread, fixed with nut?

Double Straps
Shell Butt
Scale: $1\frac{1}{2}$ inches = 1 Foot
Strap $\frac{9}{16}$ " thick, Rivets $\frac{1}{2}$ " dia.

Ex. 1.
A. J. C.
27/11/81

SCALE $\frac{3}{4}$ INCH TO A FOOT