

Lloyd's Register of British and Foreign Shipping.

(Received in the London Office,

RECEIVED 5th MAR. '83.

P.

No.

REPORT ON SHIP FORGINGS.

Sir,

I beg leave to report that the undermentioned Forgings, manufactured by
The Portland Forge Co of *Kilmarnock*
 for the Vessel No. *17*, being built by *Messrs Workman, Clark & Co*
 of *Belfast* have been inspected by me in course
 of being forged and smithed, and found to be, so far as can be seen, *sound and*
satisfactory

Mark on Forging.

Lloyd's

No.

G. N

The Secretary,
 London.

I am, Sir,


Your Obedient Servant,

George Newcomb

Glasgow

	STERN FRAMES.	RUDDER FRAMES.	STEMS.
Material* - - - -	<i>Scrap iron</i>	/	<i>Scrap iron</i>
How made - - - -	<i>Forged</i>		<i>Forged</i>
Dimensions - - - -	<i>7 1/2 x 5 & 8 x 5</i>		
Progress on Inspection -	<i>Forged & smithed</i>		<i>Forged & smithed</i>
Dates when Inspected -	<i>11.18.23/1/83. 1.13.24/2/83. 2/3/83</i>		<i>7 & 13/2/83.</i>

SKETCHES OF FRAMES SHEWING POSITION AND DESCRIPTION OF WELDS.

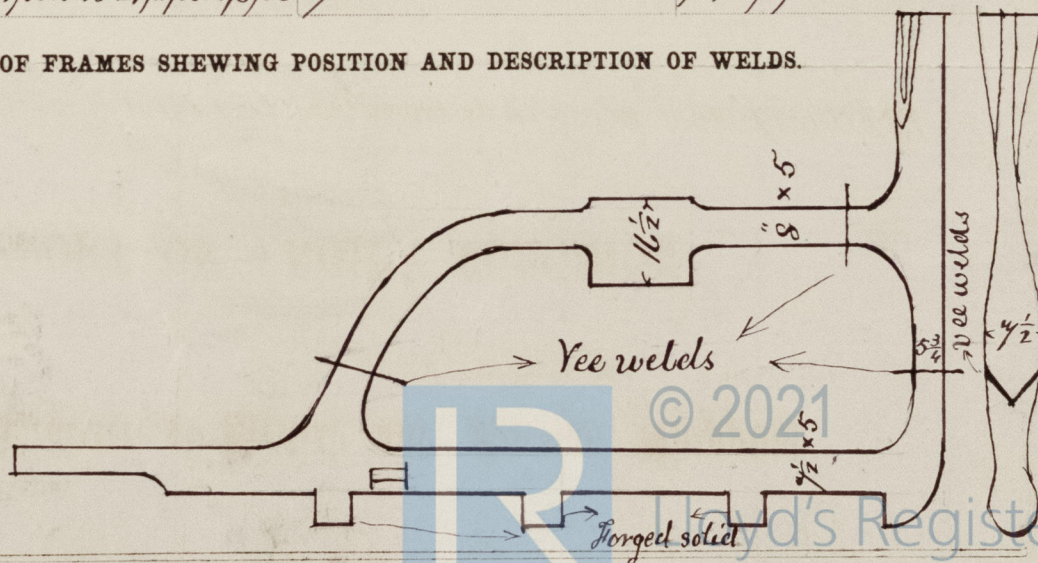

* If of iron, state whether scrap or puddled iron.

5/13/83