

MIDSHIP SECTION

Nº 157 .

IRON SAILING SHIP

$$300 \times 42.6 \times 25 \text{ (Holz)}$$

TO CLASS 100A1 AT LLOYDS

SCALE $\frac{1}{2}$ = ONE FOOT

"Lord Wolseley"
Belfast Report N^o 2984

Law. E. R. STERLING.



NUMERALS

21.26+27.37+43.25 = 91.87 FRAME NUMBER

91.67 x 298.16 = 27391 PLATING

27391 + 1826 = 29218 EQUIPMENT

7 BREATHS 10.89 DEPTHS

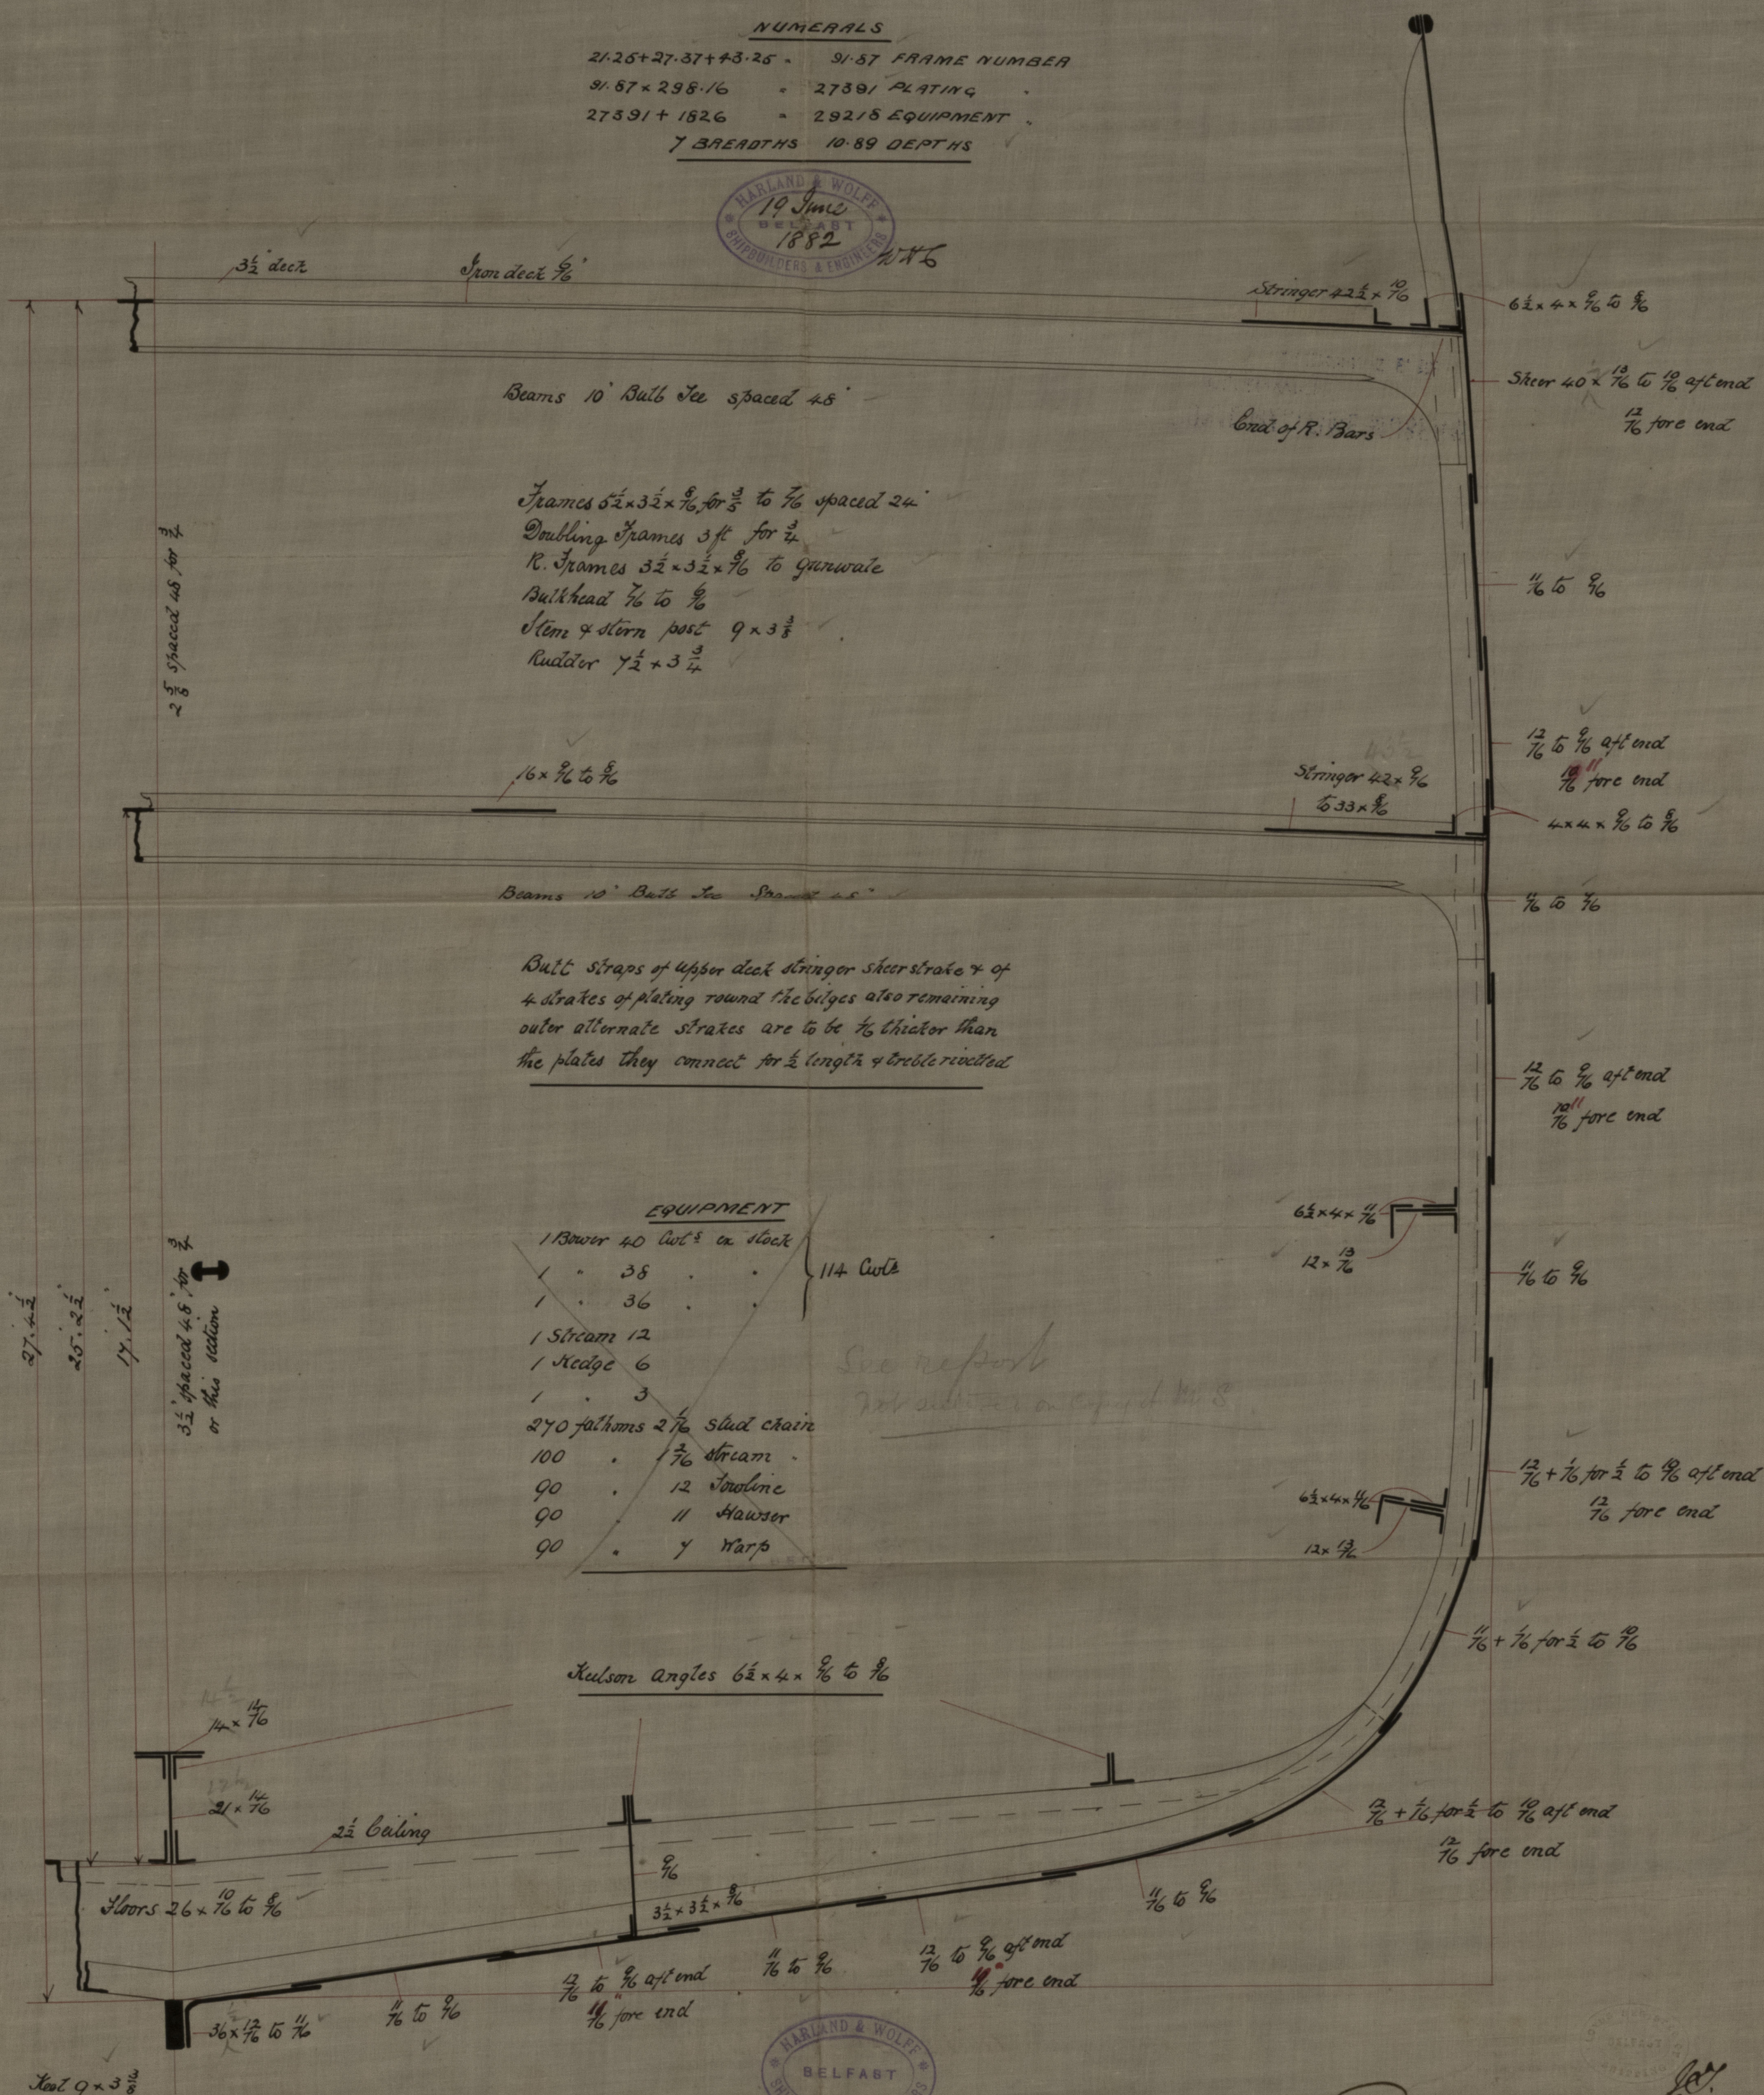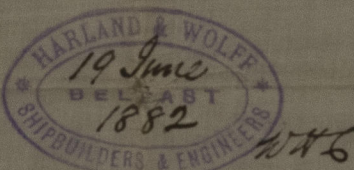

23/6/82 C.E.

20.6.82



Lloyd's Register
Foundation