


Mr. Belfant

Longitudinal Section No. 18 S.S. —  
To Class 100 A.I. —  
Scale  $\frac{1}{8}$  inch = one foot. —

"James Clark  
Belfast Report N<sup>o</sup>. 3000  
"Corra Linn  
Belfast Report N<sup>o</sup>. 3047

J. L.  
4.11.82

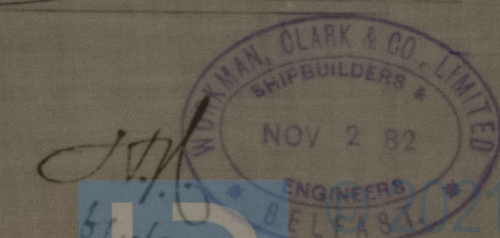

5/11/82

Lloyd's Register  
Foundation



Jane Clark  
Bel. Report No 3000

"Corra Linn" Bel Report No 3047.

"Mrs. Clark"  
Bel. Report No 3000  
"Corra Linn"  
Bel. Report No 3047

Bel. Report No 3000  
Bel. Report No 3047

Bel. Report No 3000  
Bel. Report No 3047